


DUNHAM SURVEYING, S. C.
SURVEYING & SUBDIVIDING
DELAVAN, WISCONSIN 53115

RICKORDS

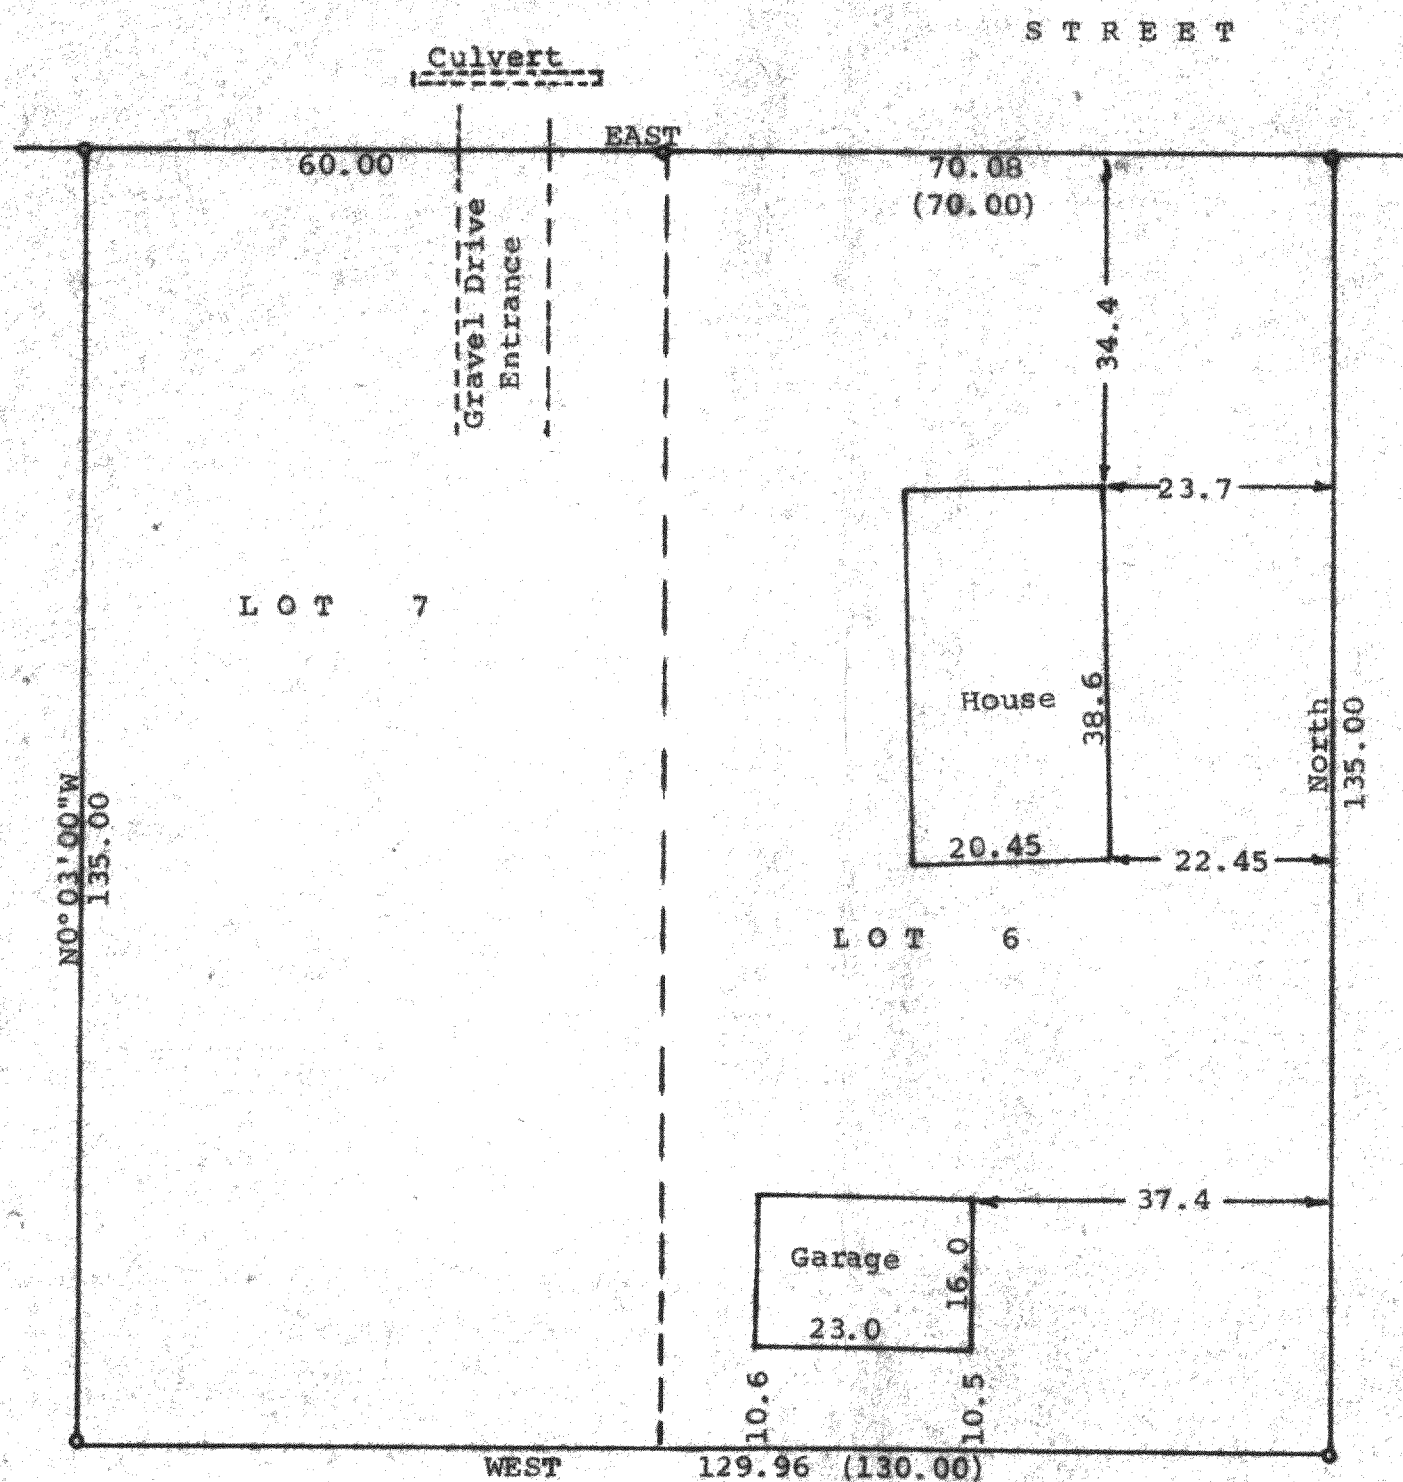

Scale - 1" = 20'
 • = 1" Iron Pipe Found
 (0.00) = recorded distance
 Survey ordered by: The Rauland Agency
 607 East Walworth Avenue
 Delavan, WI 53115
 Bearings referenced to the recorded bearing
 of East along the south line of Rickords
 Street

STATE OF WISCONSIN) SS
 COUNTY OF WALWORTH)

I, George T. Dunham, Surveyor, certify that I have surveyed the property described as follows:

Lots 6 and 7 in Block 6 in the Plat of Delmar, being a subdivision of part of Government Lot 3, part of the SW $\frac{1}{4}$ of the SW $\frac{1}{4}$, all the SE $\frac{1}{4}$ of the SW $\frac{1}{4}$ and part of the NE $\frac{1}{4}$ of the SW $\frac{1}{4}$ of Section 27, T 2 N, R 16 E, Walworth County, Wisconsin,

and that the above map is a true representation thereof and shows the size and location of the property, its exterior boundaries, the location of all visible structures and dimensions of all principal buildings thereon, boundary fences, apparent easements, roadways and visible encroachments, if any, and that I have surveyed the property hereon described according to the official records, to the best of my knowledge and belief.

August 22, 1983

George T. Dunham
 George T. Dunham, Surveyor

