



GEORGE T. DUNHAM
SURVEYING & SUBDIVIDING
DELAVER, WISCONSIN

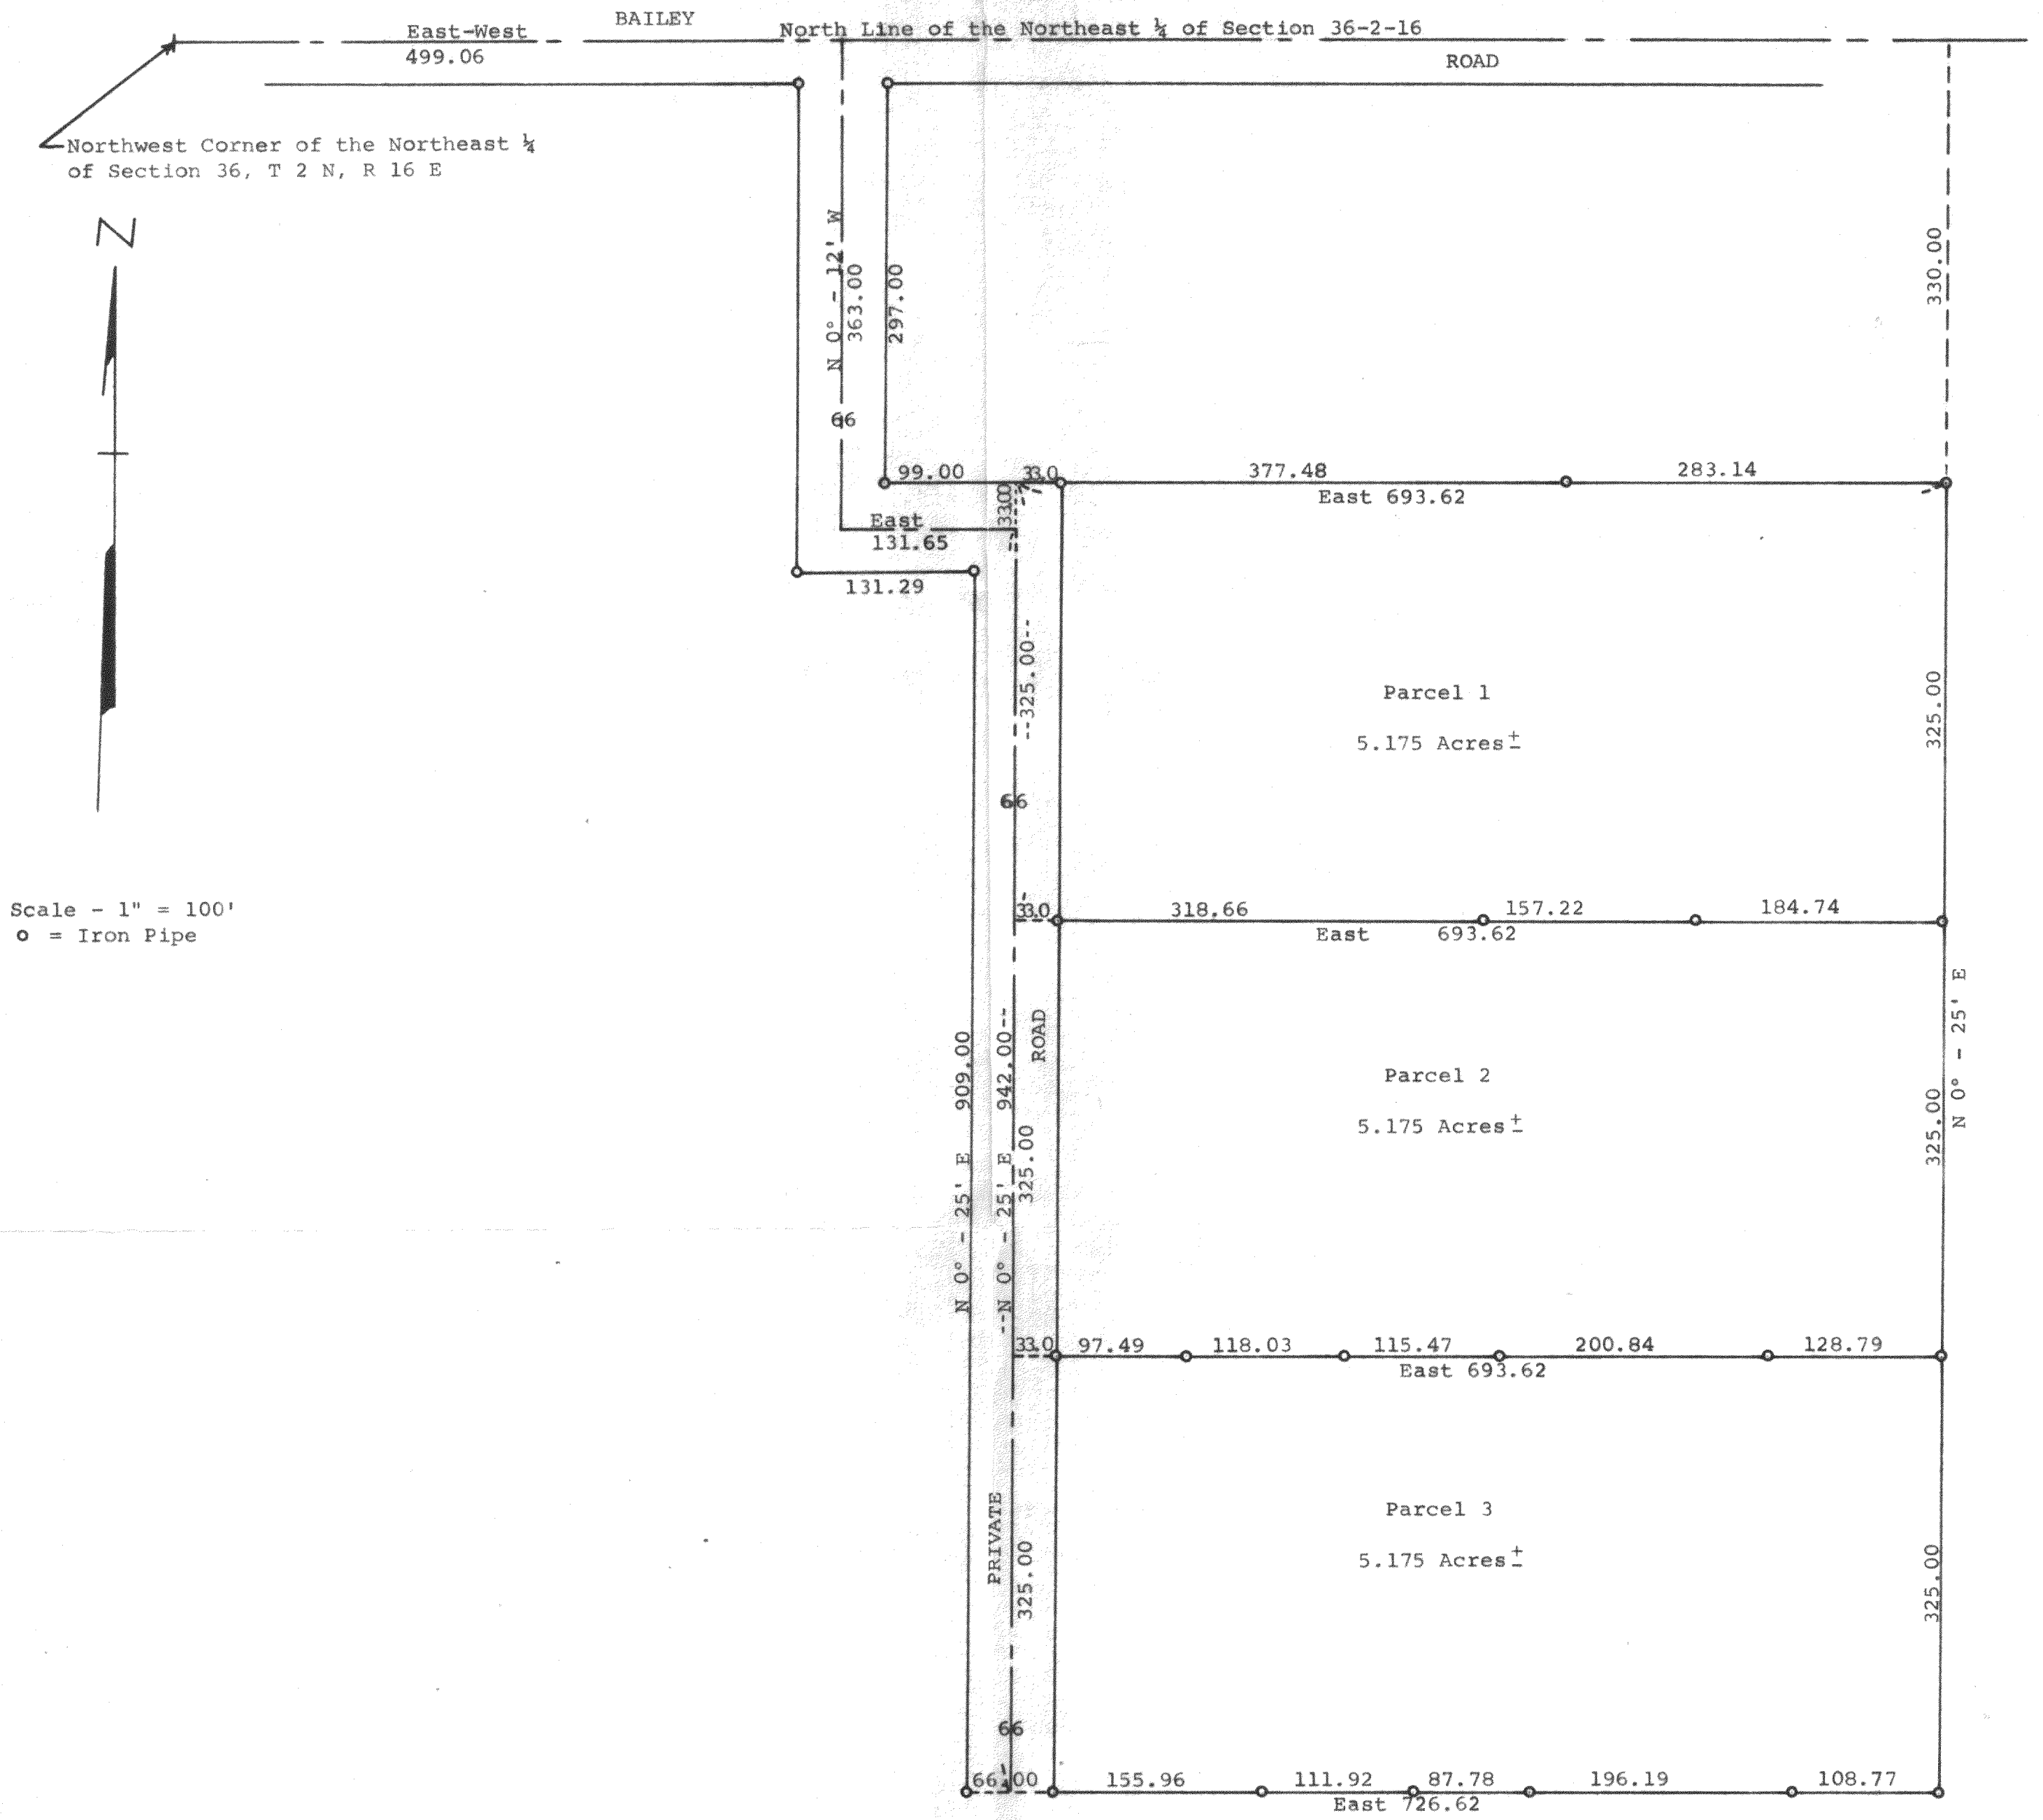

Plat of survey of parcels of land located in the West 1/2 of the Northeast 1/4 of Section 36, T 2 N, R 16 E, Walworth County, Wisconsin. October 1972

George T. Dunham
George T. Dunham, Surveyor

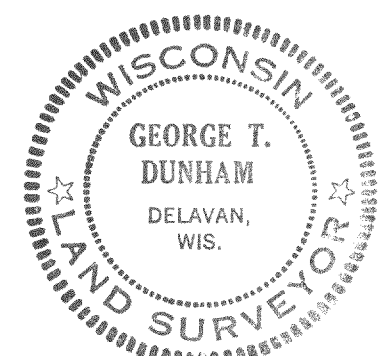

D-36-108
" " 109
" " 110
" " 111
" " 112

D-36-110
" 109
" 105

216-437