


LOCATION: Blue Heron Drive, Delavan, Wisconsin

Lot 1 in **HIGH POINTE**, being a part the Southwest 1/4 of the Southwest 1/4 of Section 21, and a part of the Southeast 1/4 and Southwest 1/4 of the Southeast 1/4 of Section 20, Town 2 North, Range 16 East, in the Town of Delavan, Walworth County, Wisconsin.

June 6, 2007

Survey No. 100575

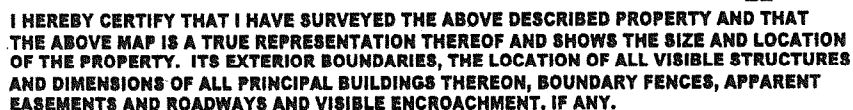

THIS SURVEY IS MADE FOR THE EXCLUSIVE USE OF THE PRESENT OWNERS OF THE PROPERTY, AND ALSO THOSE WHO PURCHASE, MORTGAGE, OR GUARANTEE THE TITLE THERETO WITHIN ONE (1) YEAR FROM THE DATE HEREOF.

METROPOLITAN SURVEY SERVICE, INC.

REGISTERED LAND SURVEYORS AND CIVIL ENGINEERS

5200 W. LOOMIS ROAD GREENDALE, WI 53129

PH. (414) 529-5380 FAX (414) 529-9787

email address survey@bizwl.rr.com

SIGNED

Dennis C. Sauer

Registered Land Surveyor 8-2421

FHP-1

211-41274