


1140 SEQUOIA STREET • DELAVAN, WISCONSIN 53115
262-728-6737

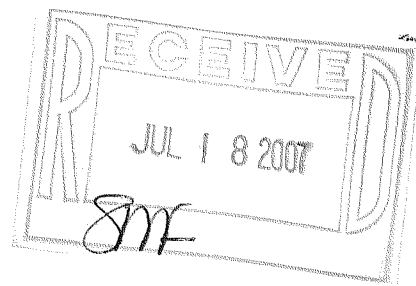

LEGEND

-  - IRON PIPE FOUND
 - IRON ROD FOUND
 - UTILITY POLE
 - OVERHEAD UTILITY LINES
 - WOOD FENCE
 WP - WOOD PORCH
 () - RECORDED AS

ORDERED BY: ROBERT LAMANTIA
610 S. ARTHUR AVE.
ARLINGTON HEIGHTS, IL 60005

I HEREBY CERTIFY THAT I HAVE SURVEYED THE ABOVE DESCRIBED PROPERTY AND THAT THE ABOVE MAP IS A TRUE REPRESENTATION THEREOF AND SHOWS THE SIZE AND LOCATION OF THE PROPERTY, ITS EXTERIOR BOUNDARIES, THE LOCATION OF ALL VISIBLE STRUCTURES AND DIMENSIONS OF ALL PRINCIPAL BUILDINGS THEREON, BOUNDARY FENCES, APPARENT EASEMENTS, ROADWAYS AND VISIBLE ENCROACHMENTS, IF ANY, TO THE BEST OF MY KNOWLEDGE AND BELIEF.

THIS SURVEY IS MADE FOR THE USE OF THE PRESENT OWNERS OF THE PROPERTY, AND ALSO THOSE WHO PURCHASE, MORTGAGE, OR GUARANTEE THE TITLE THERETO WITHIN ONE (1) YEAR FROM DATE HEREON.

David F. Rhall

DAVID F. ABELL
WISCONSIN REGISTERED LAND SURVEYOR, S-1596

May 8, 2007

DATE / / JOB NUMBER - 07029
NOTE: THIS IS NOT A CERTIFIED COPY UNLESS SEALED.

FIDLV-1104

2110-4281