


ABELL
SURVEYING & MAPPING
1140 SEQUOIA STREET • DELAVAN, WISCONSIN 53115
262-728-6737

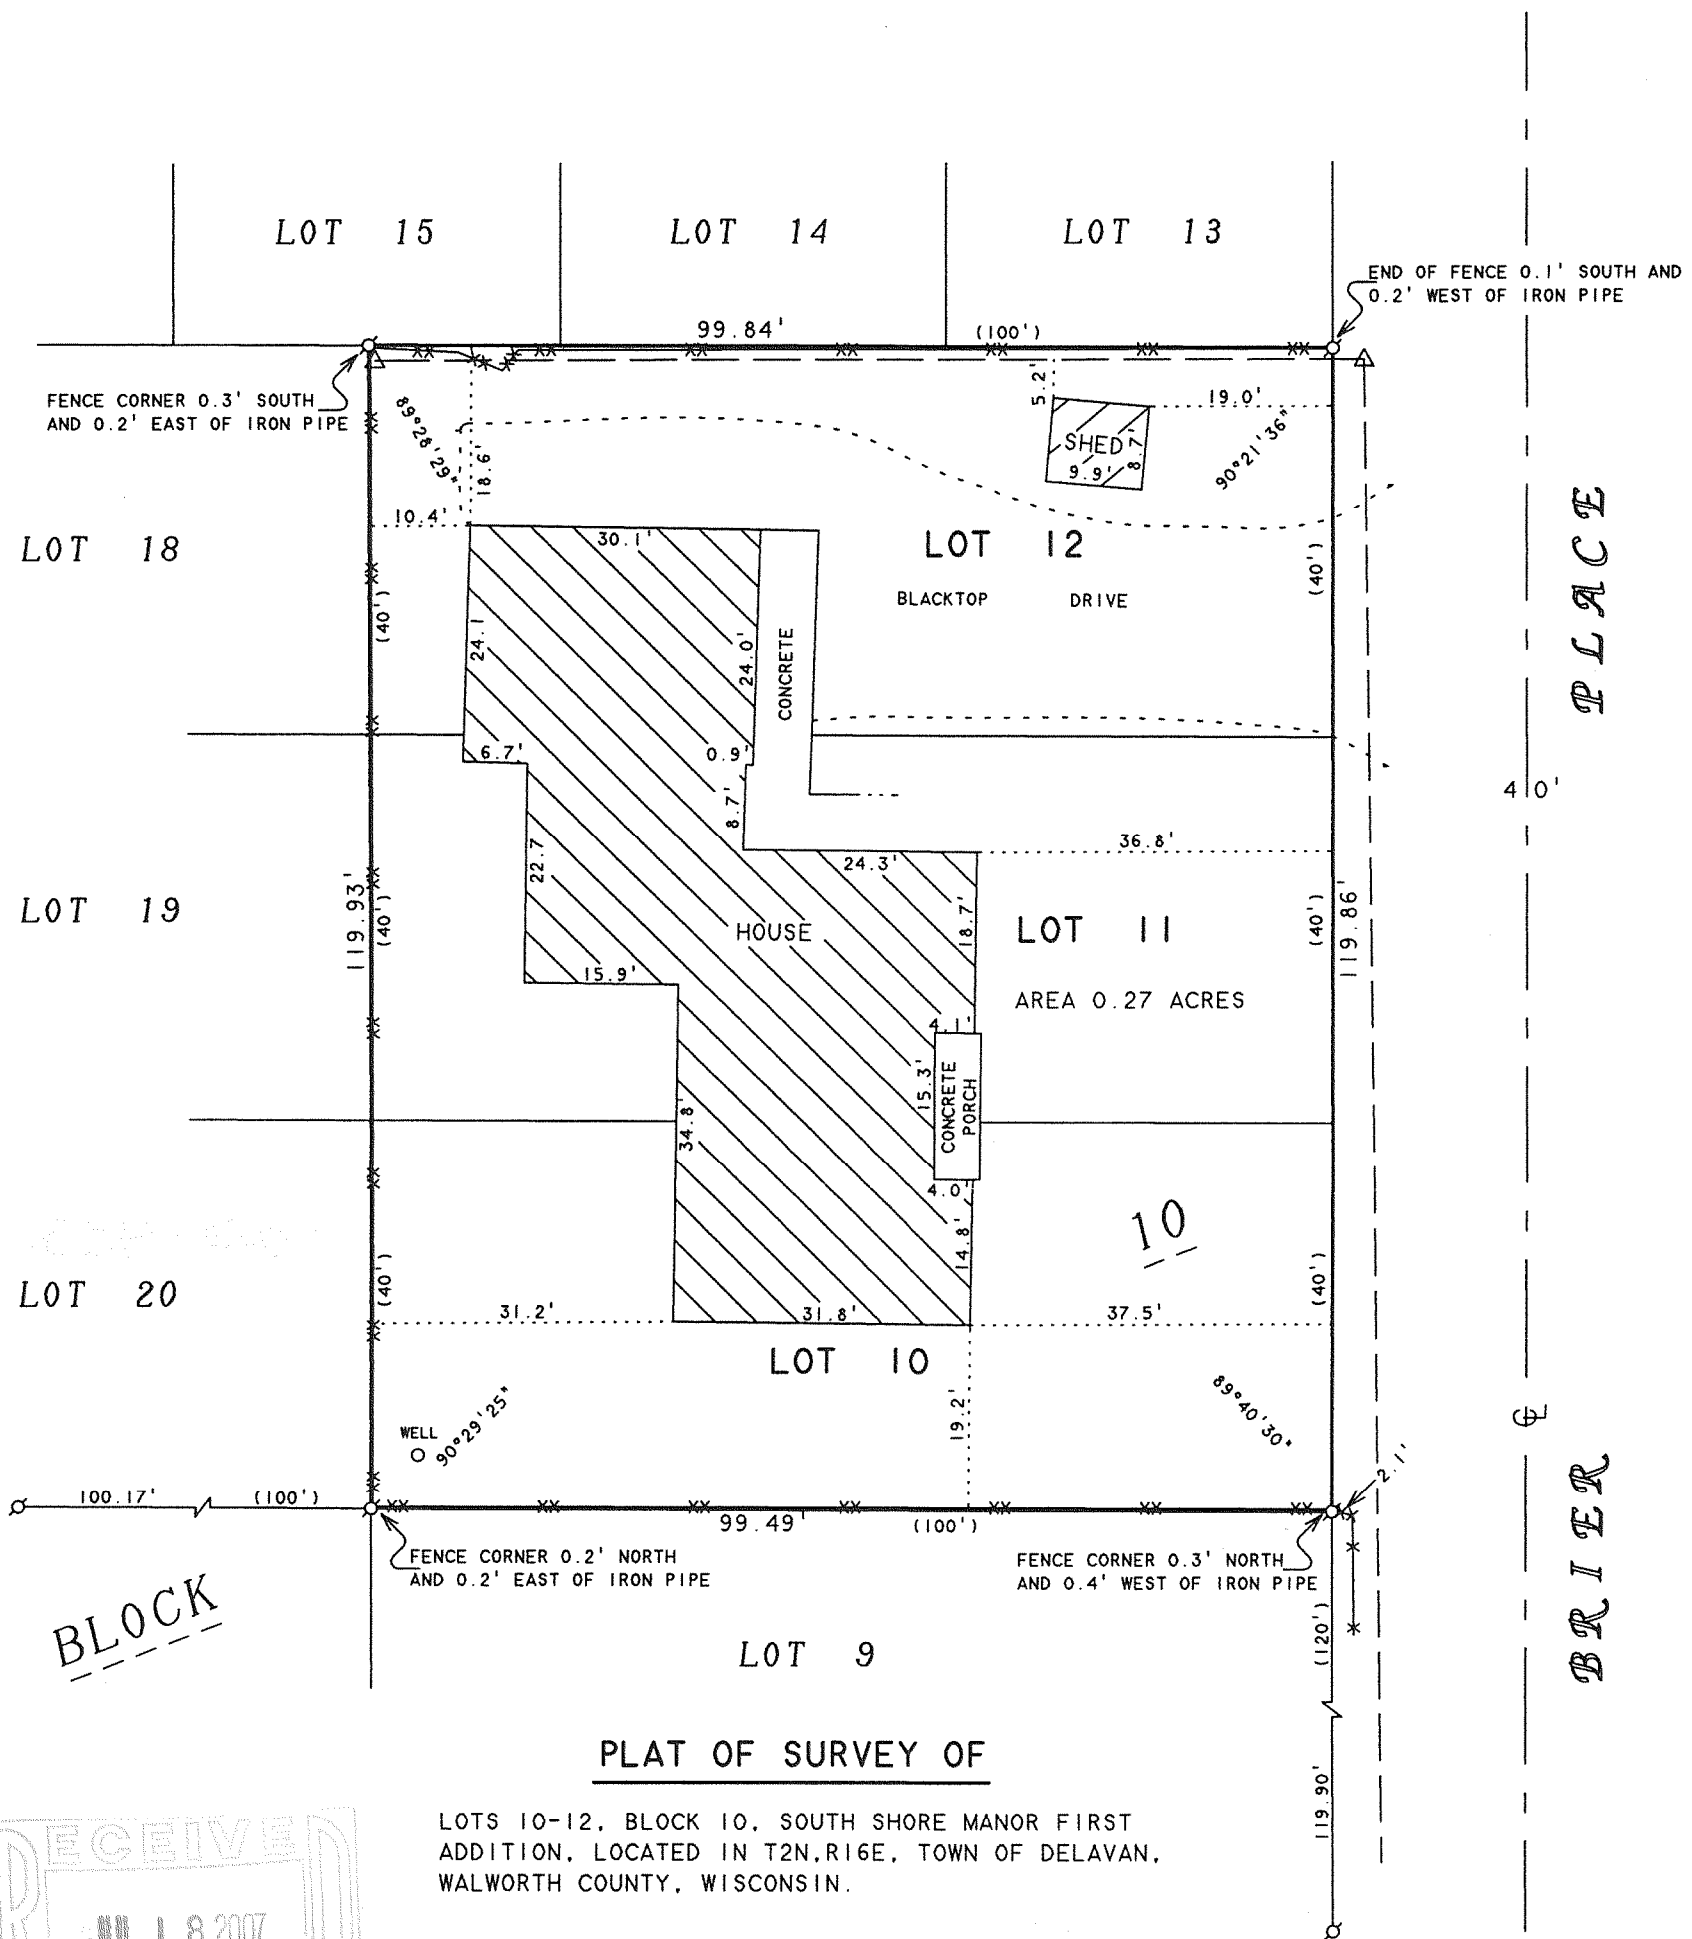

RECEIVED
JUL 18 2007
8mf

PLAT OF SURVEY OF
LOTS 10-12, BLOCK 10, SOUTH SHORE MANOR FIRST
ADDITION, LOCATED IN T2N, R16E, TOWN OF DELAVAN,
WALWORTH COUNTY, WISCONSIN.
ORDERED BY: KELLY HUNTER
FOR: EMILY HUNTER
5680 PARLIAMENT LANE #118
DELAVAN, WI 53115

- LEGEND**
- Q - IRON PIPE FOUND
 - △ - UTILITY POLE
 - - OVERHEAD UTILITY LINES
 - *—*— CHAINLINK FENCE
 - *-*- WIRE FENCE
 - () - RECORDED AS

I HEREBY CERTIFY THAT I HAVE SURVEYED THE ABOVE DESCRIBED PROPERTY AND THAT THE ABOVE MAP IS A TRUE REPRESENTATION THEREOF AND SHOWS THE SIZE AND LOCATION OF THE PROPERTY, ITS EXTERIOR BOUNDARIES, THE LOCATION OF ALL VISIBLE STRUCTURES AND DIMENSIONS OF ALL PRINCIPAL BUILDINGS THEREON, BOUNDARY FENCES, APPARENT EASEMENTS, ROADWAYS AND VISIBLE ENCROACHMENTS, IF ANY, TO THE BEST OF MY KNOWLEDGE AND BELIEF.

THIS SURVEY IS MADE FOR THE USE OF THE PRESENT OWNERS OF THE PROPERTY, AND ALSO THOSE WHO PURCHASE, MORTGAGE, OR GUARANTEE THE TITLE THERETO WITHIN ONE (1) YEAR FROM DATE HEREON.

David F. Abell
DAVID F. ABELL
WISCONSIN REGISTERED LAND SURVEYOR, S-1596

March 15, 2007

DATE: March 15, 2007 JOB NUMBER - 96059A
NOTE: THIS IS NOT A CERTIFIED COPY UNLESS SEALED.

F551-19

216-4386