



GEORGE T. DUNHAM
SURVEYING & SUBDIVIDING
DELAVAN, WISCONSIN

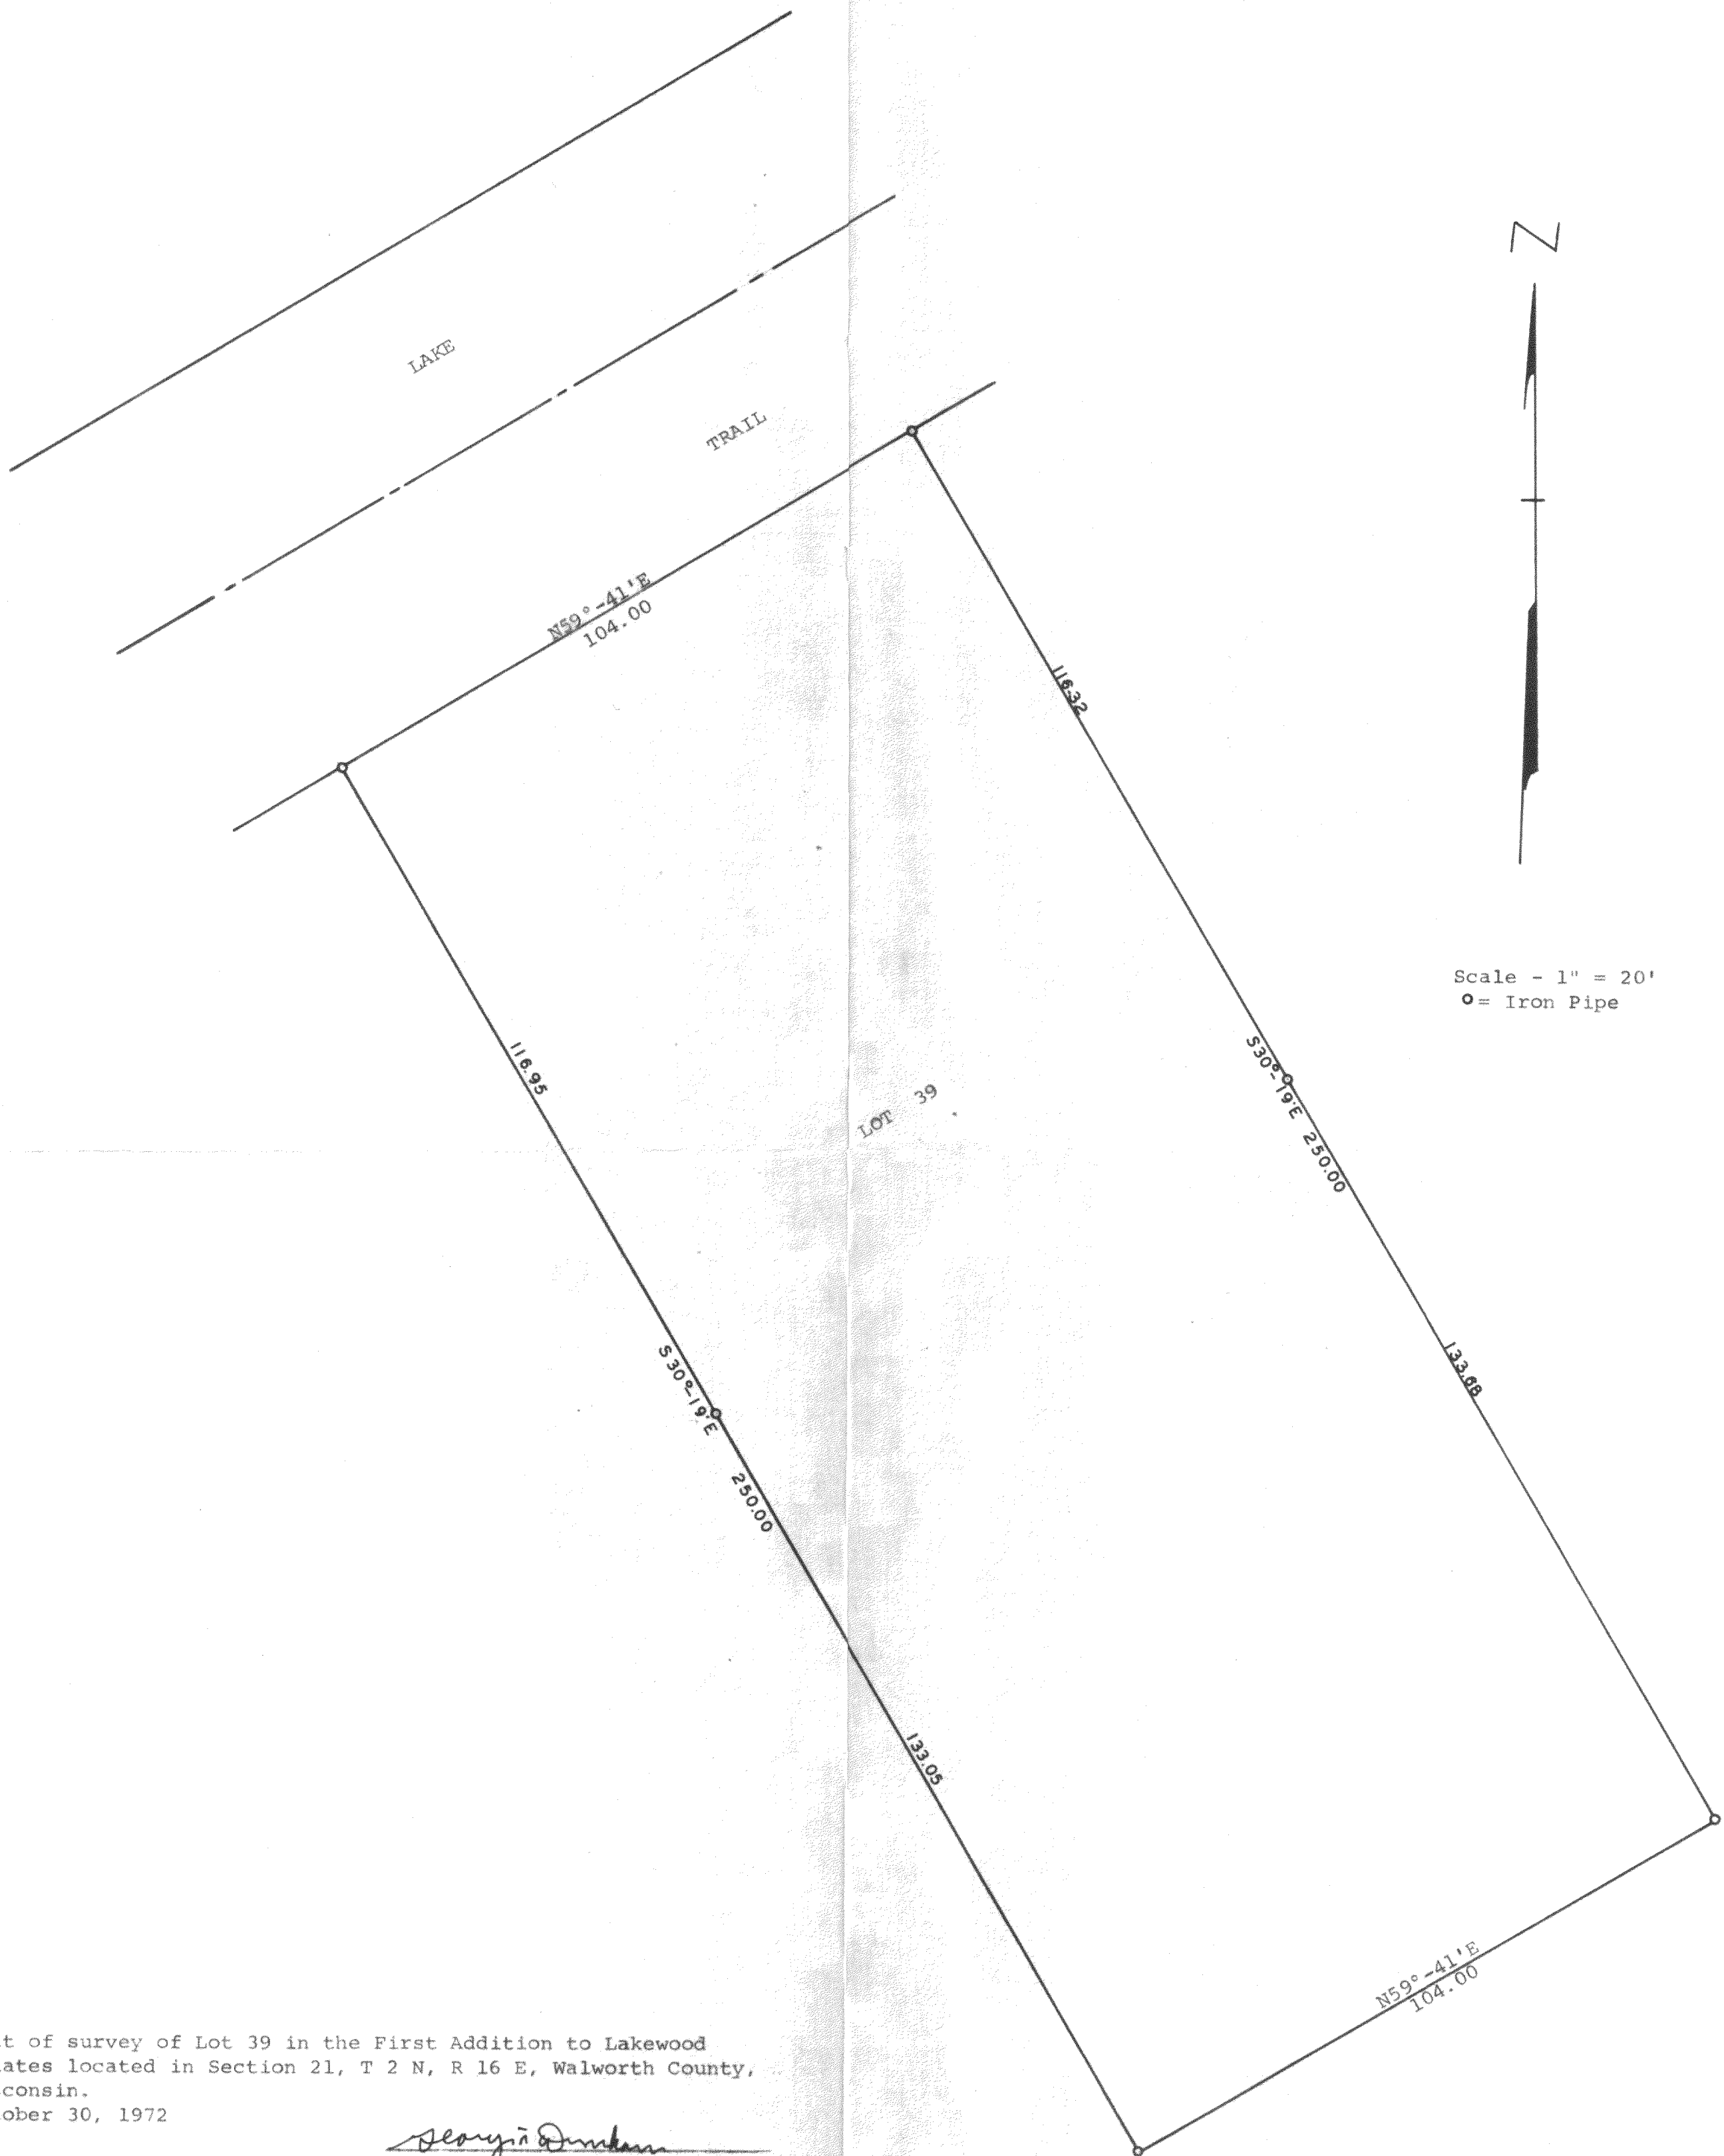

Plat of survey of Lot 39 in the First Addition to Lakewood
Estates located in Section 21, T 2 N, R 16 E, Walworth County,
Wisconsin.
October 30, 1972

George T. Dunham
George T. Dunham, Surveyor

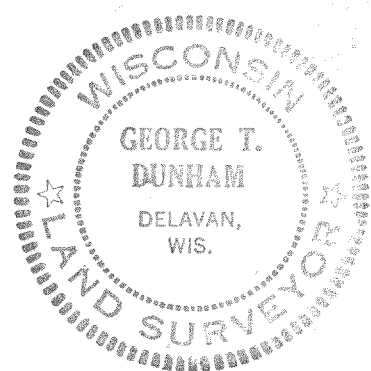

FLEA-19

216-440