


of
**Lots 47, 48 and 49 of Block 3 of
 Inlet Oaks Subdivision No. 3,**
 located in the Southeast 1/4 of Section 15, Town 2 North,
 Range 16 East, Town of Delavan, Walworth County, Wisconsin.


Surveyed for: **Uni-Pump, Inc.**
W140 N5761 Lilly Road
Menomonee Falls, Wisconsin. 53051

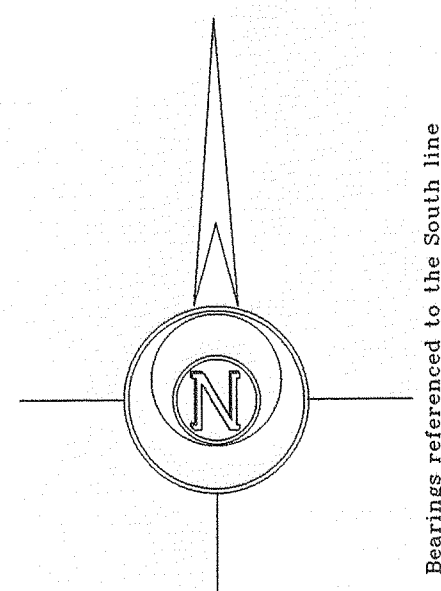

Copyright © 2007 by Jensen & Olson Land Surveying, LLC.
All rights reserved. No part of this survey plat may be reproduced or transmitted in any form by any means - graphic, electronic, or mechanical, including photocopying, tracing, or information storage and retrieval systems - without permission in writing from Douglas G. Olson, Jensen & Olson Land Surveying, LLC.


I, Douglas G. Olson, Wisconsin Registered Land Surveyor, do hereby certify that this survey was performed by me or under my direction in full compliance with the owner's/agent's instructions and Chapter A-E 7 of the Wisconsin Administrative Code "Minimum Standards for Property Surveys", and that this map is an accurate representation thereof to the best of my knowledge and belief.

Douglas G. Olson
Wisconsin Registered Land Surveyor - 2093

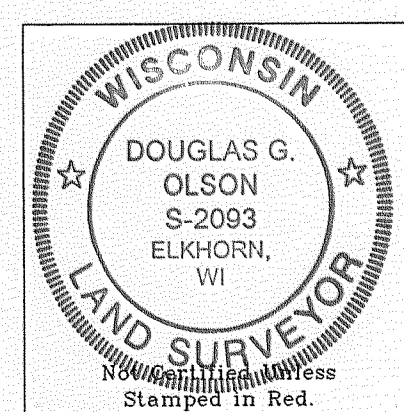


Notes: 1) This survey plat is not certified unless signed and sealed in red ink.

2) This survey is subject to Wisconsin lien laws. This Plat of Survey is the notice of intent to file lien. Lien waiver required.

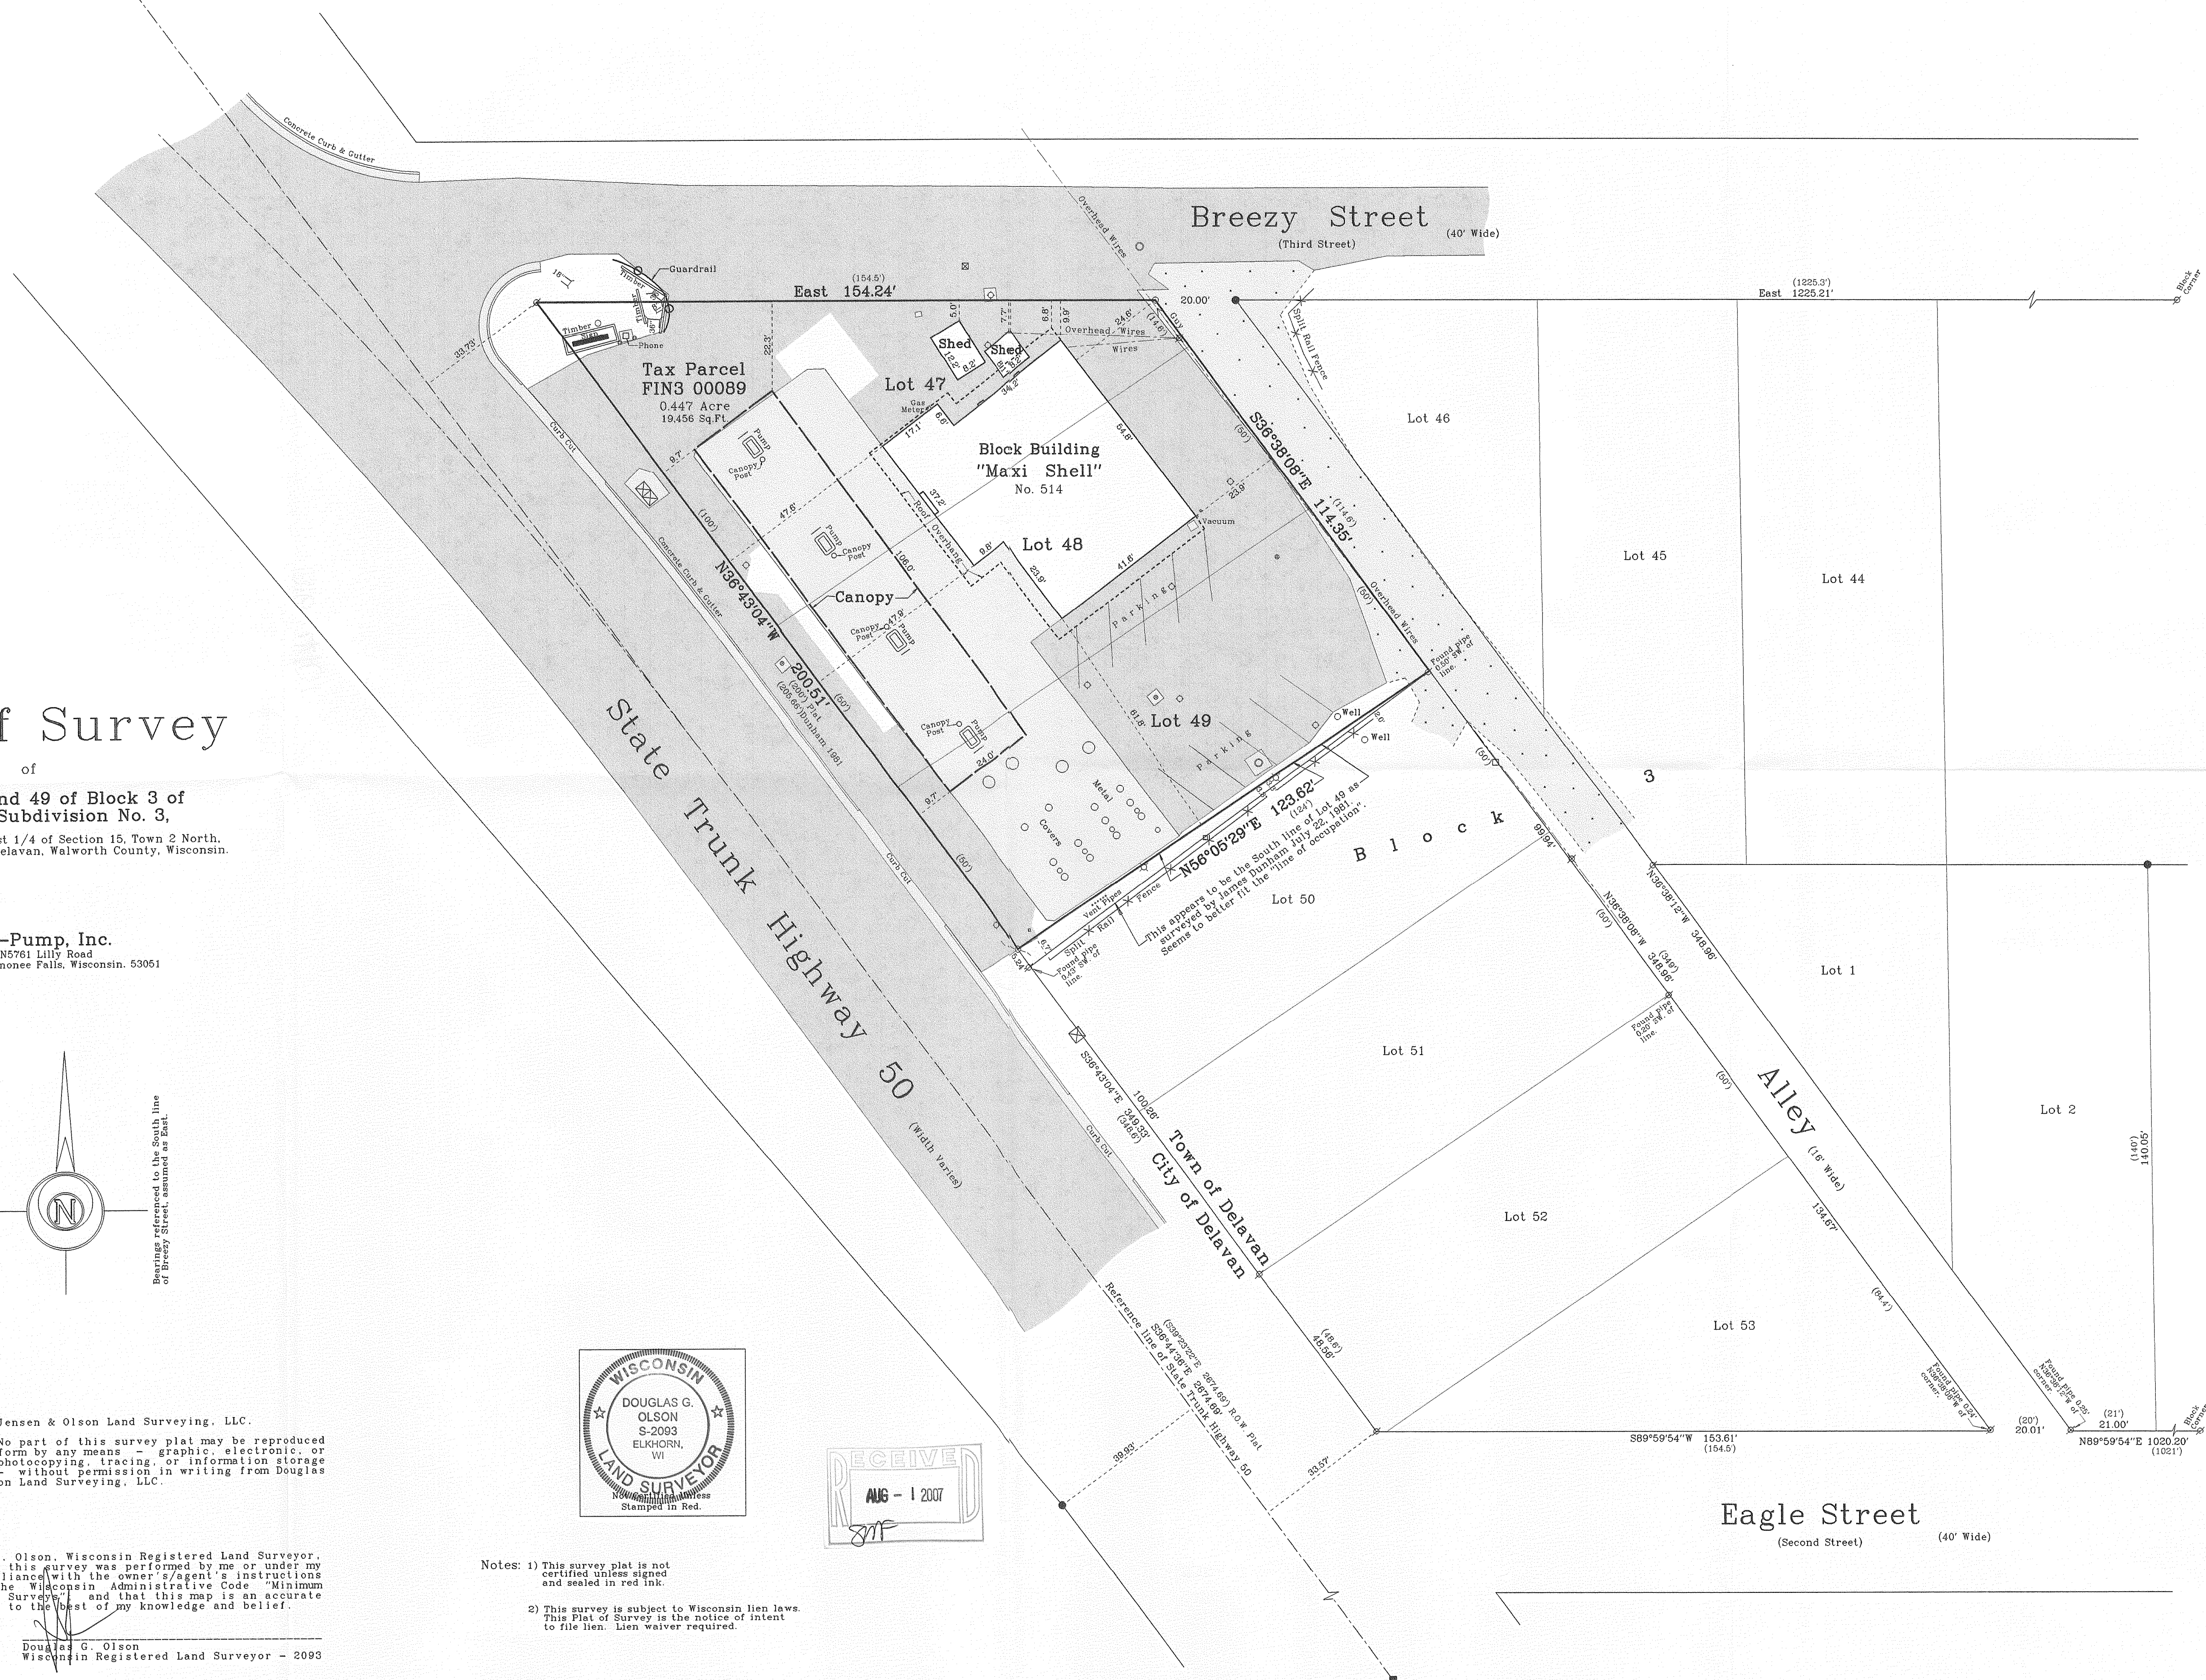

Scale in Feet
1" = 20'

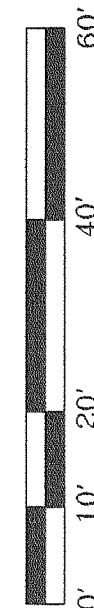

Jensen & Olson Land Surveying, LLC



Legend

- Found WI. D.O.T. Ft. Monument
- ⊗ Found Iron Pipe
- Found "4" dia.
- Recorded Information
- Utility Pole
- Manhole
- Culvert with diameter
- Monitoring Well
- Metal Casing Round
- Split Rail Fence
- Metal Cover Square

Sheet 1 of 1 Sheets.

Reference Number
2006.138

2006.138

Survey date: November 16, 2006.
Revisions: No. 1 - Proposed Caisson
 & Pumps
 No. 2 - As-built location