


THE WATERFRONT BAR AND GRILL

LOTS 39-43, BLOCK 2, INLET OAKS SUBDIVISION NO. 3
LOCATED IN PART OF SECTIONS 15 AND 22, TOWN 2 NORTH,
RANGE 16 EAST, TOWN OF DELAVAN, WALWORTH COUNTY,
WISCONSIN

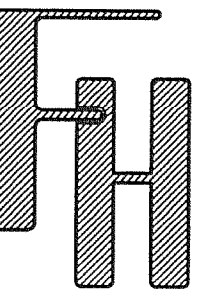


THE WATERFRONT
BAR AND GRILL
TOWN OF DELAVAN, WALWORTH COUNTY, WISCONSIN

WORK ORDERED BY -
PETER JERGENS
GENEVA BAY CONSTRUCTION
602 EAST MARKET STREET
ELKHORN, WI 53121

FARRIS, HANSEN & ASSOCIATES, INC.
ENGINEERING - ARCHITECTURE - SURVEYING
7 RIDGWAY COURT P.O. BOX 437
ELKHORN, WISCONSIN 53121
OFFICE: (262) 723-2098 FAX: (262) 723-5886

REVISIONS

PROJECT NO.
3410.07
DATE
03/22/2007
SHEET NO.
1 OF 1

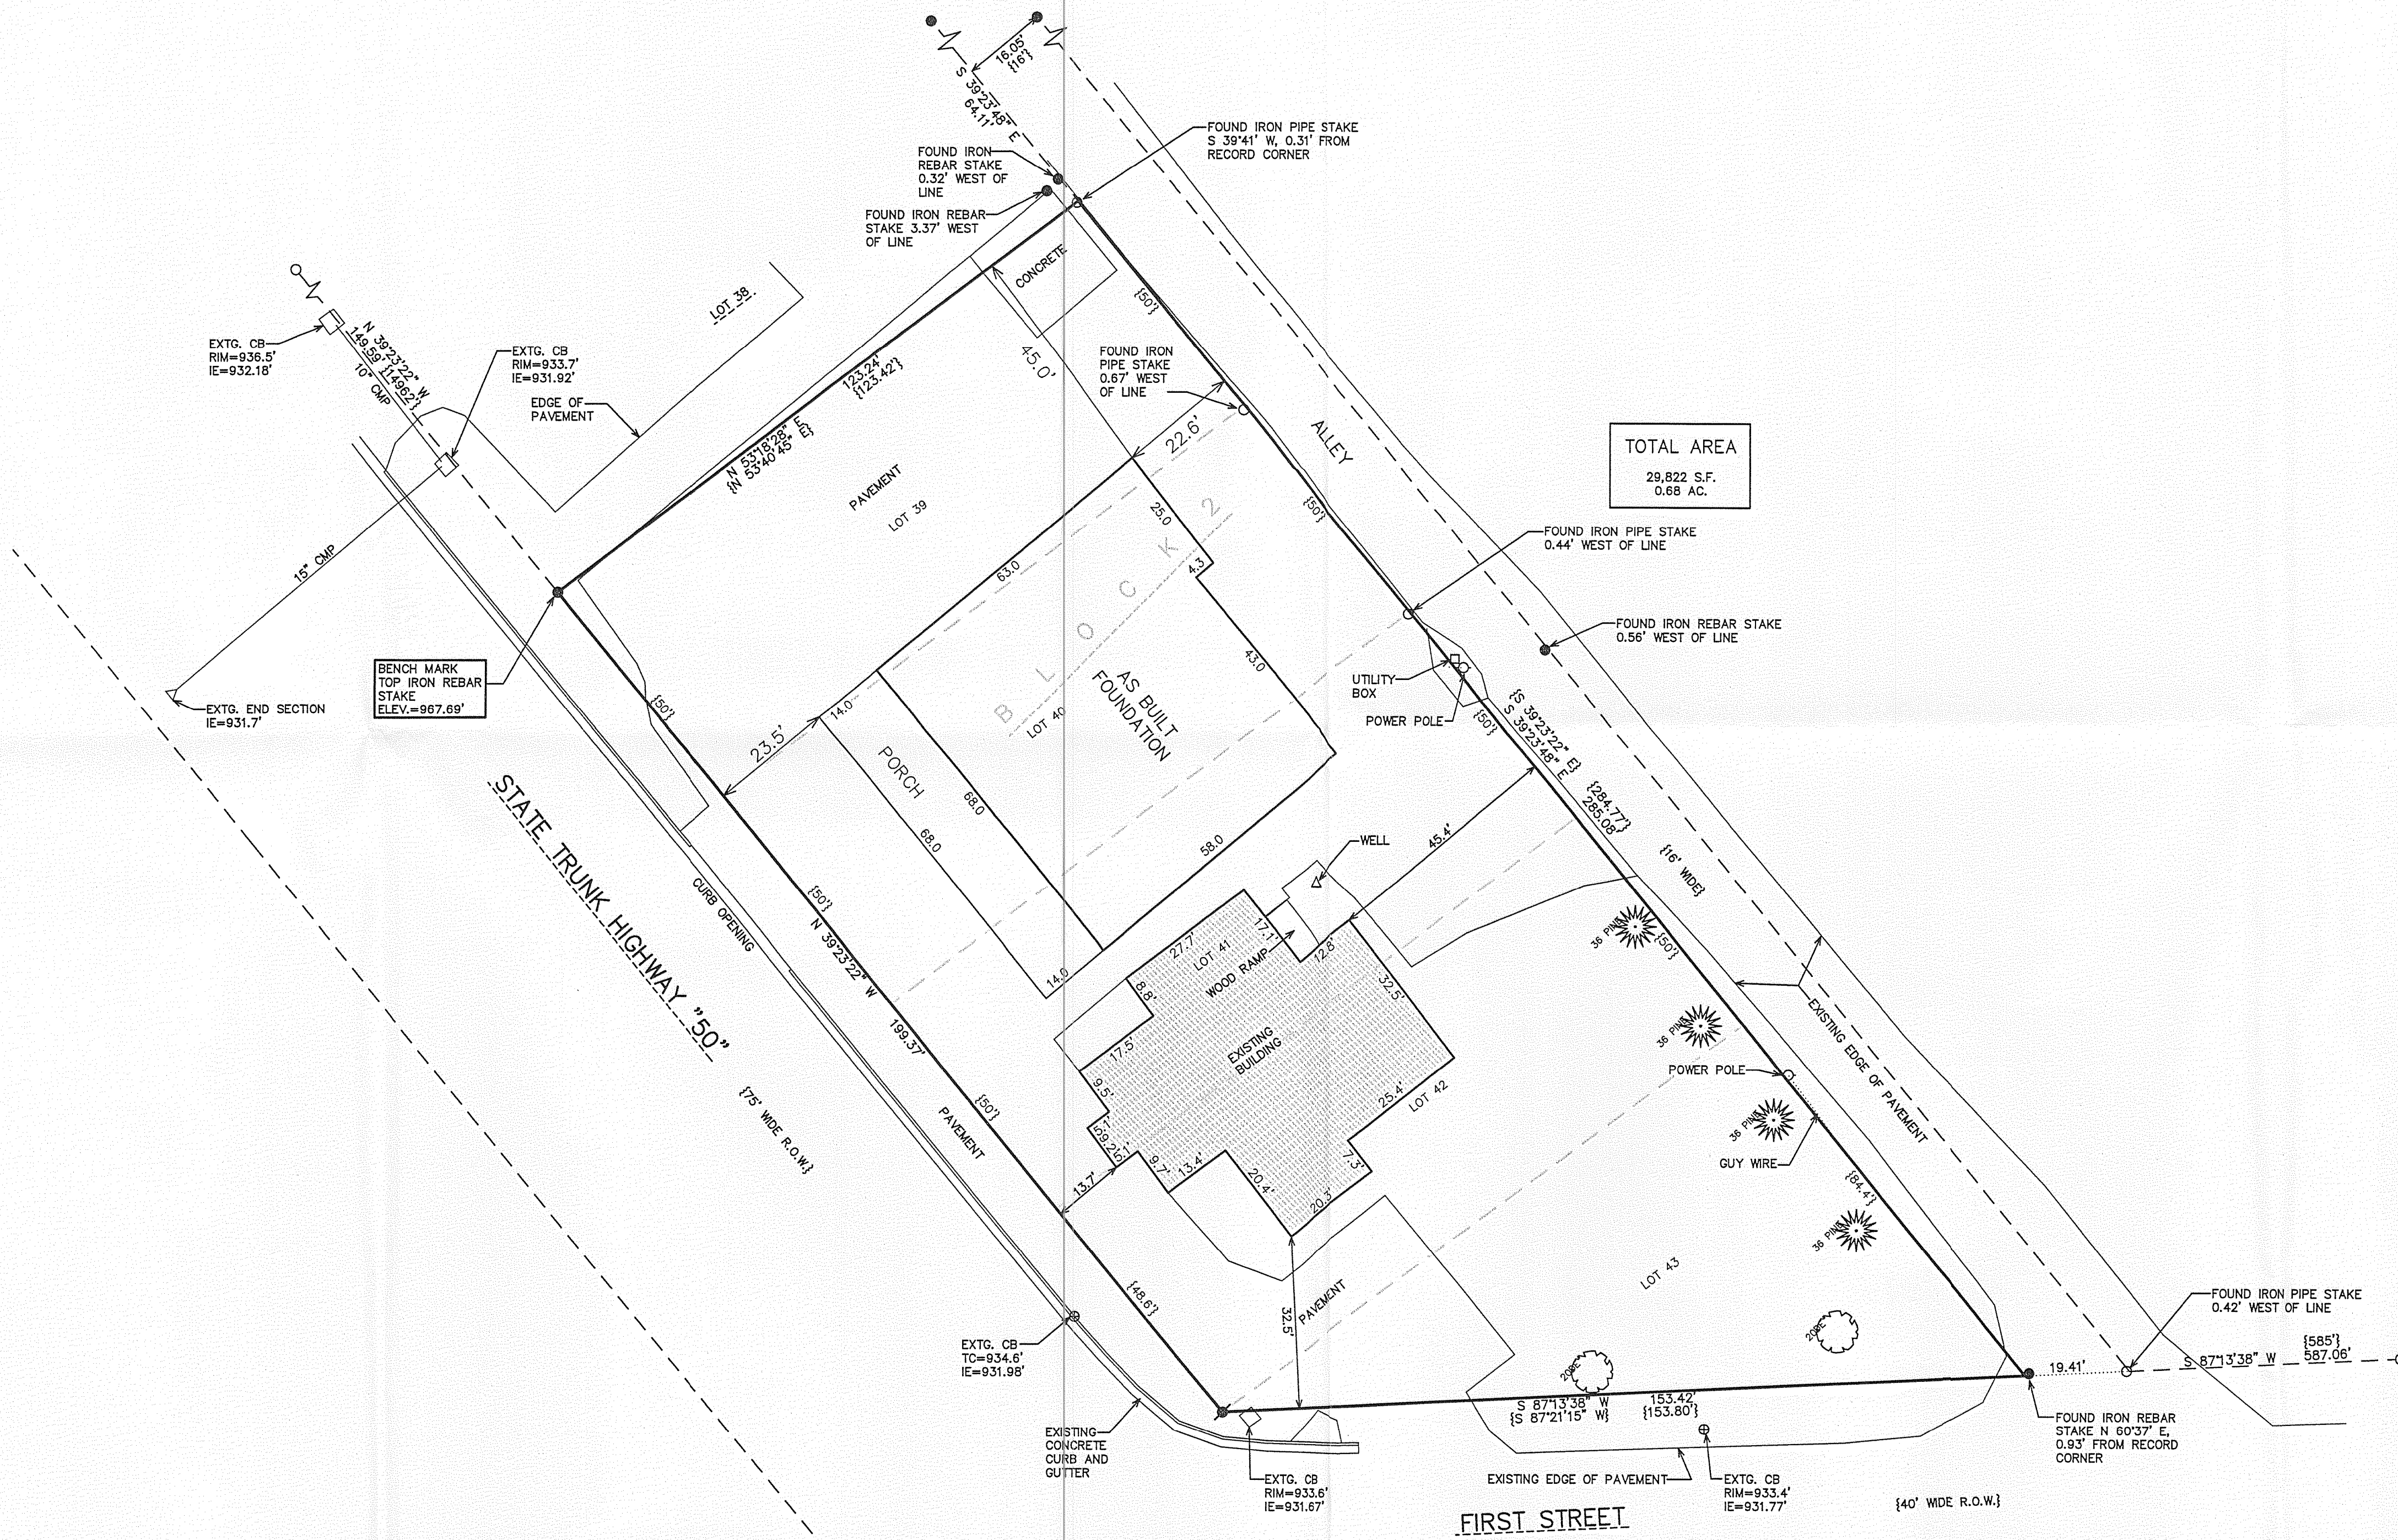


LEGEND
○ = FOUND IRON PIPE STAKE
● = FOUND IRON REBAR STAKE
■ = SET IRON REBAR STAKE
[XXX] = RECORDED AS

NOTE: COPIES OF THIS MAP TO WHICH THE FOLLOWING CERTIFICATE WILL APPLY SHOW THE SURVEYOR'S ORIGINAL SEAL AND SIGNATURE IN RED INK. COPIES BY ANY OTHER MEANS MAY HAVE ALTERATIONS WHICH DO NOT REPRESENT THE SURVEYOR'S WORK PRODUCT.

I HEREBY CERTIFY THAT THE ABOVE DESCRIBED PROPERTY HAS BEEN SURVEYED UNDER MY DIRECTION AND THAT THE ABOVE MAP IS A TRUE REPRESENTATION THEREOF AND SHOWS THE SIZE AND LOCATION OF THE PROPERTY AND ITS EXTERIOR BOUNDARIES. THIS SURVEY IS MADE FOR THE USE OF THE PRESENT OWNERS OF THE PROPERTY, AND ALSO THOSE WHO PURCHASE, MORTGAGE, OR GUARANTEE THE TITLE THERETO WITHIN ONE YEAR FROM THE DATE HEREOF.

REVISED 08-23-2007
TO SHOW SIZE & LOCATION OF
AS BUILT FOUNDATION

DATED: MARCH 22, 2007
PETER S. GORDON R.L.S. 2101

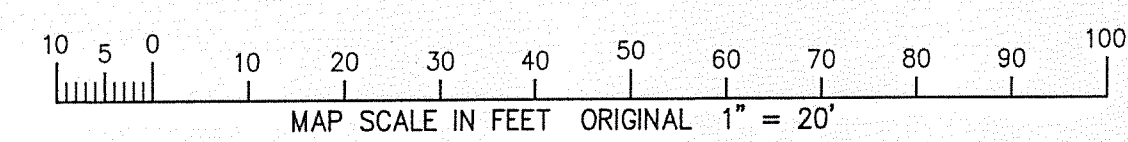

FIN3-53

216-4400