

PLAT OF SURVEY


WORK ORDERED BY -
STEBNITZ BUILDERS
1102 ANN STREET
DELAVAN, WI. 53115

FARRIS, HANSEN & ASSOCIATES, INC.
ENGINEERING - ARCHITECTURE - SURVEYING
7 RIDGWAY COURT P.O. BOX 437
ELKHORN, WISCONSIN 53121
OFFICE: (262) 723-2098 FAX: (262) 723-5886

REVISIONS
03/23/2007-KD
TO SHOW SIZE AND
LOCATION OF
PROPOSED ADDITION
7/11/2007-KB
TO SHOW SIZE AND
LOCATION OF AS-BUILT
ADDITION & DECK

PROJECT NO.
5866
DATE
08/21/01
SHEET NO.
1 OF 1

PLAT OF SURVEY
LOT 2 OF THE ADDITION TO WILLOW POINT PARK
LOCATED IN THE SE 1/4 OF SECTION 29, TOWN 2 NORTH, RANGE 16 EAST
WALWORTH COUNTY, WISCONSIN

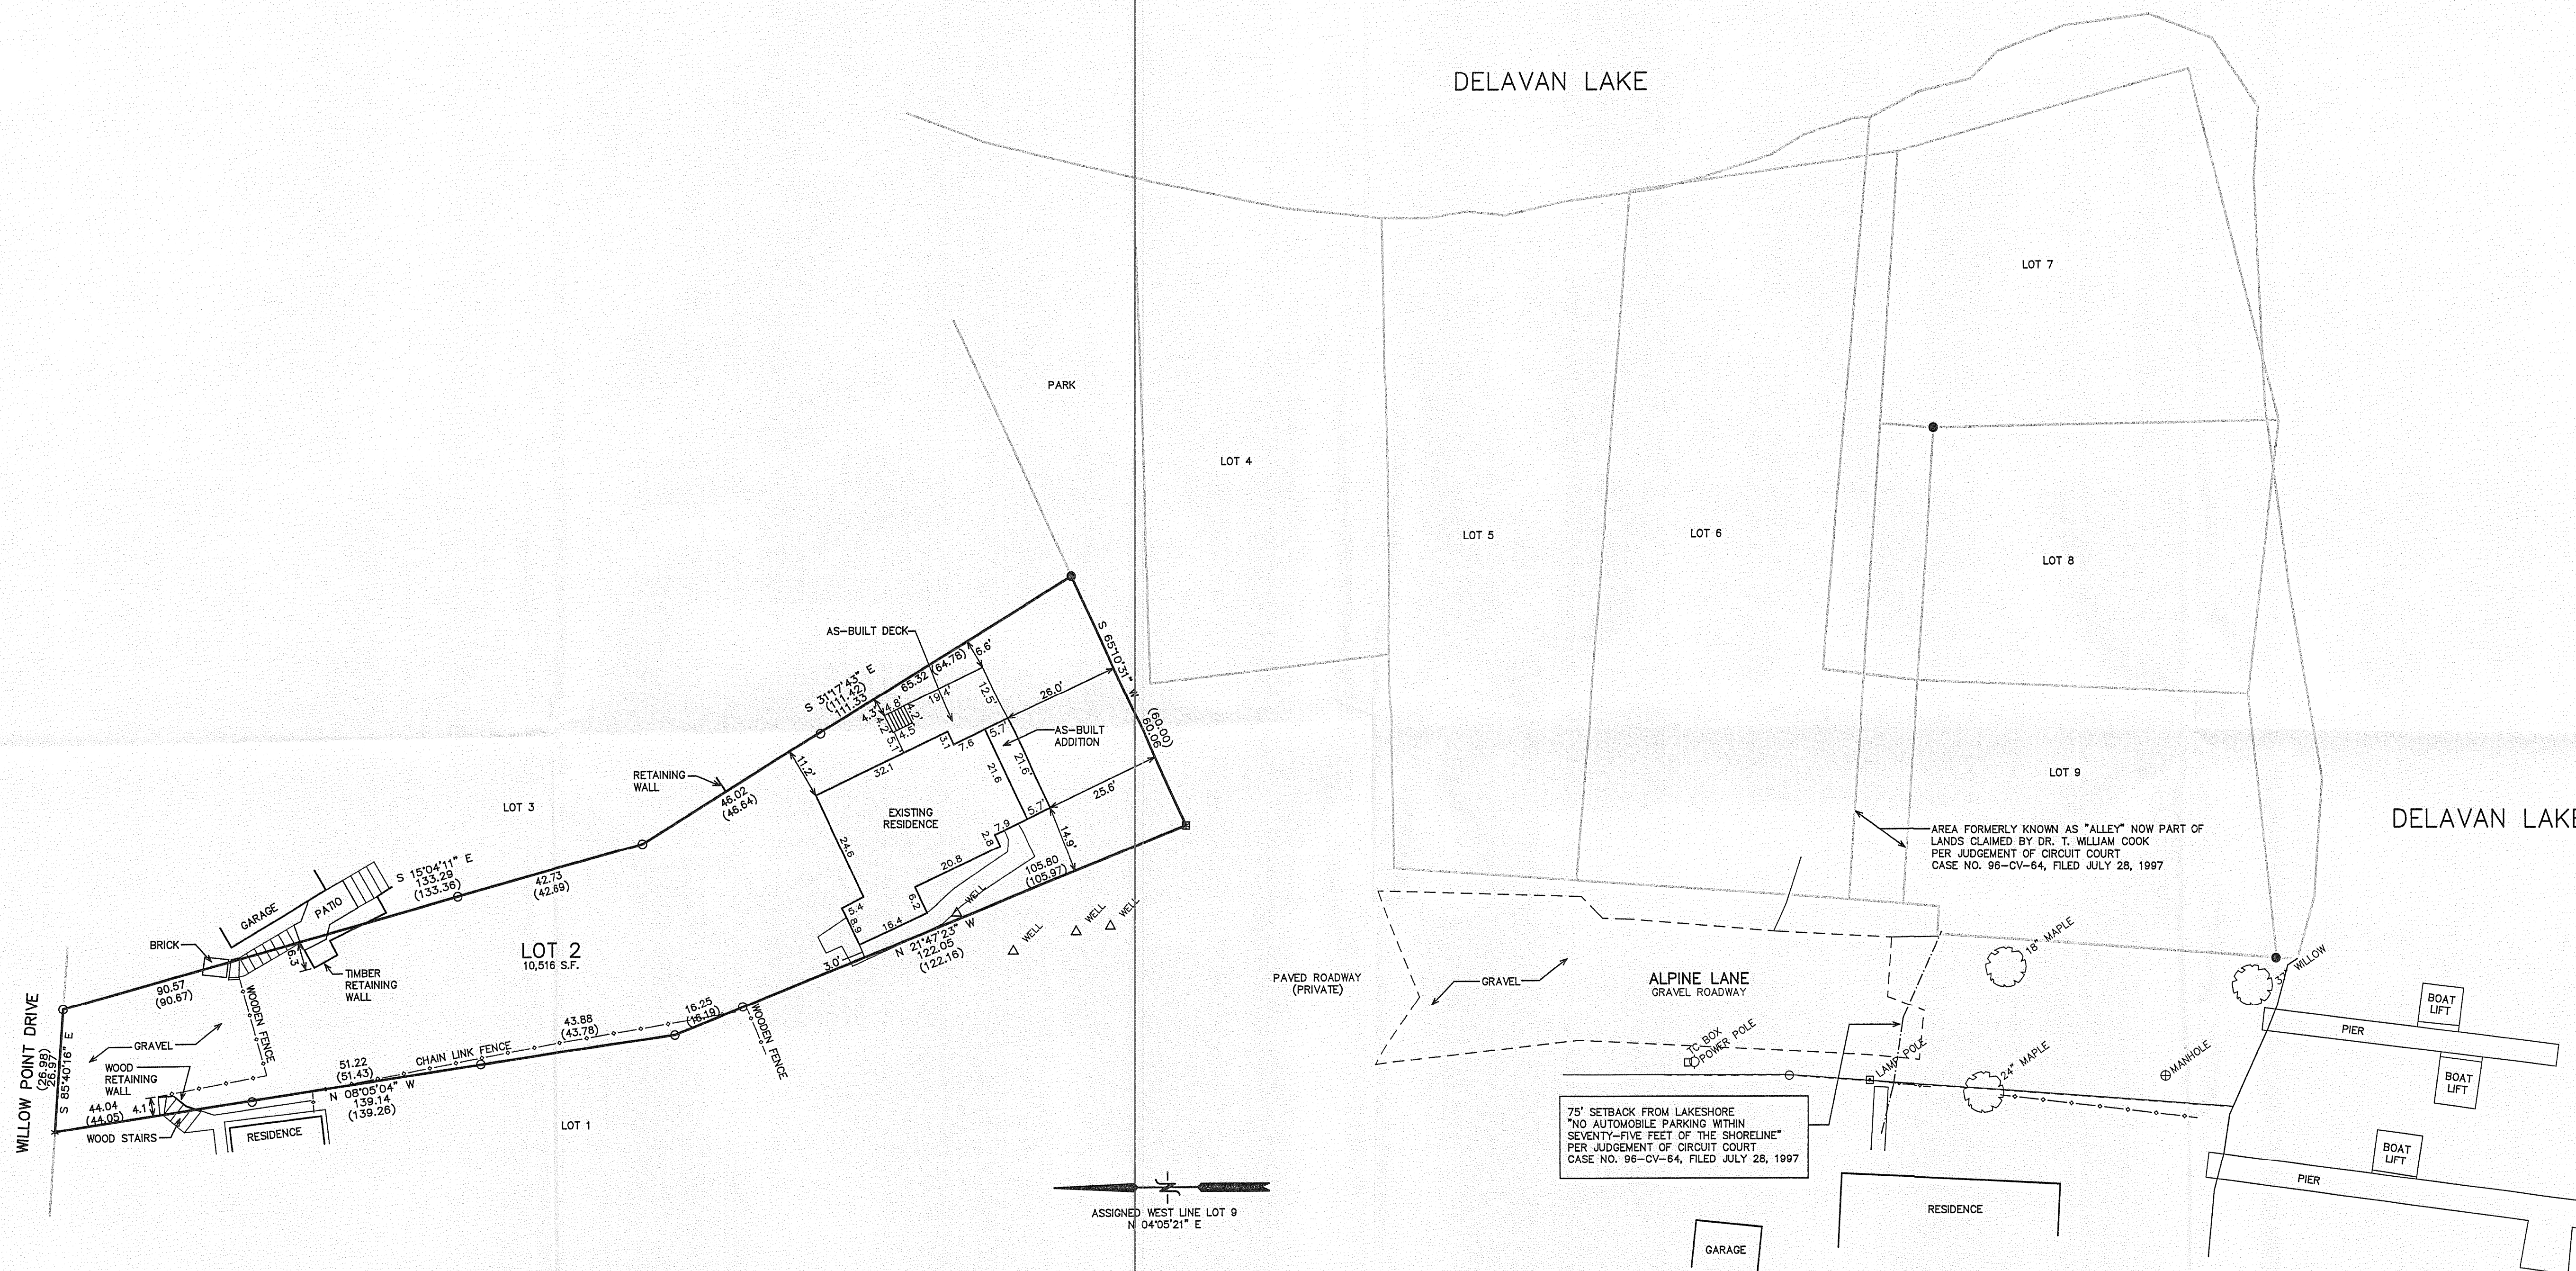

LEGEND
* = SET NAIL
O = FOUND IRON PIPE STAKE
● = FOUND IRON REBAR STAKE
■ = SET LANDSCAPE SPIKE IN CONCRETE MONUMENT
(XXX) = RECORDED AS

NOTE: COPIES OF THIS MAP TO WHICH THE FOLLOWING CERTIFICATE WILL APPLY SHOW SURVEYOR'S ORIGINAL SEAL AND SIGNATURE IN RED INK. COPIES BY ANY OTHER MEANS MAY HAVE ALTERATIONS WHICH DO NOT REPRESENT THE SURVEYOR'S WORK PRODUCT.

I HEREBY CERTIFY THAT THE ABOVE DESCRIBED PROPERTY HAS BEEN SURVEYED UNDER MY DIRECTION AND THAT THE ABOVE MAP IS A TRUE REPRESENTATION THEREOF AND SHOWS THE SIZE AND LOCATION OF THE PROPERTY AND ITS EXTERIOR BOUNDARIES. THIS SURVEY IS MADE FOR THE USE OF THE PRESENT OWNERS OF THE PROPERTY, AND ALSO THOSE WHO PURCHASE, MORTGAGE, OR GUARANTEE THE TITLE THERETO WITHIN ONE YEAR FROM THE DATE HEREOF.

DATED: 08/22/2001
PETER S. GORDON R.L.S. 2101
REVISED 03-26-2007
TO SHOW SIZE & LOCATION OF
PROPOSED IMPROVEMENTS



10 5 0 10 20 30 40 50 60 70 80 90 100
MAP SCALE IN FEET ORIGINAL 1" = 20'

FWIA-1A

216-4422