



ABELL
SURVEYING & MAPPING

1140 SEQUOIA STREET • DELAVAN, WISCONSIN 53115
262-728-6737

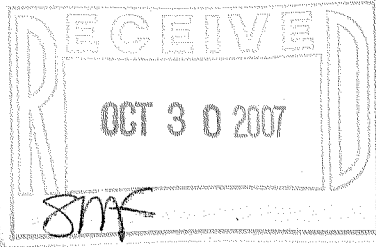

OCTOBER 8, 2007 - REMARKED CORNERS AT OWNERS
REQUEST.

ORDERED BY: DAVE KOPPLIN
5486 STATE ROAD 11
ELKHORN, WI 53121

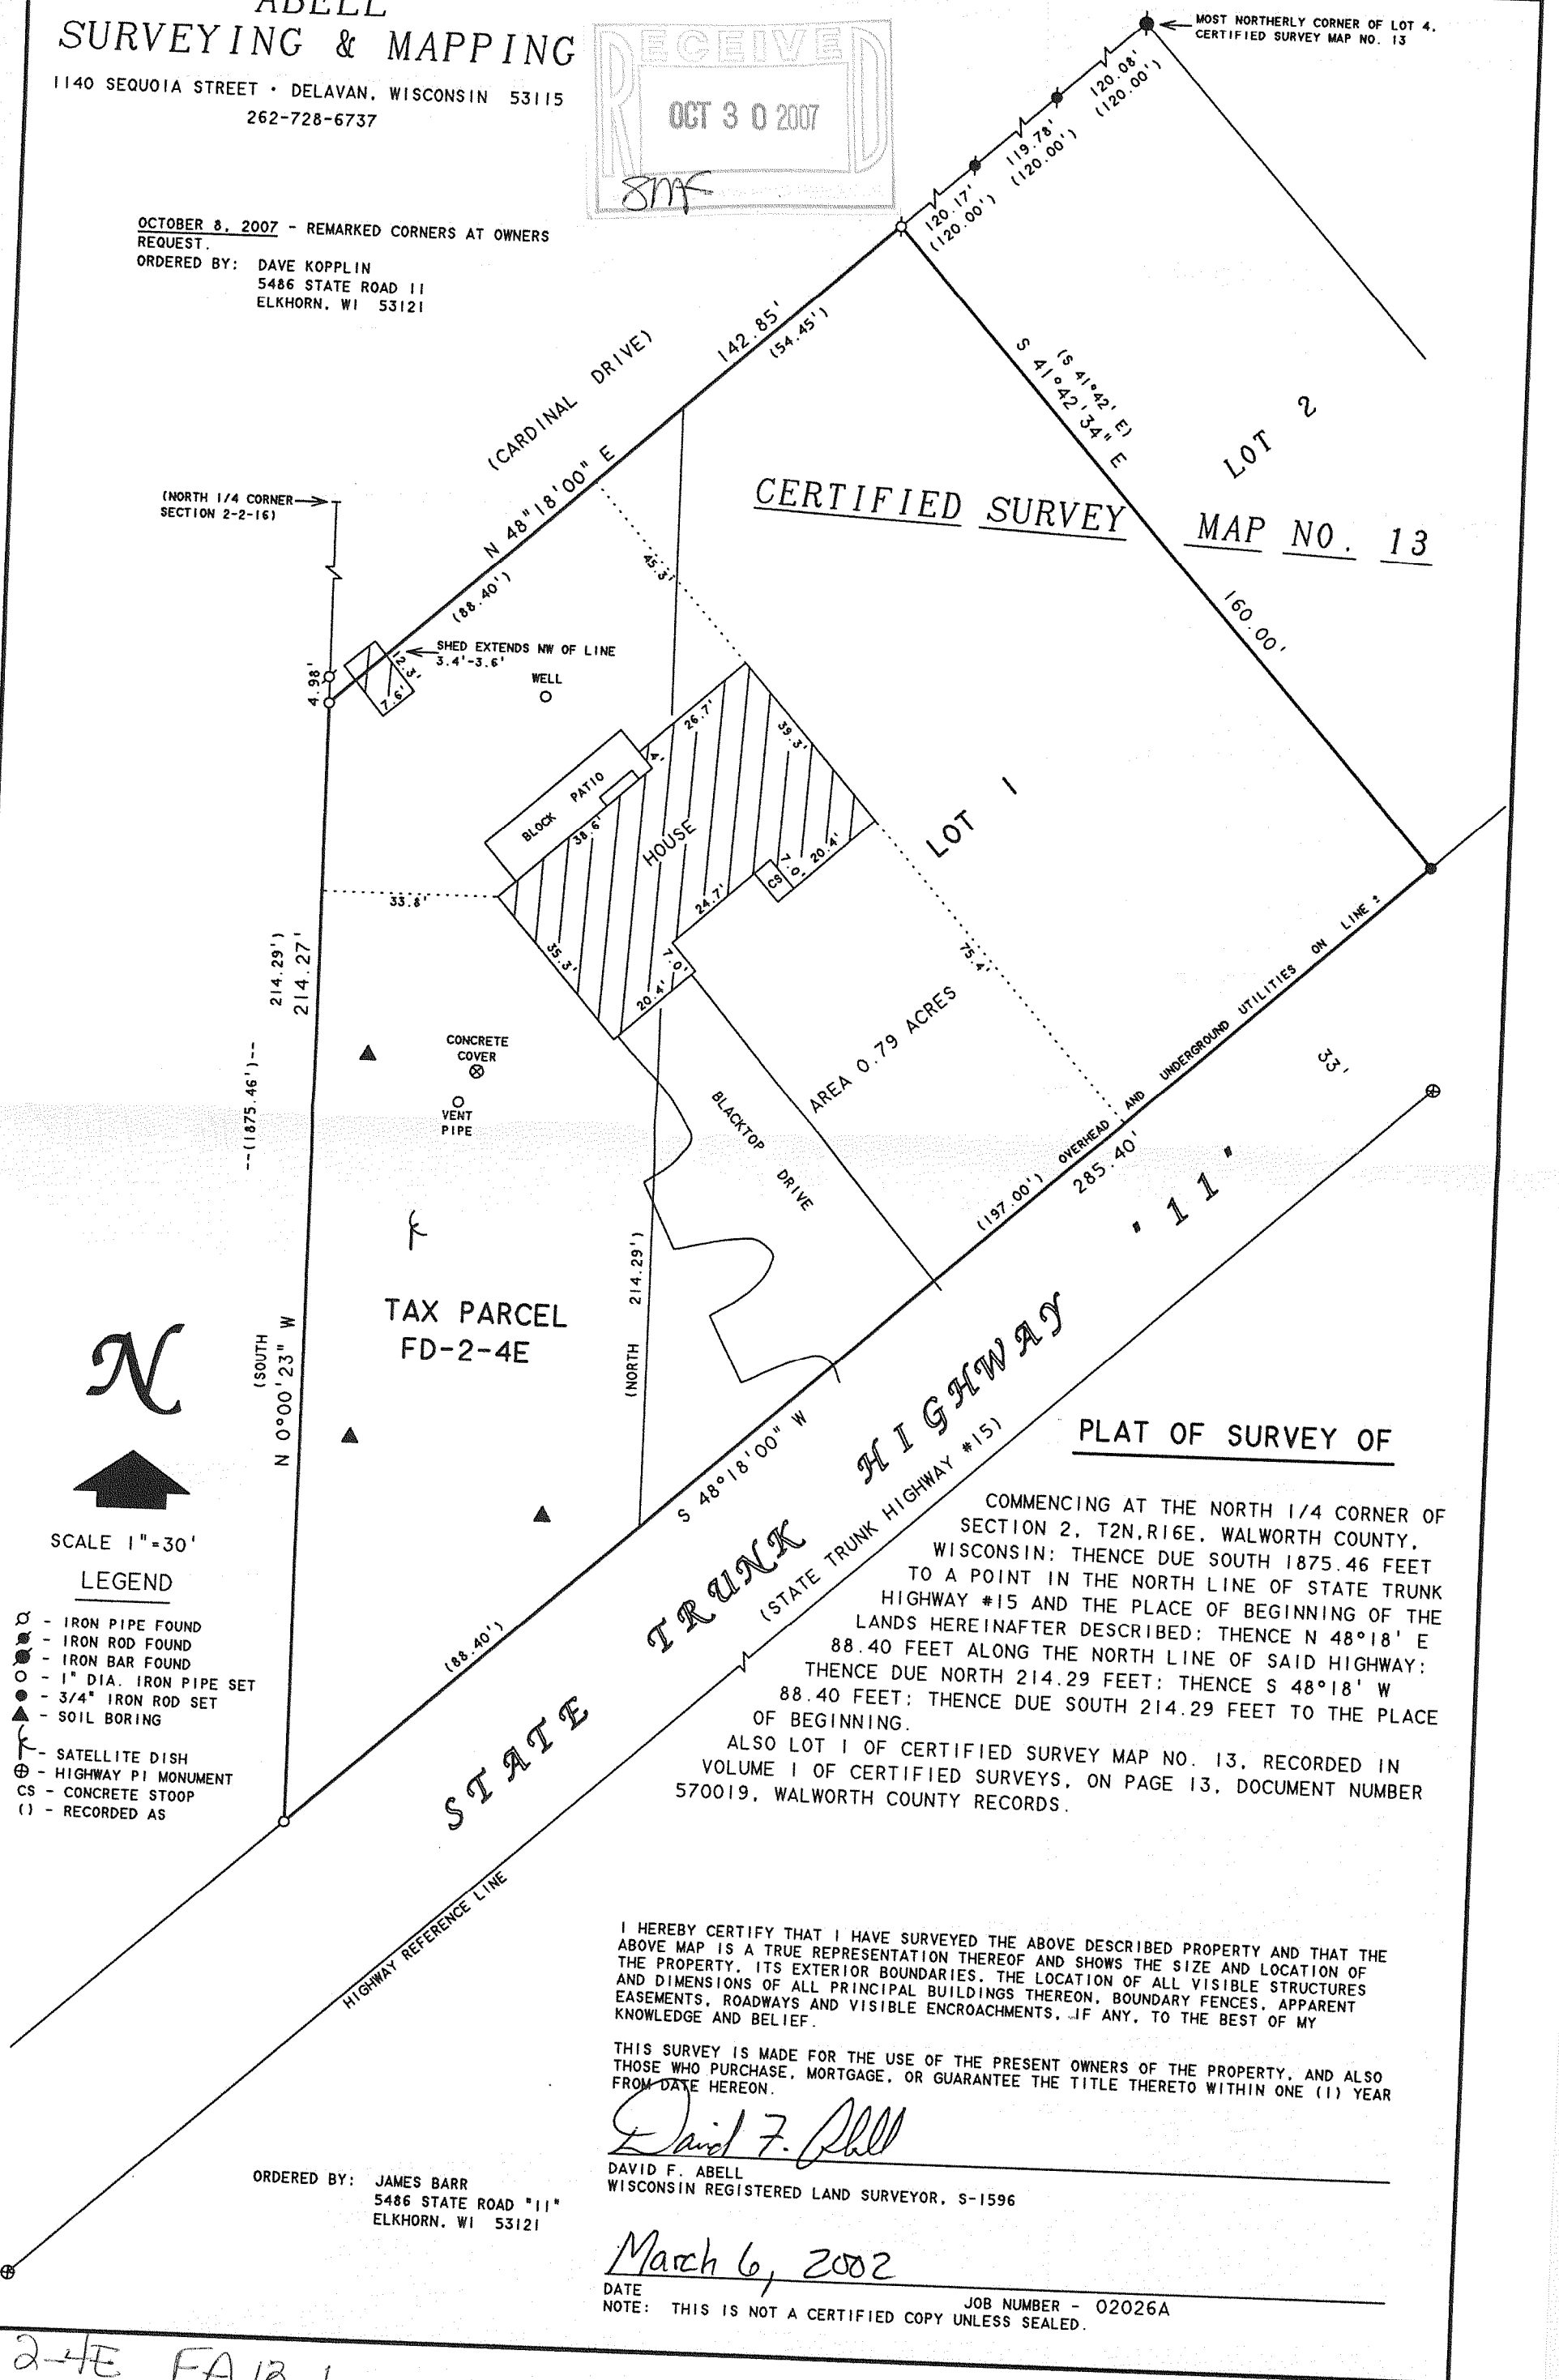

COMMENCING AT THE NORTH 1/4 CORNER OF SECTION 2, T2N, R16E, WALWORTH COUNTY, WISCONSIN; THENCE DUE SOUTH 1875.46 FEET TO A POINT IN THE NORTH LINE OF STATE TRUNK HIGHWAY #15 AND THE PLACE OF BEGINNING OF THE LANDS HEREINAFTER DESCRIBED; THENCE N 48°18' E 88.40 FEET ALONG THE NORTH LINE OF SAID HIGHWAY; THENCE DUE NORTH 214.29 FEET; THENCE S 48°18' W 88.40 FEET; THENCE DUE SOUTH 214.29 FEET TO THE PLACE OF BEGINNING.

ALSO LOT 1 OF CERTIFIED SURVEY MAP NO. 13, RECORDED IN VOLUME 1 OF CERTIFIED SURVEYS, ON PAGE 13, DOCUMENT NUMBER 570019, WALWORTH COUNTY RECORDS.

I HEREBY CERTIFY THAT I HAVE SURVEYED THE ABOVE DESCRIBED PROPERTY AND THAT THE ABOVE MAP IS A TRUE REPRESENTATION THEREOF AND SHOWS THE SIZE AND LOCATION OF THE PROPERTY, ITS EXTERIOR BOUNDARIES, THE LOCATION OF ALL VISIBLE STRUCTURES AND DIMENSIONS OF ALL PRINCIPAL BUILDINGS THEREON, BOUNDARY FENCES, APPARENT EASEMENTS, ROADWAYS AND VISIBLE ENCROACHMENTS, IF ANY, TO THE BEST OF MY KNOWLEDGE AND BELIEF.

THIS SURVEY IS MADE FOR THE USE OF THE PRESENT OWNERS OF THE PROPERTY, AND ALSO THOSE WHO PURCHASE, MORTGAGE, OR GUARANTEE THE TITLE THERETO WITHIN ONE (1) YEAR FROM DATE HEREON.

David F. Abell
DAVID F. ABELL

WISCONSIN REGISTERED LAND SURVEYOR, S-1596

ORDERED BY: JAMES BARR
5486 STATE ROAD "11"
ELKHORN, WI 53121

March 6, 2002

DATE: THIS IS NOT A CERTIFIED COPY UNLESS SEALED. JOB NUMBER - 02026A

FD 2-4E FA 13-1

216-4448