


1140 SEQUOIA STREET • DELAVAN, WISCONSIN 53115
262-728-6737

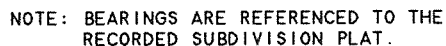

SCALE 1" = 30'

LEGEND

- ♂ -IRON PIPE FOUND
 ○ -1" DIA. IRON PIPE SET
 △ -UTILITY POLE
 □ -UTILITY PED.
 ——— -OVERHEAD UTILITY LINES
 (——— -GUY WIRE
 ▲ -T. V. ANTENNA
 CS -CONCRETE STOOP
 BE -BASEMENT ENTRY
 ——— -CHAINLINK FENCE
 () -RECORDED AS

LOTS 1 AND 2, BLOCK 16, DELMAR SUBDIVISION,
LOCATED IN T2N, R16E, WALWORTH COUNTY,
WISCONSIN.

I HEREBY CERTIFY THAT I HAVE SURVEYED THE ABOVE DESCRIBED PROPERTY AND THAT THE ABOVE MAP IS A TRUE REPRESENTATION THEREOF AND SHOWS THE SIZE AND LOCATION OF THE PROPERTY, ITS EXTERIOR BOUNDARIES, THE LOCATION OF ALL VISIBLE STRUCTURES AND DIMENSIONS OF ALL PRINCIPAL BUILDINGS THEREON, BOUNDARY FENCES, APPARENT EASEMENTS, ROADWAYS AND VISIBLE ENCROACHMENTS, IF ANY, TO THE BEST OF MY KNOWLEDGE AND BELIEF.

THIS SURVEY IS MADE FOR THE USE OF THE PRESENT OWNERS OF THE PROPERTY, AND ALSO THOSE WHO PURCHASE, MORTGAGE, OR GUARANTEE THE TITLE THERETO WITHIN ONE (1) YEAR FROM DATE HEREON.

DAVID F. ABELL
WISCONSIN REGISTERED LAND SURVEYOR, S-1596

ORDERED BY: PATTY YEAGER
268 READ STREET
FONTANA, WI 53125

March 21, 2007

DATE _____ JOB NUMBER - 94079A
NOTE: THIS IS NOT A CERTIFIED COPY UNLESS SEALED.

FDM -70

216-4459