


FARRIS, HANSEN & ASSOC. INC.

7 RIDGWAY COURT- P.O. BOX 437
ELKHORN, WISCONSIN 53121
PHONE (262) 723-2098
FAX (262) 723-5886


ORDERED BY: JVK CONSTRUCTION
9117 DUSK DRIVE
ELKHORN, WI. 53121

PLAT OF SURVEY

LOTS 1 THRU 4, BLOCK 10
SOUTH SHORE MANOR
LOCATED IN SEC. 32, T2N, R16E
WALWORTH COUNTY, WI.



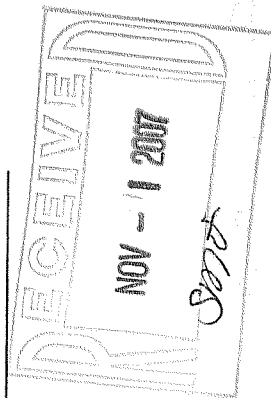


LEGEND
● = FOUND IRON REBAR STAKE
(XXX) = RECORDED AS

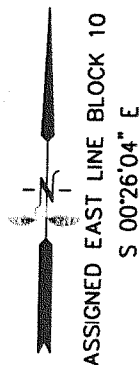

NOTE: TITLE COMMITMENT
SEWT-61264 HAS THIS PARCEL
UNDER 2 TAX KEY NO.'S. COUNTY
RECORDS SHOW THIS AS 1 TAX
PARCEL (FSS1 00014).

SAN. EASEMENT DOC. 661780
ALLOWS FOR SAN. SEWER TO BE
RUN AND MAINTAINED IN STREETS,
DRIVES, AND OTHER ROW'S.

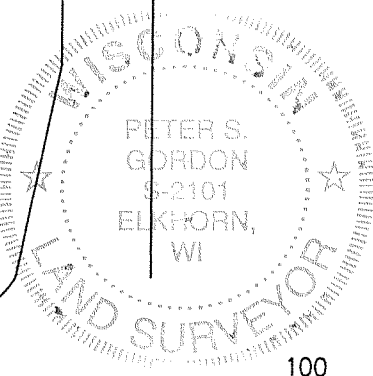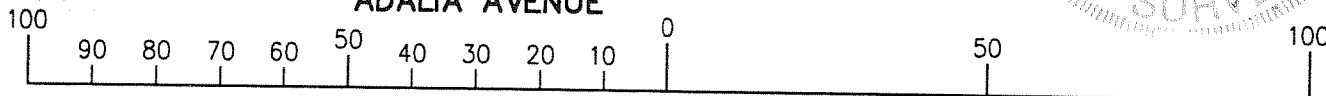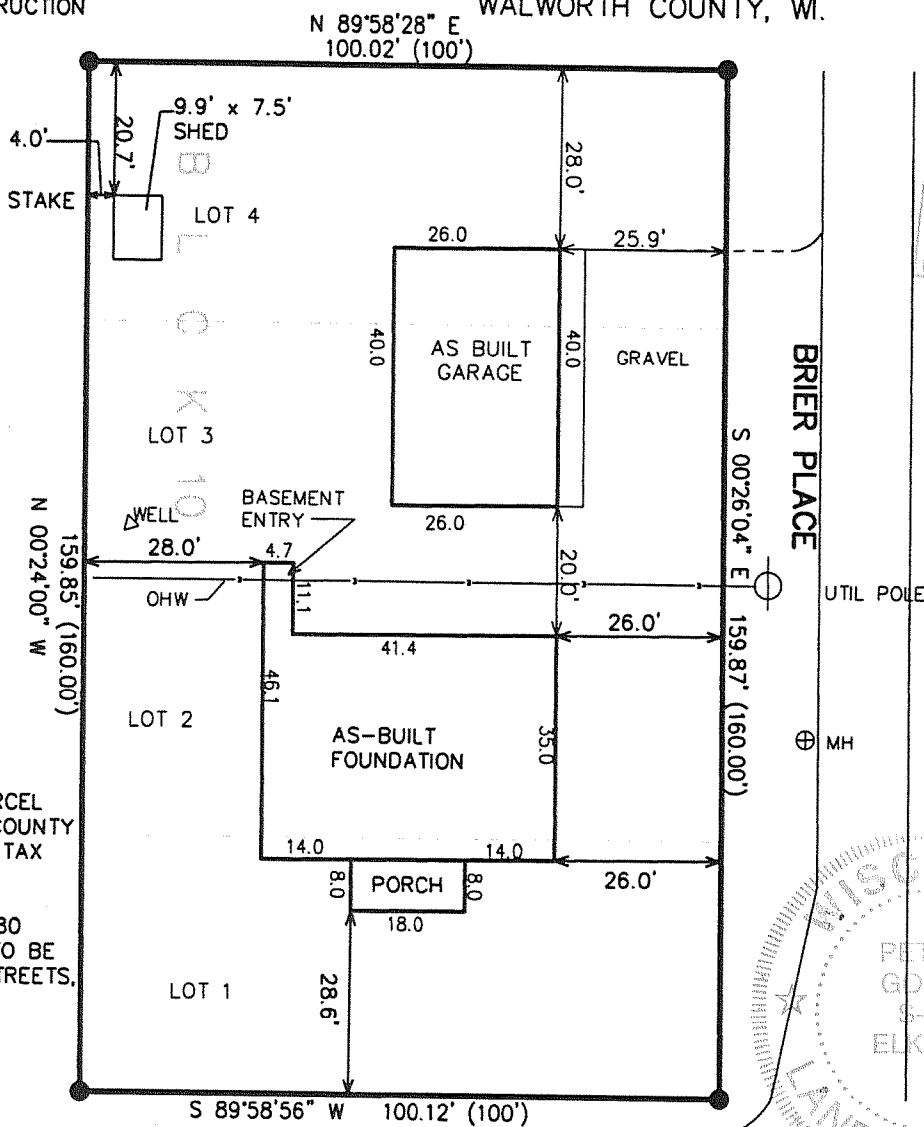

NOTE: COPIES OF THIS MAP TO WHICH THE FOLLOWING CERTIFICATE WILL APPLY SHOW SURVEYOR'S ORIGINAL
SEAL AND SIGNATURE IN RED INK. COPIES BY ANY OTHER MEANS MAY HAVE ALTERATIONS WHICH DO NOT
REPRESENT THE SURVEYOR'S WORK PRODUCT.

I HEREBY CERTIFY THAT THE ABOVE DESCRIBED PROPERTY HAS BEEN SURVEYED UNDER MY DIRECTION AND THAT
THE ABOVE MAP IS A TRUE REPRESENTATION THEREOF AND SHOWS THE SIZE AND LOCATION OF THE PROPERTY, ITS
EXTERIOR BOUNDARIES, THE LOCATION OF ALL VISIBLE STRUCTURES, AND DIMENSIONS OF ALL PRINCIPLE
BUILDINGS THEREON, BOUNDARY FENCES, APPARENT EASEMENTS, ROADWAYS, AND VISIBLE ENCROACHMENTS, IF
ANY. THIS SURVEY IS MADE FOR THE USE OF THE PRESENT OWNERS OF THE PROPERTY, AND ALSO THOSE WHO
PURCHASE, MORTGAGE, OR GUARANTEE THE TITLE THERETO WITHIN ONE YEAR FROM THE DATE HEREOF.

DATED: JUNE 13, 2007

REVISED: 7/11/2007-KB
TO SHOW SIZE & LOCATION OF
AS-BUILT FOUNDATION

09-21-2007
UPDATE TO TITLE SPEC'S

PROJECT NO. 7340
DATED: 06-13-2007
SHEET 1 OF 1 SHEETS

Peter S. Gordon
PETER S. GORDON R.L.S. 2101

SEP 21 2007 FSSI-14 FSSI-15

216-4472