

PLAT OF SURVEY

FARRIS, HANSEN & ASSOCIATES, INC.
ENGINEERING — ARCHITECTURE — SURVEYING
7 RIDGWAY COURT P.O. BOX 437
ELKHORN, WISCONSIN 53121
OFFICE: (262) 723-2098 FAX: (262) 723-5886

PROJECT NO.	7123
DATE	06/07/2007
SHEET NO.	1 OF 1

LOT 3 OF THE ADDITION TO
WILLOW HUNT PARK, ACCORDING
TO THE RECORDED PLAT THEREOF,
EXCEPTING THEREFROM A PARCEL
OF LAND DESCRIBED AS FOLLOWS:
BEGINNING AT THE SOUTHEAST CORNER
OF SAID LOT 3 AND RUNNING SOUTH-
WESTERLY ALONG THE SOUTH LINE
OF SAID LOT, 64 FEET TO A POINT, THENCE
RUNNING NORTHWESTERLY TO THE NORTH-
EAST CORNER OF SAID LOT 3; THENCE
SOUTHEASTERLY ALONG THE EAST LINE
OF SAID LOT 3 TO THE POINT OF BEGINNING,
SAID LAND BEING IN THE TOWN OF DELAVAN,
MILWAUKEE COUNTY, WISCONSIN.

SUBJECT TO: MUNICIPAL AND ZONING ORDINANCES,
AND ORDINANCES OF THE BOARD OF PUBLIC UTILITIES
LOCATED ADJACENT TO SIDE AND REAR LOT LINES,
RECORDED BUILDING AND USE RESTRICTIONS AND
THE GENERAL ORDINANCES FOR THE YEARS 1978 AND
SUBSEQUENT YEARS, EASEMENT GRANTED DELAVAN LAKE
SANITARY DISTRICT FOR INSTALLATION OF SEWER SYSTEM
IN THE DELAVAN LAKE AREA, SPECIAL ASSESSMENT LEVEL
OF SAID DISTRICT.



- ```

: = SET NAIL
): = FOUND IRON PIPE STAKE
): = FOUND IRON REBAR STAKE
}| = SET LANDSCAPE SPIKE IN CONCRETE MONUMENT
^ = EXISTING GEAR SPIKE
xxx| = RECORDED AS

```

NOTE: COPIES OF THIS MAP TO WHICH THE FOLLOWING CERTIFICATE  
WILL APPLY SHOW THE SURVEYOR'S ORIGINAL SEAL AND SIGNATURE  
IN RED INK. COPIES BY ANY OTHER MEANS MAY HAVE ALTERATIONS  
WHICH DO NOT REPRESENT THE SURVEYOR'S WORK PRODUCT.


I HEREBY CERTIFY THAT THE ABOVE DESCRIBED PROPERTY HAS BEEN SURVEYED UNDER MY DIRECTION AND THAT THE ABOVE MAP IS A TRUE REPRESENTATION THEREOF AND SHOWS THE SIZE AND LOCATION OF THE PROPERTY AND ITS EXTERIOR BOUNDARIES. THIS SURVEY IS MADE FOR THE USE OF THE PRESENT OWNERS OF THE PROPERTY, AND ALSO THOSE WHO PURCHASE, MORTGAGE, OR GUARANTEE THE TITLE THERETO WITHIN ONE YEAR FROM THE DATE HEREOF.

DATED: JUNE 7, 2007

REVISED 09-12-2007  
TO SHOW SIZE & LOCATION OF  
AS BUILT FOUNDATION

PETER S. GORDON R.L.S. 2101

\_\_\_\_\_

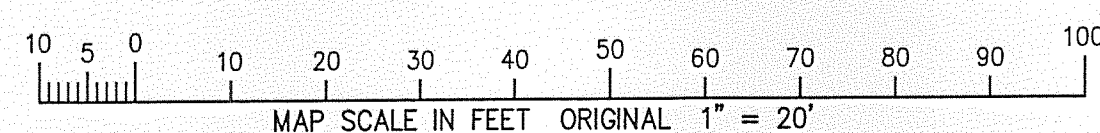

FWIA - 3

216-4479