

# LAND-MARK SURVEYING

Mark L. Miritz



Wisconsin Registered Land Surveyor S-2582

N9330 Knuteson Drive  
Whitewater, WI 53190  
Phone: (262) 495-3284  
FAX : (262) 495-8421  
LAND-MARKSURVEYING.COM

## PLAT OF SURVEY

THAT PORTION BELROCK SUBDIVISION LOCATED SOUTHERLY  
AND EASTERLY OF SOUTH SHORE DRIVE, LOCATED IN THE  
NORTHWEST 1/4 OF SECTION 27, TOWN 2 NORTH, RANGE 16  
EAST, DELAVAN TOWNSHIP, WALWORTH COUNTY, WISCONSIN.

OWNERS: BELROCK PARK, INC.  
C/O DAVID EVERHART  
2375 SOUTH SHORE DRIVE  
DELAVAN, WI 53115

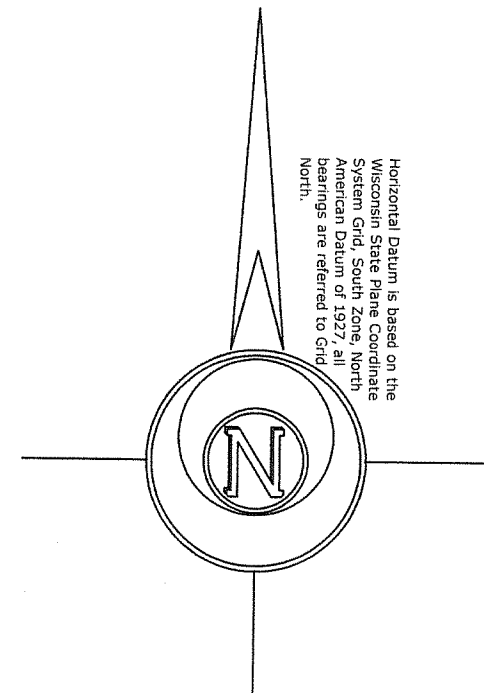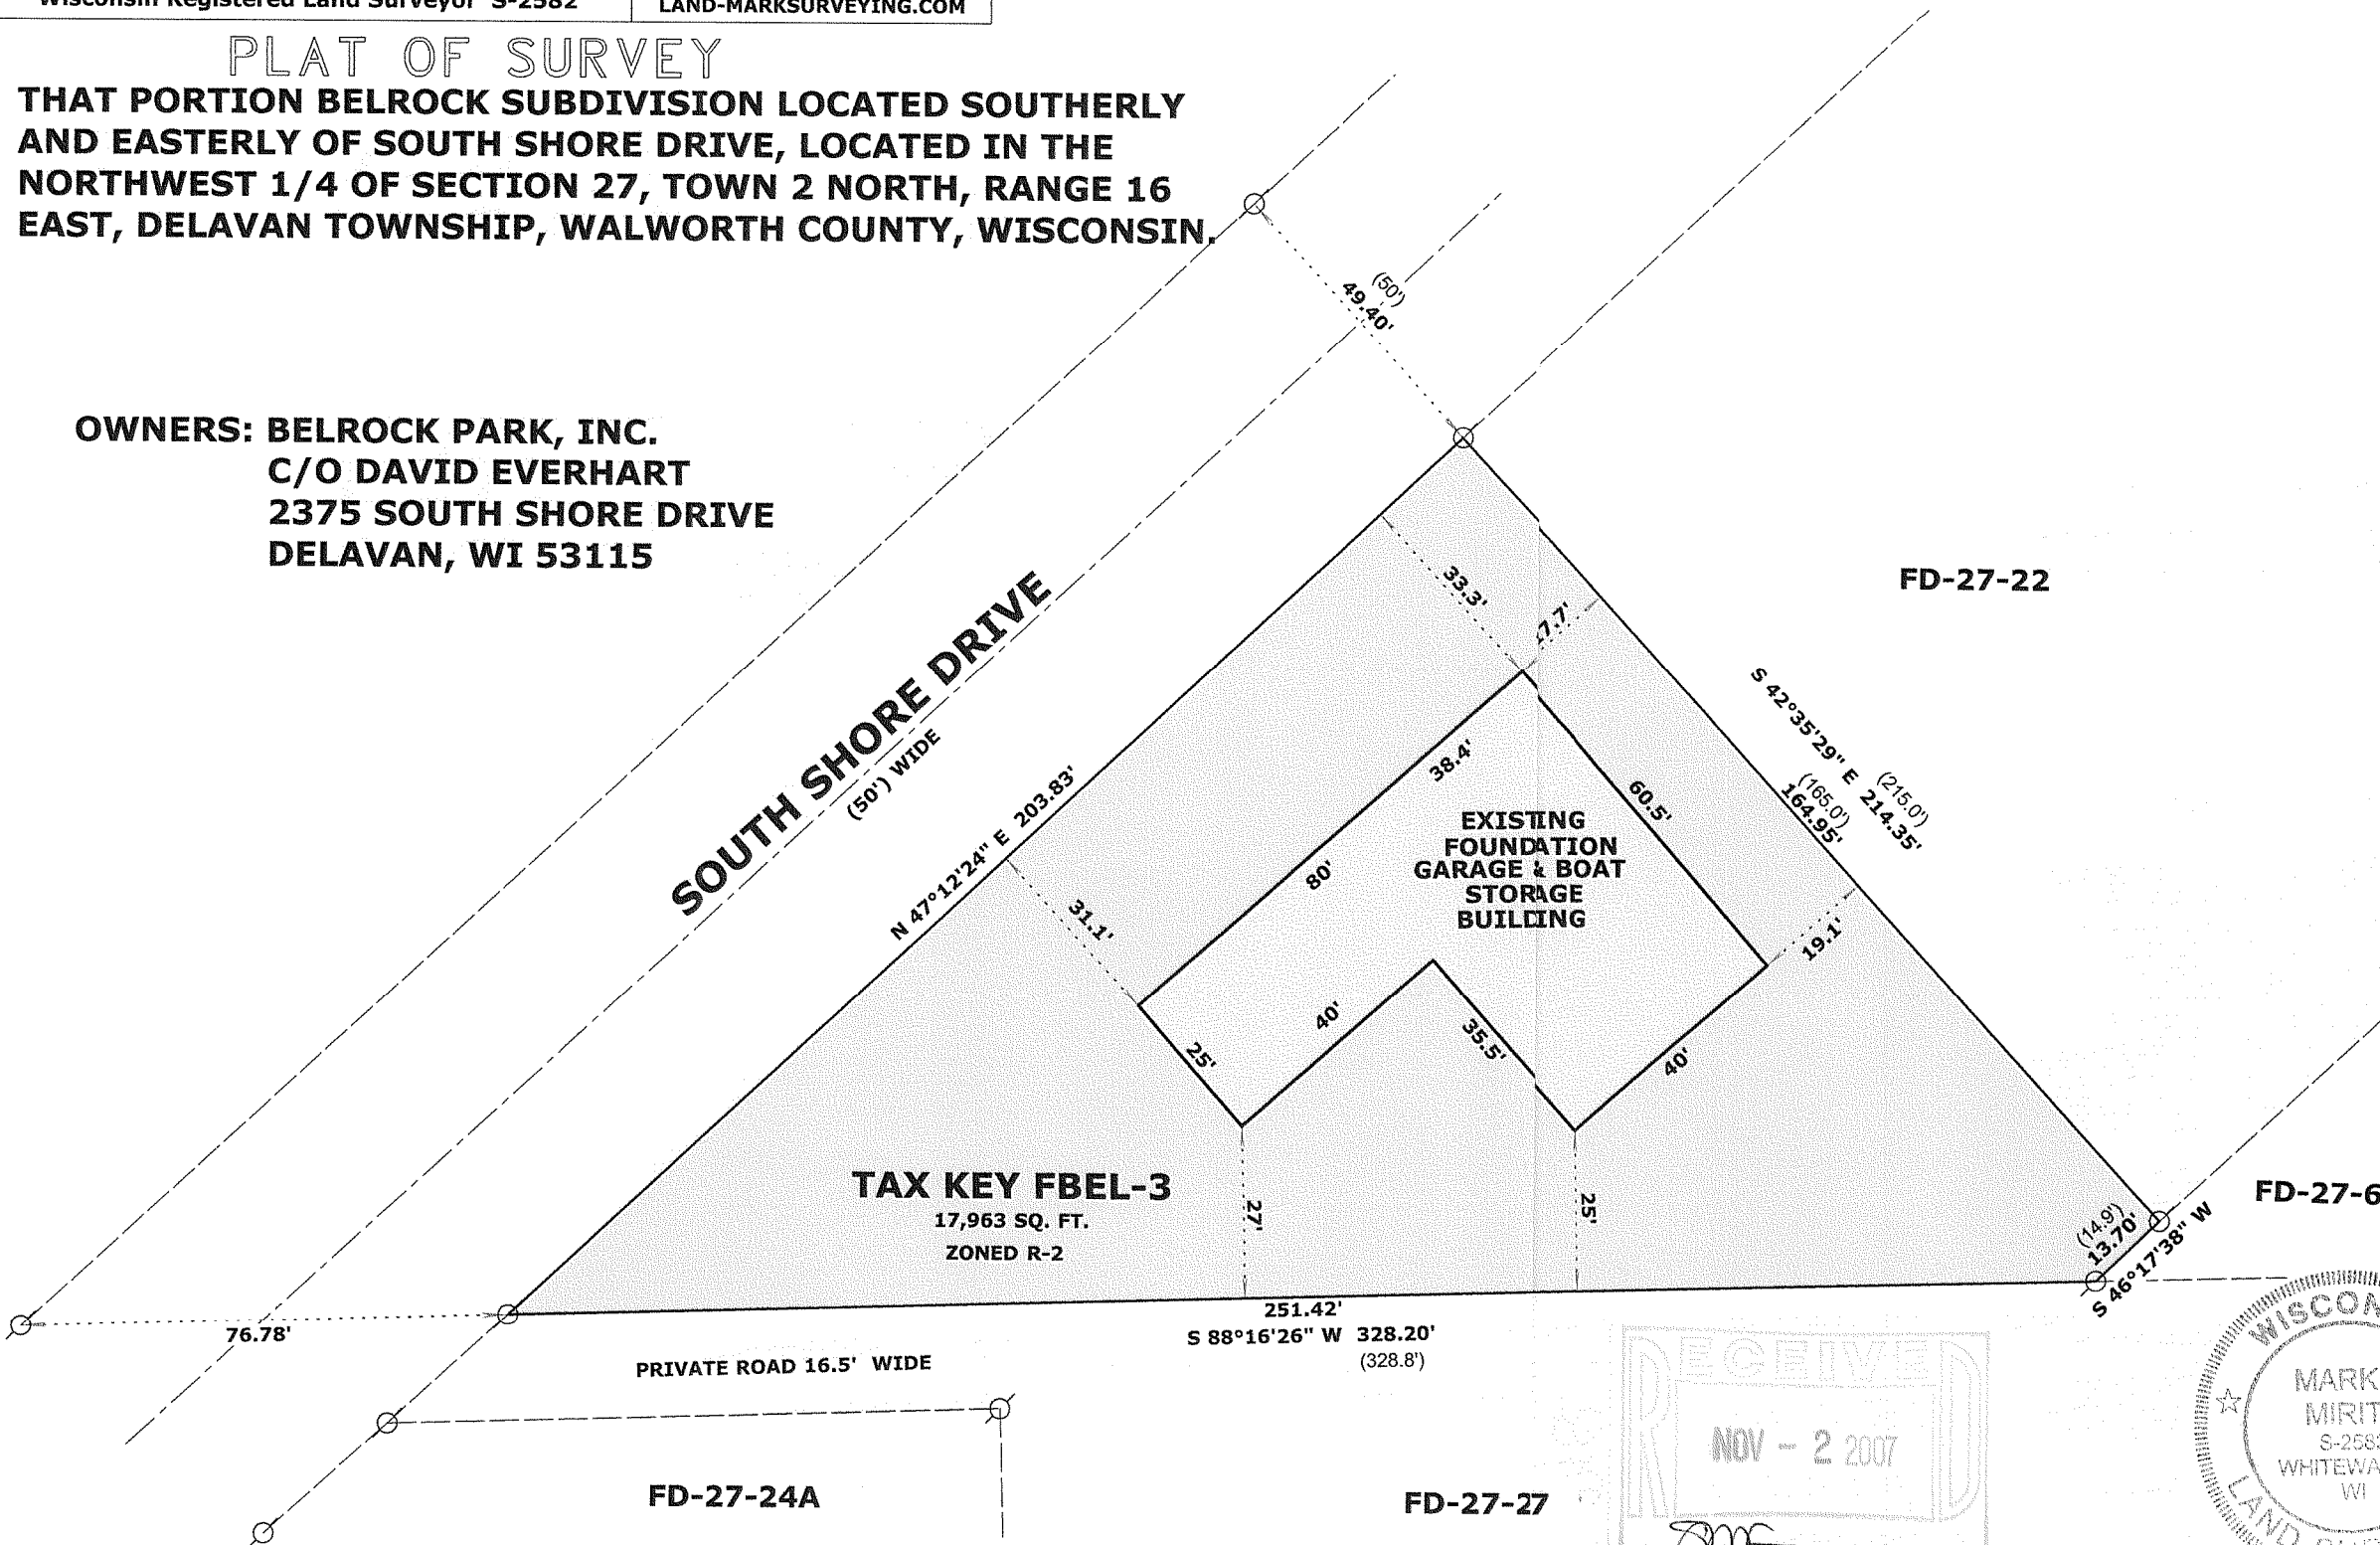

Horizontal Datum is based on the Wisconsin State Plane Coordinate System Gnd. South Zone, North American Datum of 1927, all bearings are referred to Grid North.

## LEGEND

- FOUND IRON PIPE
- FOUND IRON ROD
- ⊗ FOUND COUNTY MONUMENT
- FOUND CONCRETE MONUMENT
- + CHISEL CUT IN CONCRETE
- SET IRON ROD, 24" LONG, WEIGHING 1.5 LBS./LINEAL FT., 3/4" DIA.
- ( x x ) RECORDED AS DIMENSION
- X-X- EXISTING FENCE

SCALE: 1" = 30 FEET

"I hereby certify that the above described property has been surveyed by me or under my direction and that the above map is a true representation thereof and shows the size and location of the property, its exterior boundaries, the location of all visible structures and dimensions of all principal buildings thereon, boundary fences, apparent easements, roadways and visible encroachments, if any."

"This survey is made for the use of the present owners of the property, and also those who purchase, mortgage, or guarantee the title thereto within one year from date hereof."

*Mark L. Miritz*  
MARK L. MIRITZ  
WISCONSIN REGISTERED  
LAND SURVEYOR S-2582

REVISED JULY 23, 2006 TO SHOW PROPOSED BUILDING  
REVISED OCT. 31, 2007 TO SHOW FOUNDATION "AS BUILT"

DATE: SEPT. 24, 2005 JOB NO. 05.819

216-4482

FBEL-3