


ABELL SURVEYING & MAPPING

1140 SEQUOIA STREET • DELAVAN, WISCONSIN 53115
414-728-6737

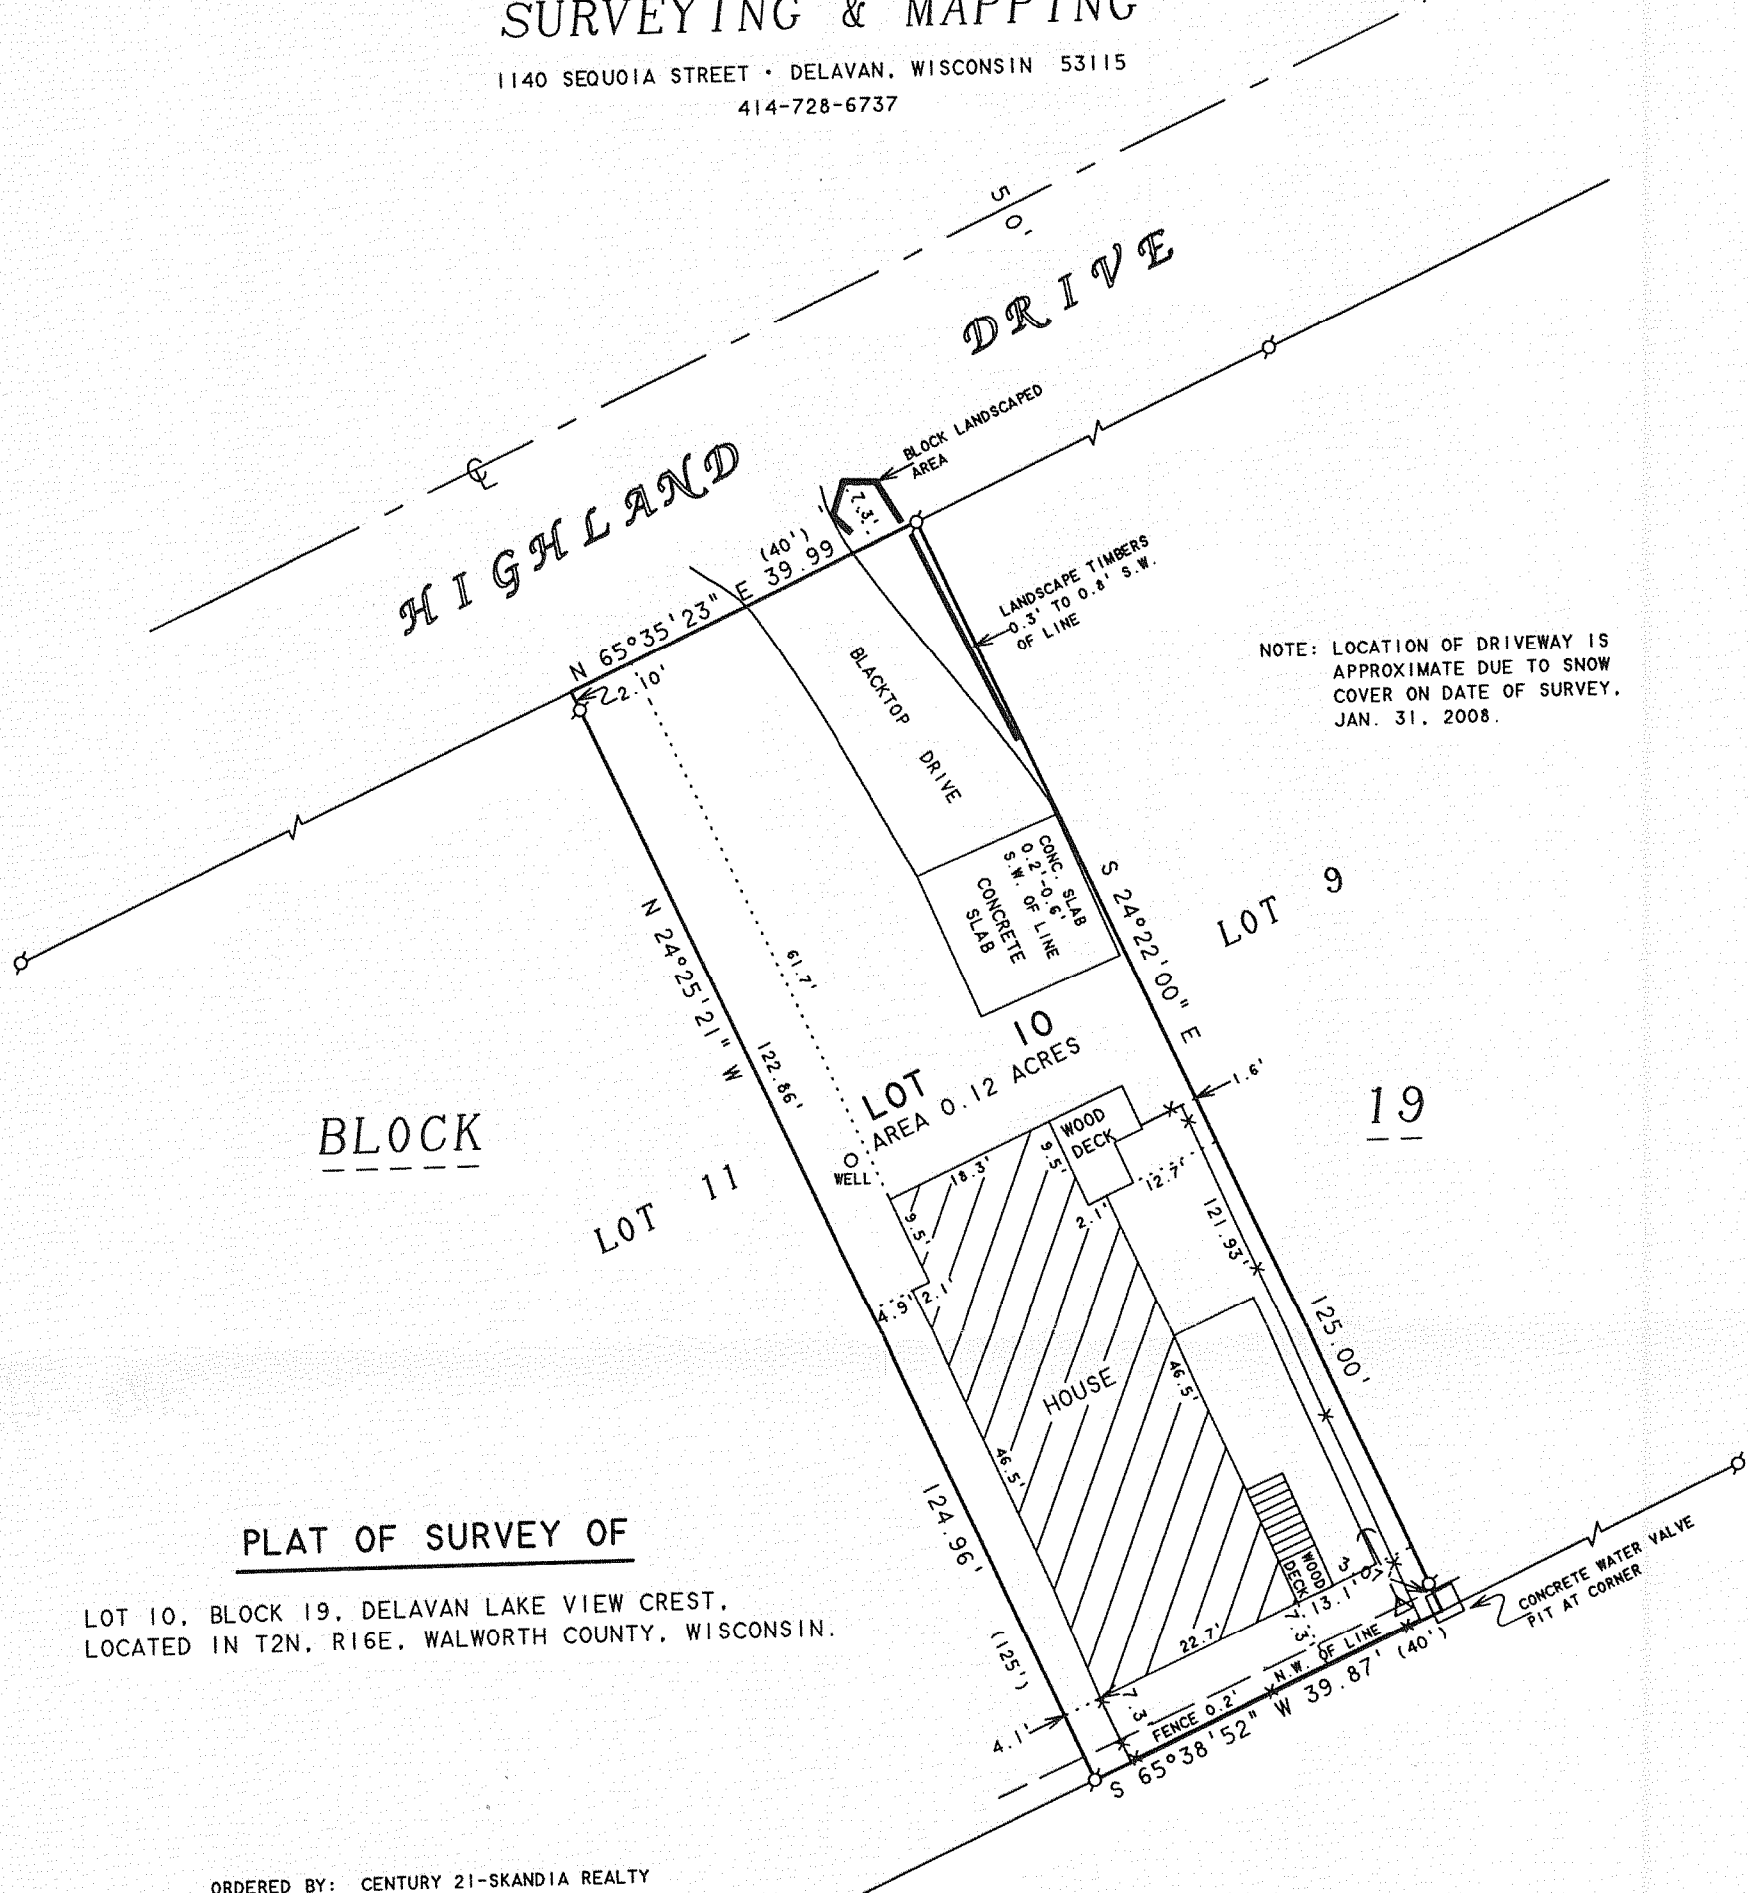

REVISED AND RECERTIFIED FEBRUARY 4, 2008
ORDERED BY: SHOREWEST REALTORS
623 MAIN STREET
LAKE GENEVA, WI 53147