


ABELL
SURVEYING & MAPPING
1140 SEQUOIA STREET • DELAVAN, WISCONSIN 53115
262-728-6737

PLAT OF SURVEY OF

LOTS 7-12, BLOCK 1, ROBBINS
SUBDIVISION, LOCATED IN T2N,
R16E, TOWN OF DELAVAN, WALWORTH
COUNTY, WISCONSIN.
CONTAINING 0.31 ACRES.

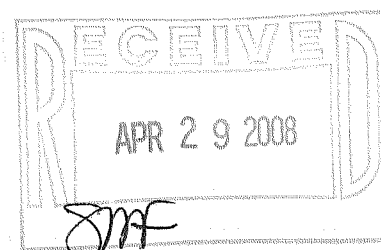

N




SCALE 1"=20'

LEGEND

- - IRON PIPE FOUND
- - IRON ROD FOUND
- - IRON PIPE SET
- - UTILITY PEDS
- △ - UTILITY POLE
- - OVERHEAD UTILITY LINES
- CP - CONCRETE STOOP
- () - RECORDED AS

ORDERED BY: TED GAMRAT
4376 LOMBARDY LAND
HOFFMAN ESTATES, IL 60192

BENNETT STREET

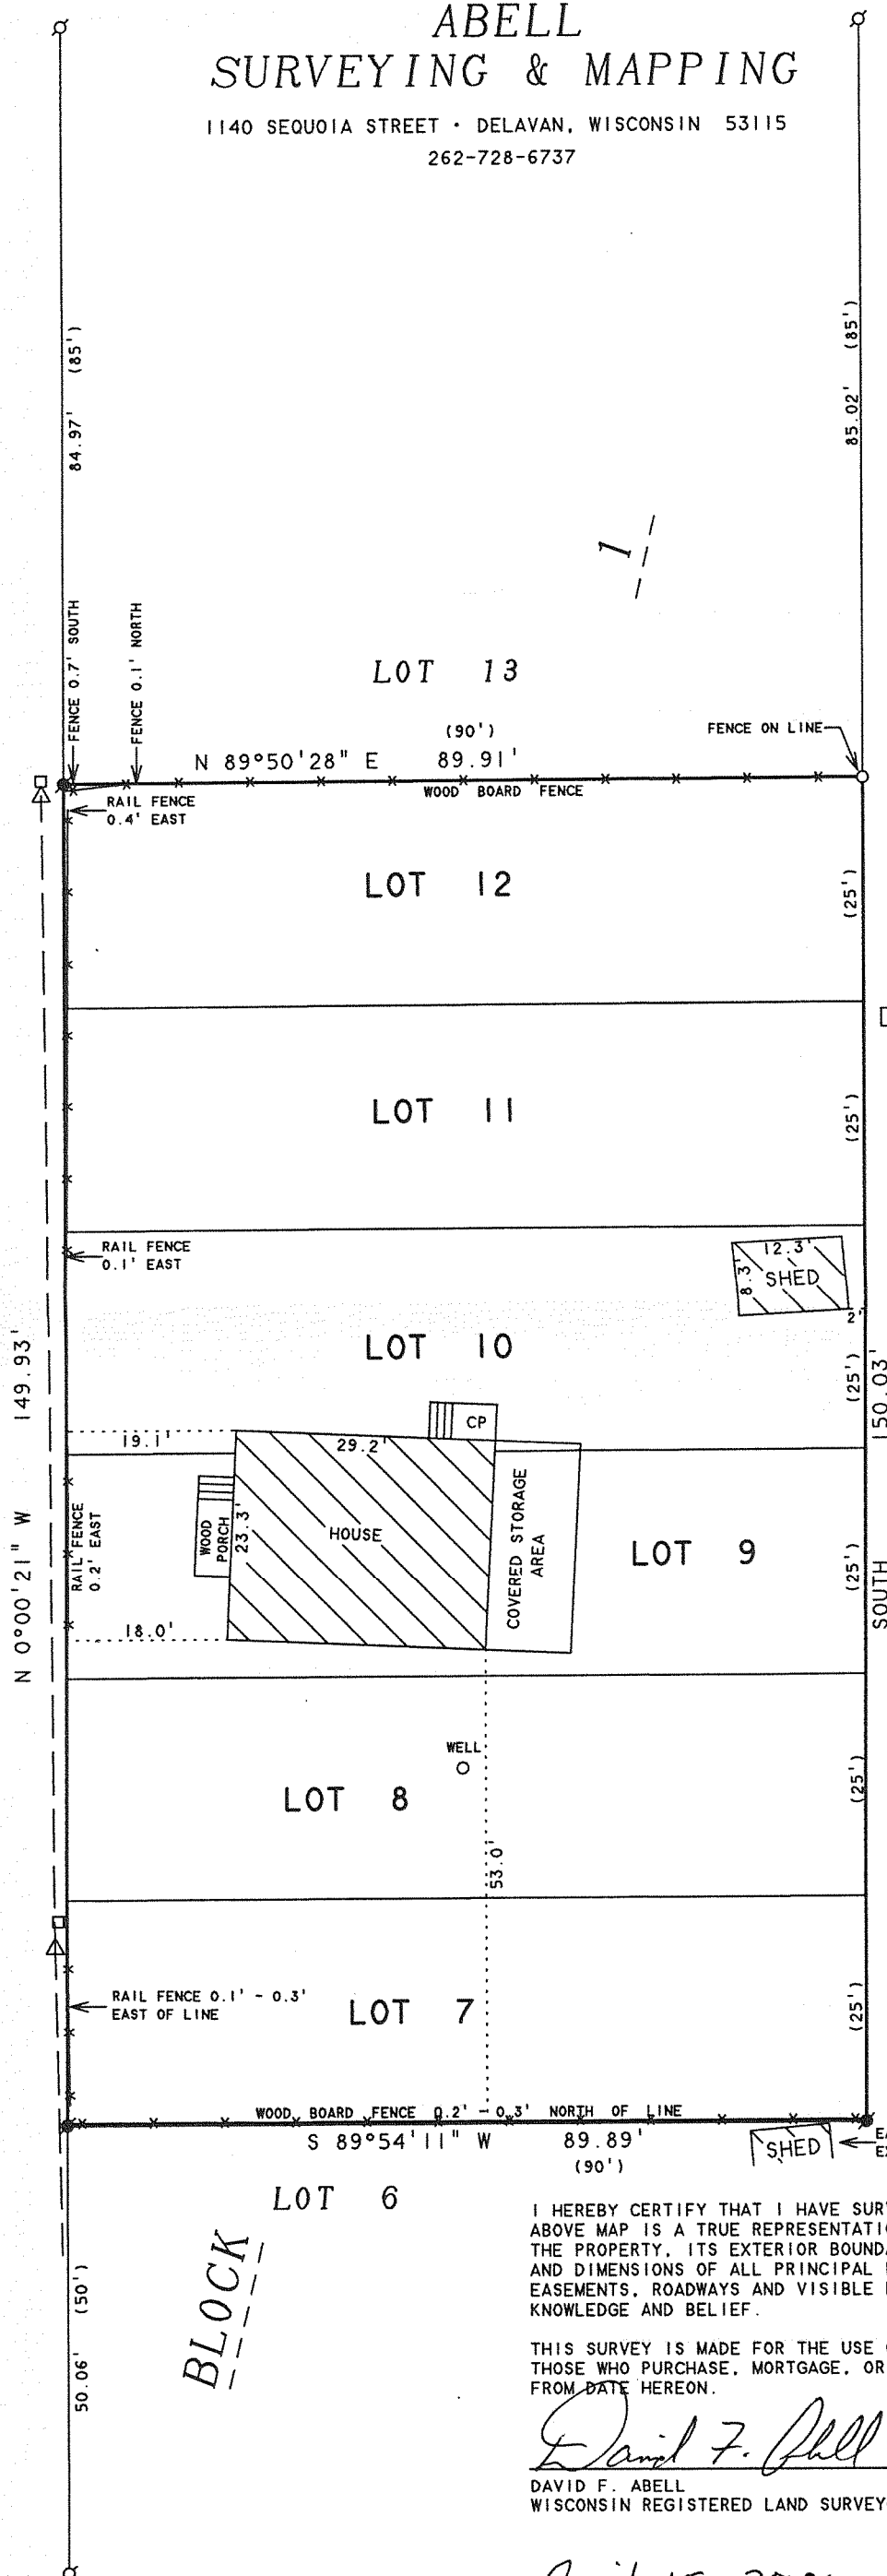

I HEREBY CERTIFY THAT I HAVE SURVEYED THE ABOVE DESCRIBED PROPERTY AND THAT THE ABOVE MAP IS A TRUE REPRESENTATION THEREOF AND SHOWS THE SIZE AND LOCATION OF THE PROPERTY, ITS EXTERIOR BOUNDARIES, THE LOCATION OF ALL VISIBLE STRUCTURES AND DIMENSIONS OF ALL PRINCIPAL BUILDINGS THEREON, BOUNDARY FENCES, APPARENT EASEMENTS, ROADWAYS AND VISIBLE ENCROACHMENTS, IF ANY, TO THE BEST OF MY KNOWLEDGE AND BELIEF.

THIS SURVEY IS MADE FOR THE USE OF THE PRESENT OWNERS OF THE PROPERTY, AND ALSO THOSE WHO PURCHASE, MORTGAGE, OR GUARANTEE THE TITLE THERETO WITHIN ONE (1) YEAR FROM DATE HEREON.

David F. Abell
DAVID F. ABELL
WISCONSIN REGISTERED LAND SURVEYOR, S-1596

April 15, 2008
DATE

JOB NUMBER - 89111A

NOTE: THIS IS NOT A CERTIFIED COPY UNLESS SEALED.