

FARRIS, HANSEN & ASSOCIATES, INC.




ENGINEERING — ARCHITECTURE — SURVEYING
7 RIDGWAY COURT — P.O. BOX 437 — ELKHORN, WISCONSIN 53121
PHONE: (262) 723-2098 FAX: (262) 723-5886

PLAT OF SURVEY

LOTS 6 & 7, AND 36 & 37 OF THE FLEMING ADDITION
LOCATED IN THE TOWN OF DELAVAN, WALWORTH COUNTY,
WISCONSIN

— WORK ORDERED BY —
RAYMOND FERRARA
1609 BECKMAN DRIVE
DELAVAN, WI 53115

S. LINE OF BECKMAN DRIVE
BEARS S 89°58'00" E
PER EXISTING SURVEY RECORDS

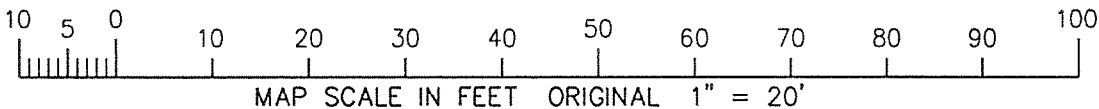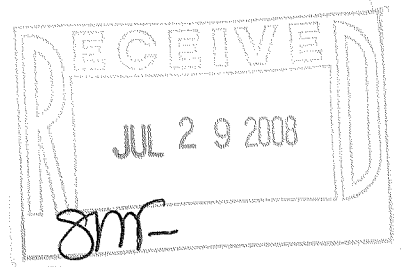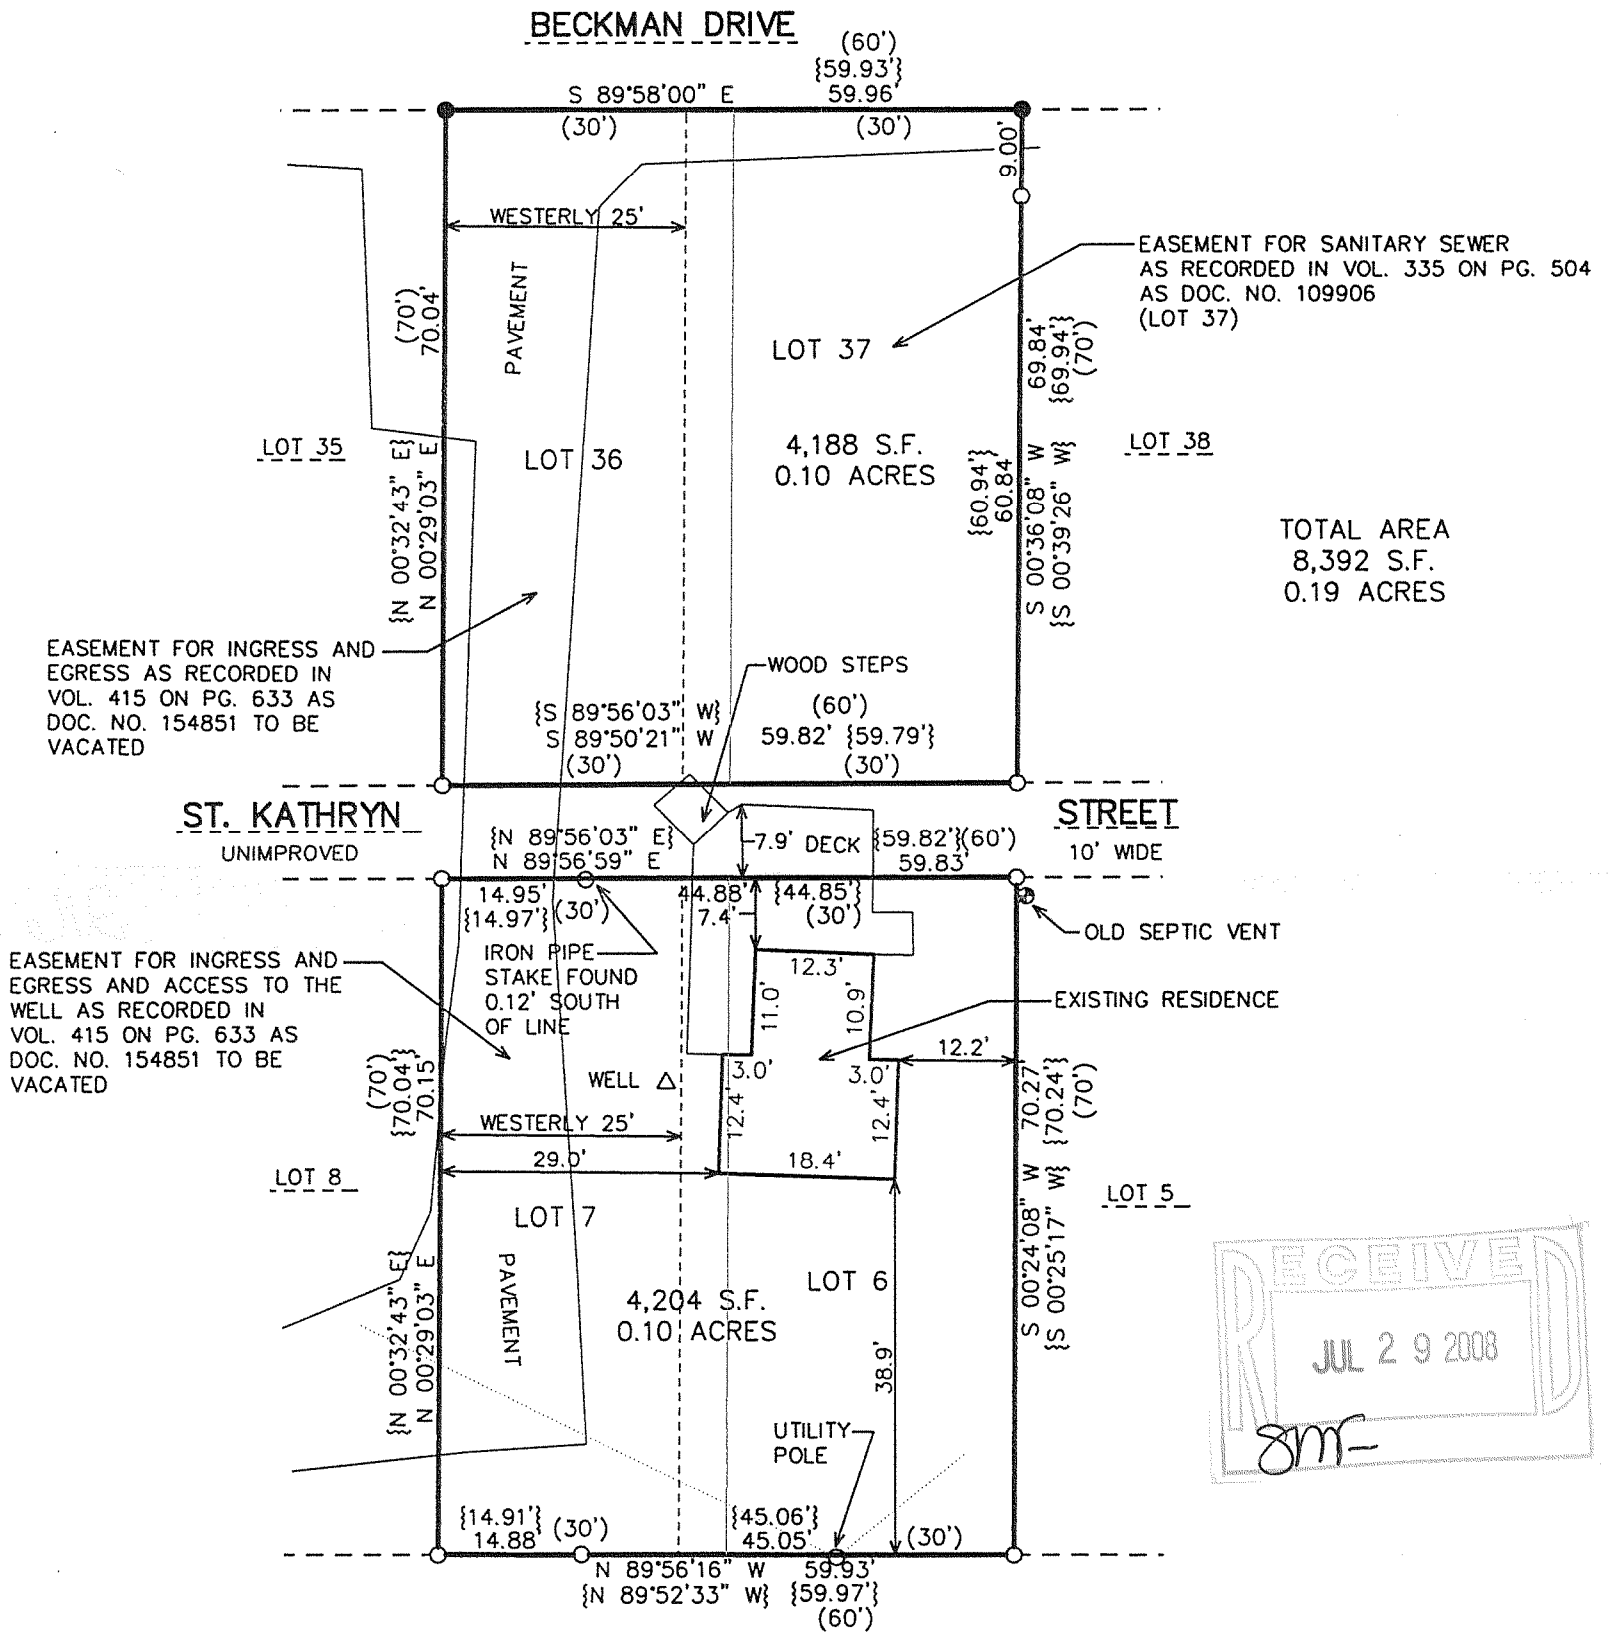

NOTE: COPIES OF THIS MAP TO WHICH THE FOLLOWING CERTIFICATE
WILL APPLY SHOW THE SURVEYOR'S ORIGINAL SEAL AND SIGNATURE
IN RED INK. COPIES BY ANY OTHER MEANS MAY HAVE ALTERATIONS
WHICH DO NOT REPRESENT THE SURVEYOR'S WORK PRODUCT.

I HEREBY CERTIFY THAT THE ABOVE DESCRIBED PROPERTY HAS BEEN
SURVEYED UNDER MY DIRECTION AND THAT THE ABOVE MAP IS A TRUE
REPRESENTATION THEREOF AND SHOWS THE SIZE AND LOCATION OF
THE PROPERTY AND ITS EXTERIOR BOUNDARIES. THIS SURVEY IS
MADE FOR THE USE OF THE PRESENT OWNERS OF THE PROPERTY, AND
ALSO THOSE WHO PURCHASE, MORTGAGE, OR GUARANTEE THE TITLE
THERETO WITHIN ONE YEAR FROM THE DATE HEREOF.

DATED: JUNE 18, 2008

PETER S. GORDON R.L.S. 2101

LEGEND

- = FOUND IRON PIPE STAKE
- = SET "PK" NAIL IN PAVEMENT
- (XXX) = RECORDED AS ON ORIGINAL PLAT
- {XXX} = RECORDED AS PREVIOUSLY SURVEYED

PROJECT: 7659
DATE: 6/8/2008
SHEET 1 OF 1

6/18/2008 X:\Projects\7659\Drawings\SURVEY_20080618

JUN 18 2008 FFA-5

216-4550