


ABELL
SURVEYING & MAPPING
1140 SEQUOIA STREET • DELAVAN, WISCONSIN 53115
262-728-6737

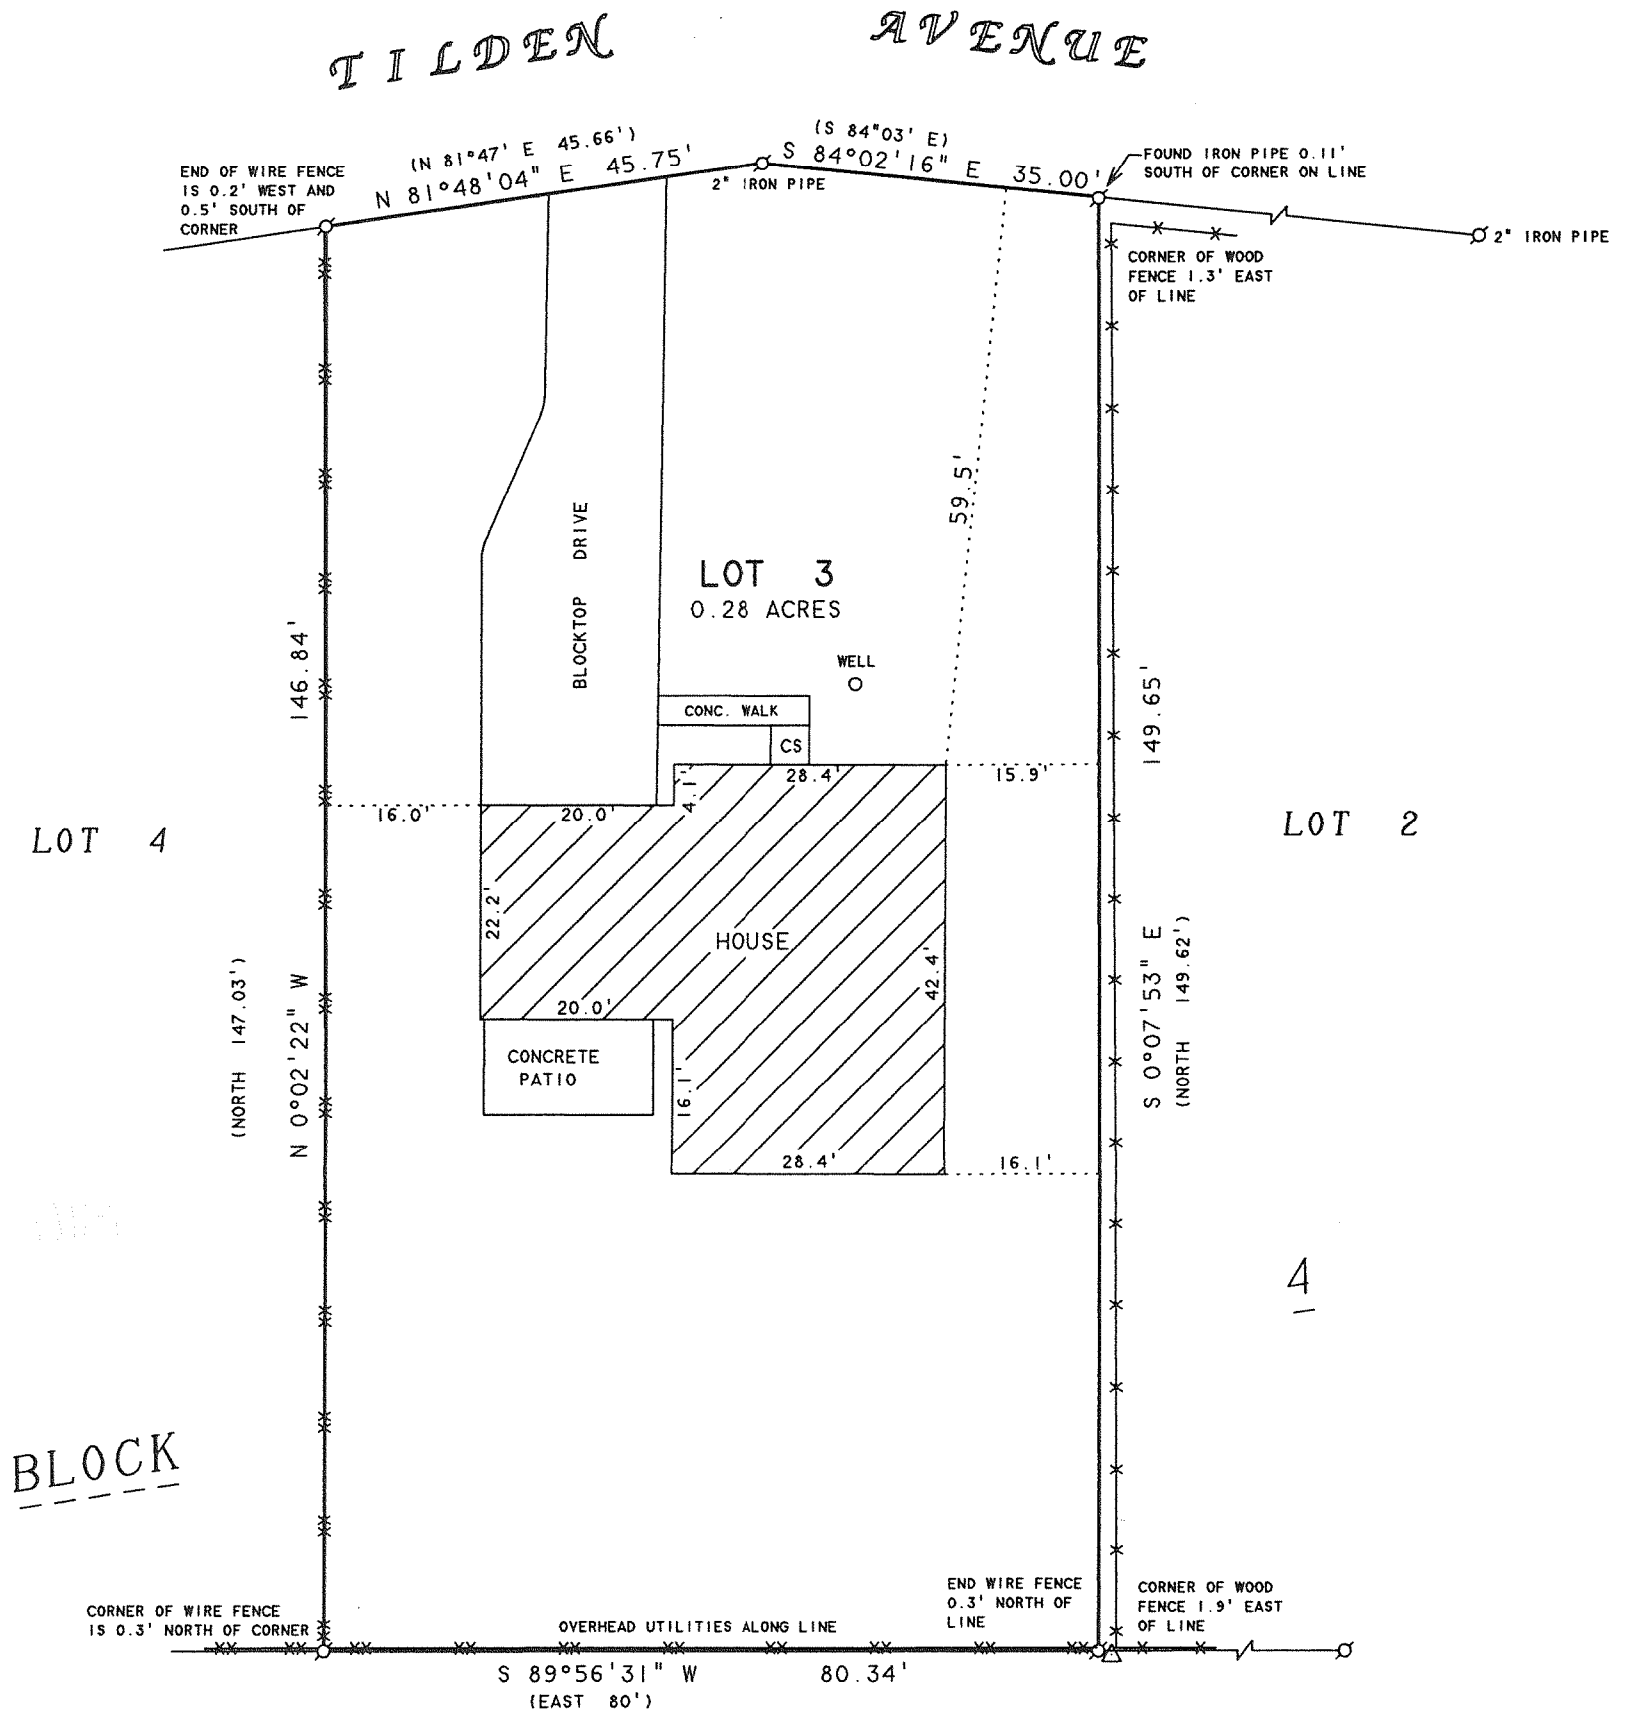


PLAT OF SURVEY OF

BEARINGS ARE REFERENCED TO THE
RECORDED SUBDIVISION PLAT.

LOT 3, BLOCK 4, DELMAR SUBDIVISION, T2N, R16E,
WALWORTH COUNTY, WISCONSIN.


NOTE: LOT 3, BLOCK 4 AS PLATTED
CLOSES 0.31 FEET OR 1 PART
IN 1487.

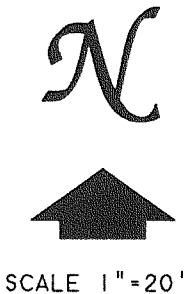

SCALE 1"=20'

LEGEND

- - IRON PIPE FOUND
- △ - UTILITY POLE
- WIRE FENCE
- x-x- WOOD FENCE
- CS - CONCRETE STOOP
- () - RECORDED AS

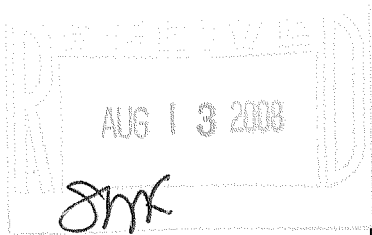

ORDERED BY: CENTURY 21-SKANDIA REALTY
830 E. GENEVA STREET
DELAVAN, WI 53115

I HEREBY CERTIFY THAT I HAVE SURVEYED THE ABOVE DESCRIBED PROPERTY AND THAT THE ABOVE MAP IS A TRUE REPRESENTATION THEREOF AND SHOWS THE SIZE AND LOCATION OF THE PROPERTY, ITS EXTERIOR BOUNDARIES, THE LOCATION OF ALL VISIBLE STRUCTURES AND DIMENSIONS OF ALL PRINCIPAL BUILDINGS THEREON, BOUNDARY FENCES, APPARENT EASEMENTS, ROADWAYS AND VISIBLE ENCROACHMENTS, IF ANY, TO THE BEST OF MY KNOWLEDGE AND BELIEF.

THIS SURVEY IS MADE FOR THE USE OF THE PRESENT OWNERS OF THE PROPERTY, AND ALSO THOSE WHO PURCHASE, MORTGAGE, OR GUARANTEE THE TITLE THERETO WITHIN ONE (1) YEAR FROM DATE HEREON.

David F. Abell

DAVID F. ABELL
WISCONSIN REGISTERED LAND SURVEYOR, S-1596

REVISED AND RECERTIFIED: MARCH 26, 2008

ORDERED BY: RANDY MARTIN
SHOREWEST REALTORS
830 E. GENEVA STREET
DELAVAN, WI 53115

December 8, 2003

DATE: JOB NUMBER -03171A
NOTE: THIS IS NOT A CERTIFIED COPY UNLESS SEALED.

FDM-22A

216-4504