

— WORK ORDERED BY —
J & J CONSTRUCTION
S35 W38226 DOLMAR PARK ROAD
DOUSMAN, WI. 53118

FARRIS, HANSEN & ASSOCIATES, INC.
ENGINEERING — ARCHITECTURE — SURVEYING
7 RIDGWAY COURT P.O. BOX 437
ELKHORN, WISCONSIN 53121
OFFICE: (262) 723-2098 FAX: (262) 723-5886

REVISIONS	

7518.08
DATE: 7/30/2008
SHEET NO. 1 OF 1



RECEIVED
NOV - 14 2008
S.M.

A circular seal for the Wisconsin Land Surveyor. The outer ring contains the text "WISCONSIN" at the top and "LAND SURVEYOR" at the bottom, separated by two five-pointed stars. The center of the seal contains the text "PETER S. GORDON", "S-2101", and "ELKHORN, WI" arranged vertically.


PETER S. GORDON R.L.S. 2101

216-4582

ASSIGNED NE LINE LOT 12
N 32°03' 00" W

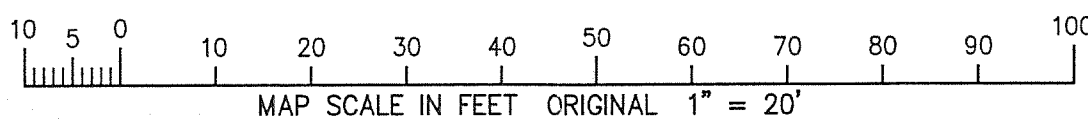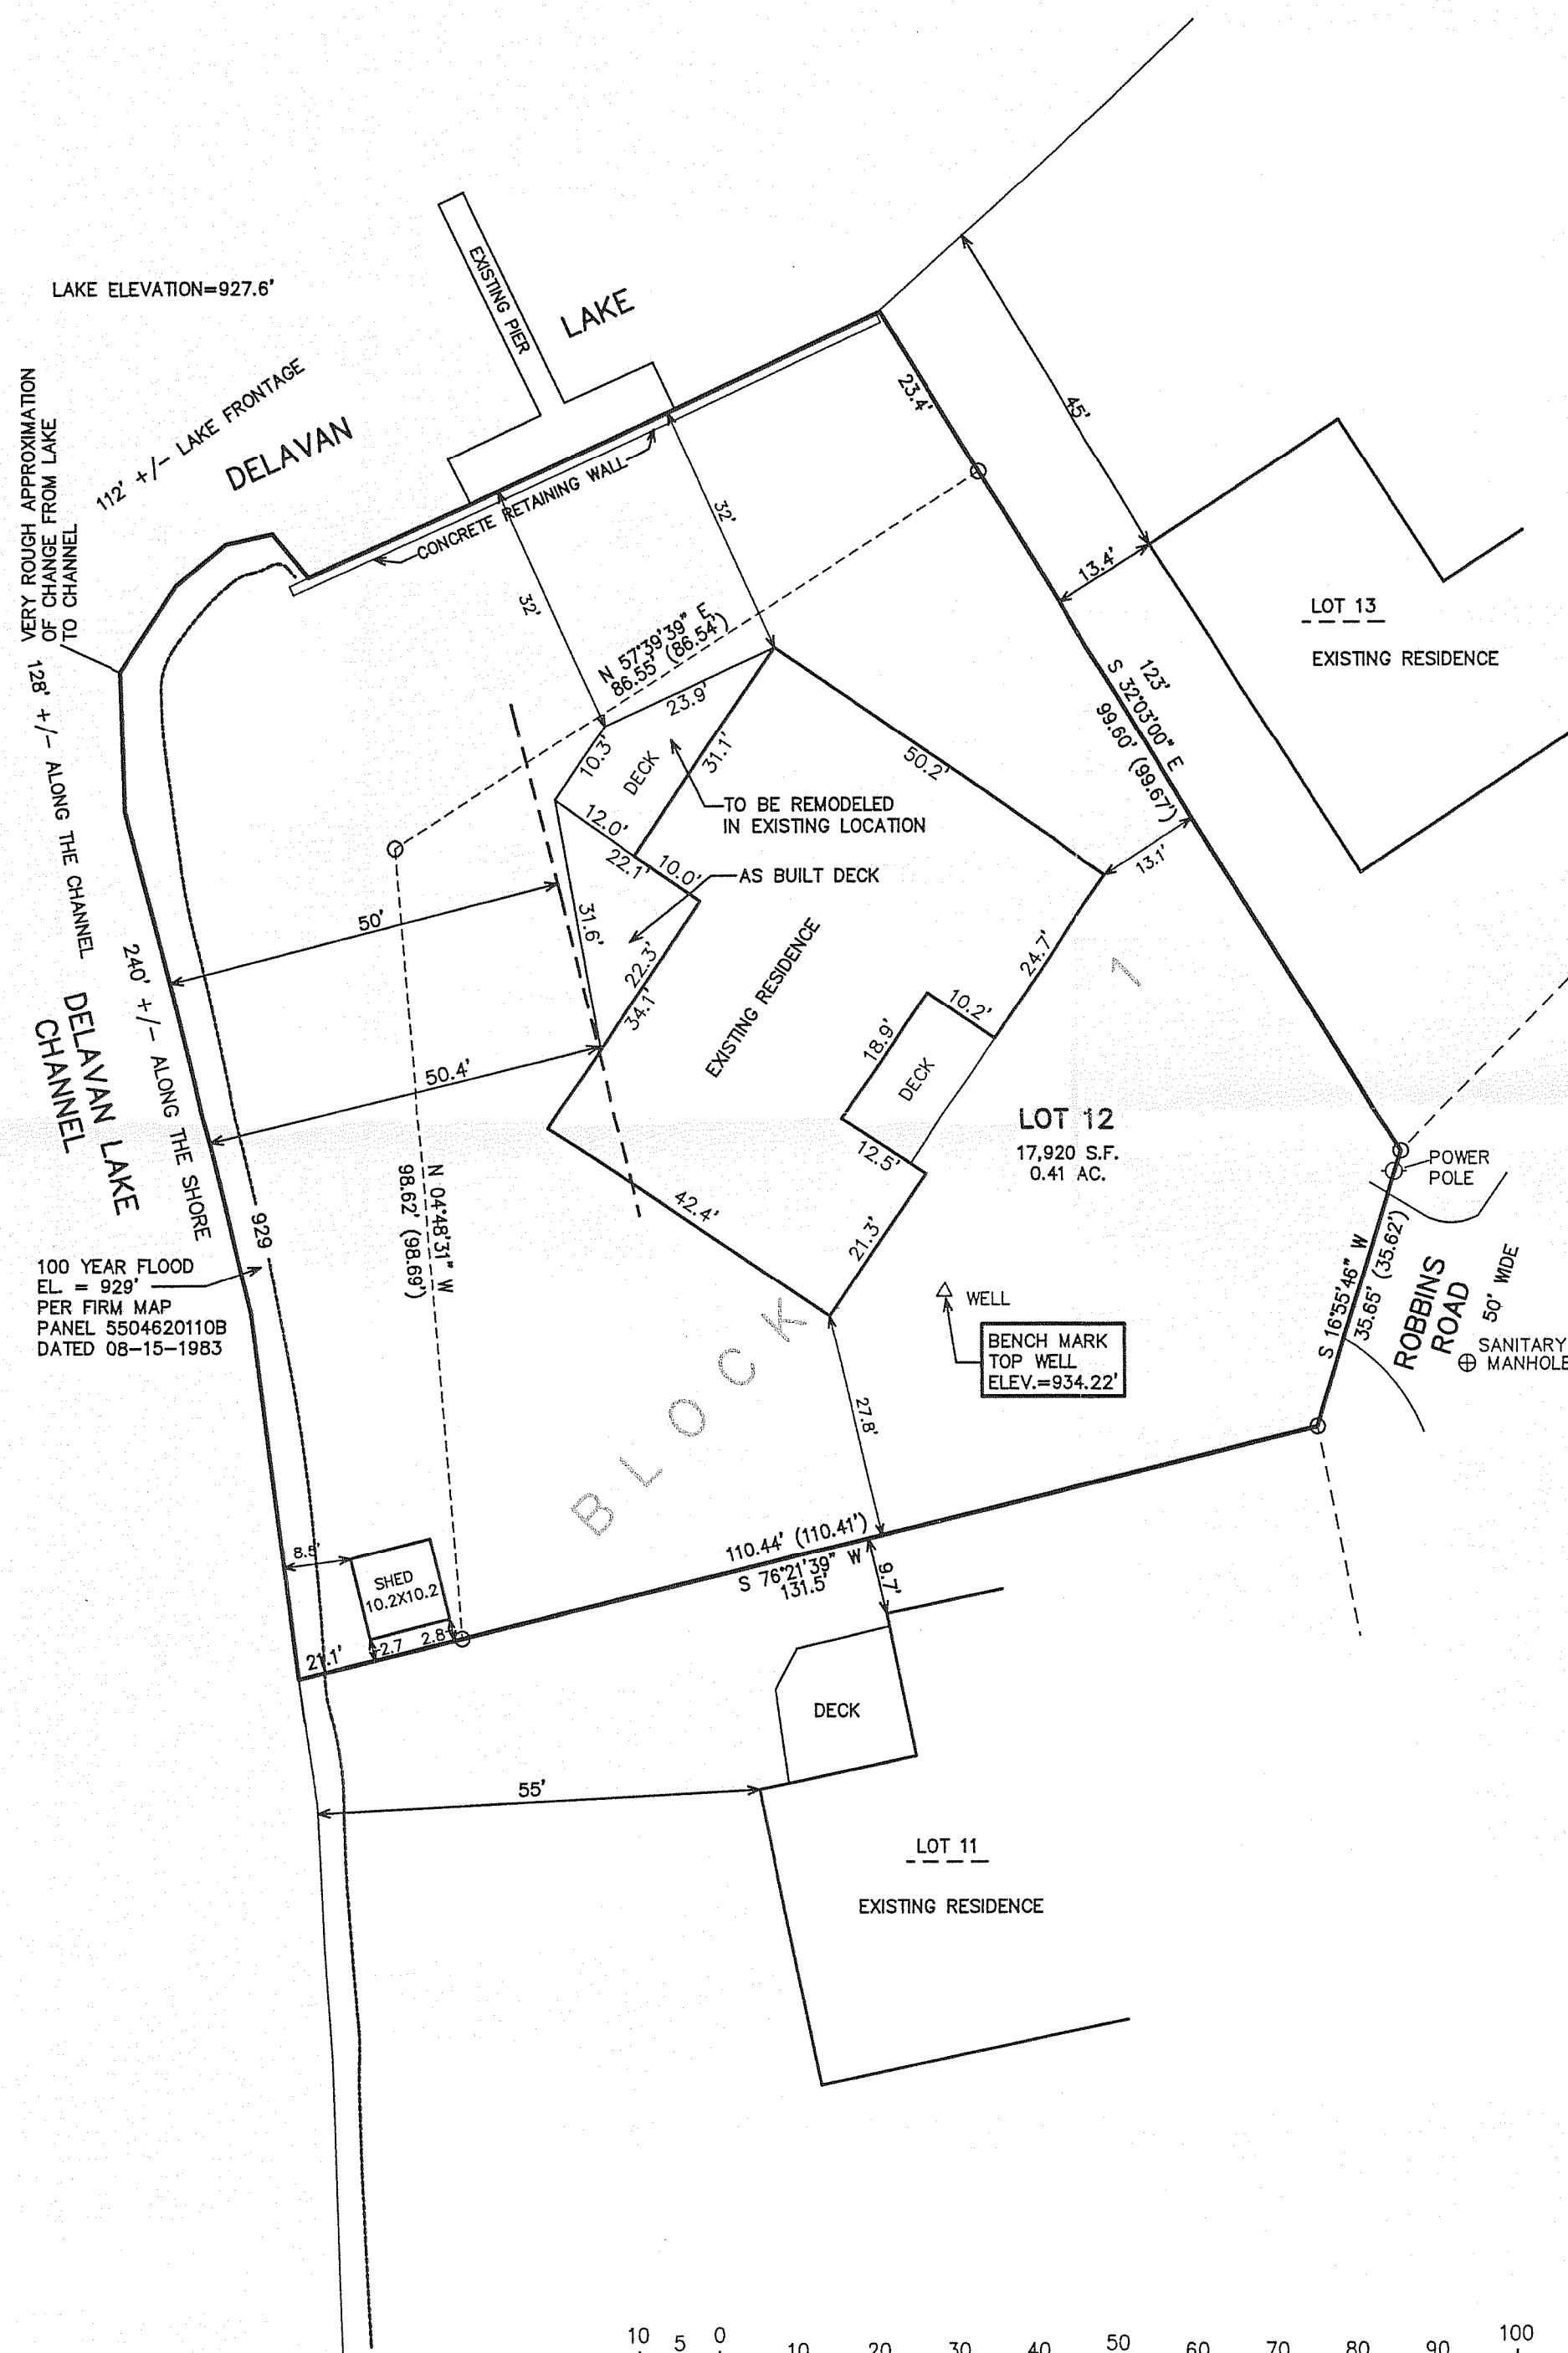

DATED: MAY 1, 2008

REVISED 8/1/2008-KB
TO SHOW ABUTTERS SETBACKS AND SIZE AND
LOCATION OF PROPOSED DECK

REVISED 09-29-2008
TO SHOW AS BUILT DECK


PETER S. GORDON R.L.S. 2101

216-4582