


PREPARED FOR
PAUL STIMAC
1240 W. 151st ST.
LOCKPORT IL. 60441

PLAT OF SURVEY

OF




LOT 2 OF RAVENSWOOD, ACCORDING TO THE RECORDED PLAT THERE OF,
TOWN OF DELAVAN, COUNTY OF WAL WORTH AND STATE OF WISCONSIN.

KROTT SURVEYING INC.
N3705 WILLOW BEND LANE
LAKE GENEVA WI. 53147
PHONE # (262)248-3697
FAX # (262)249-0639

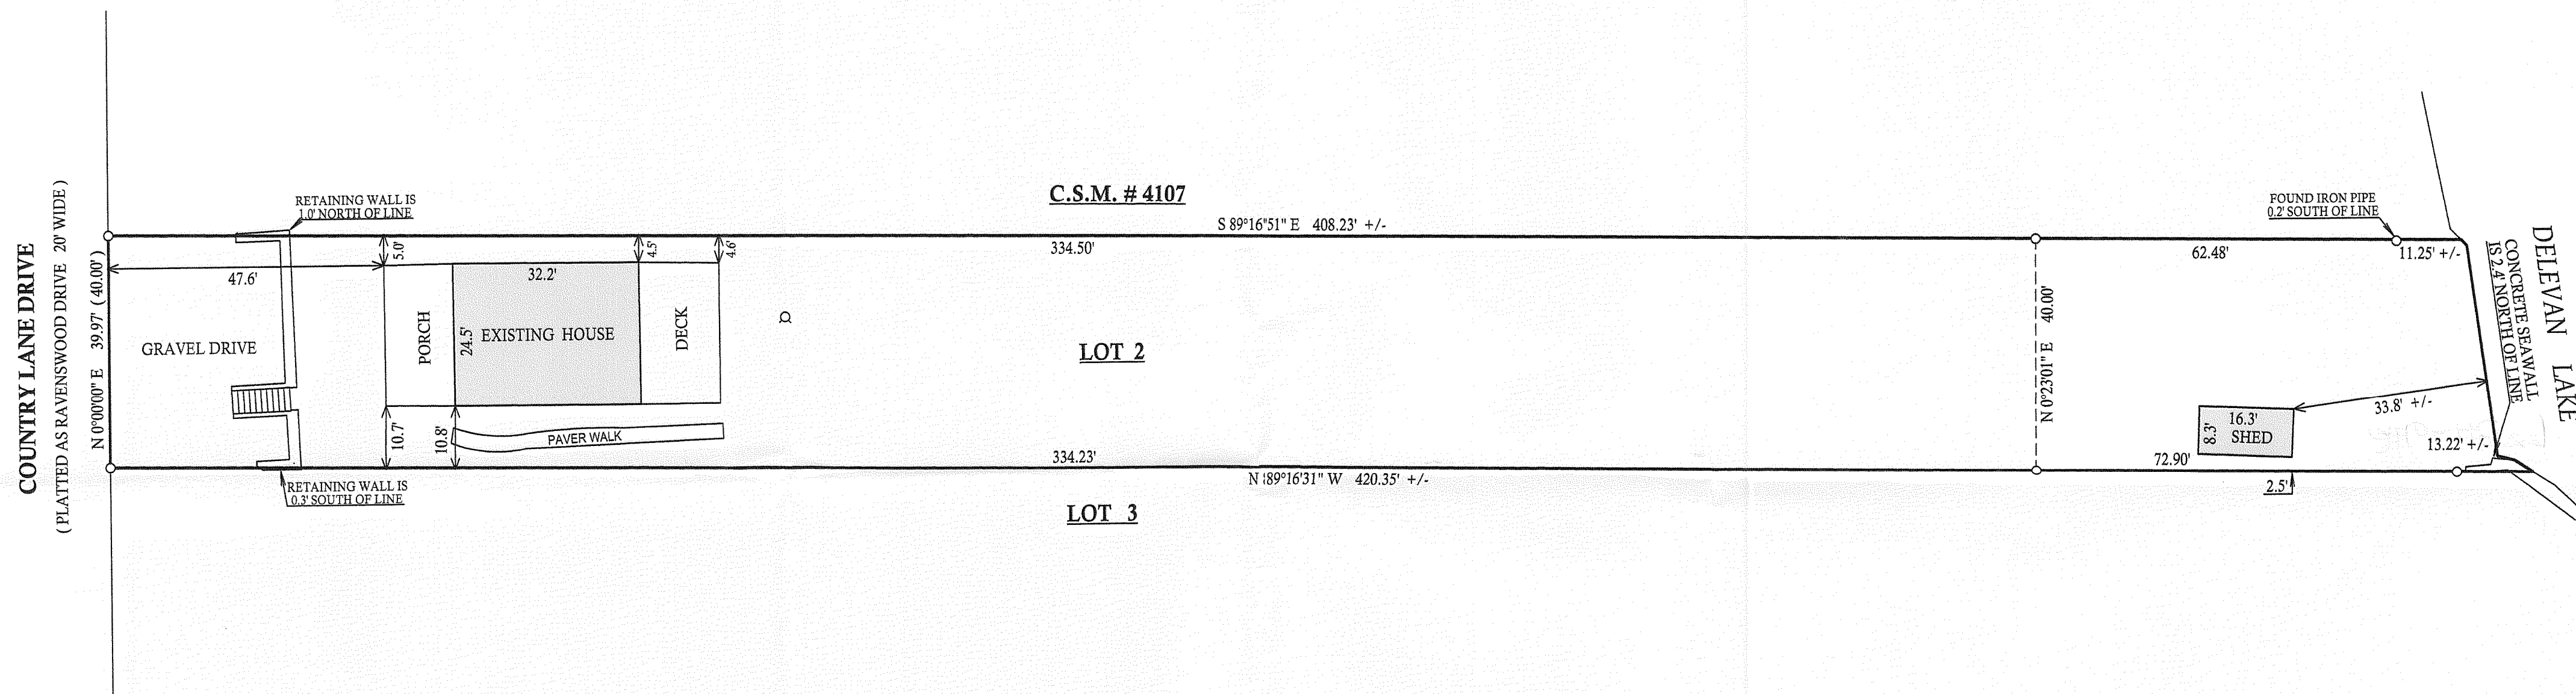


LEGEND

- FOUND IRON PIPE
- WELL
- (XX) RECORDED AS
- JOB # 08-227
- TAX ID # FR00002

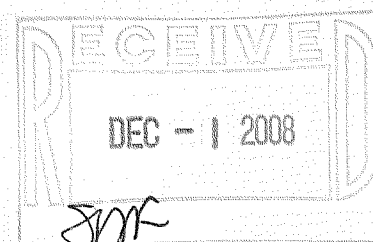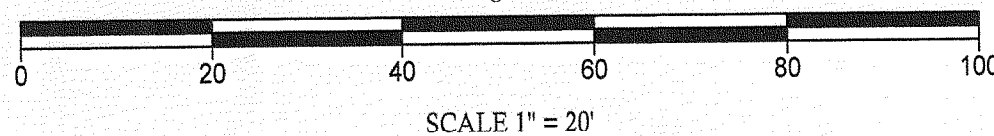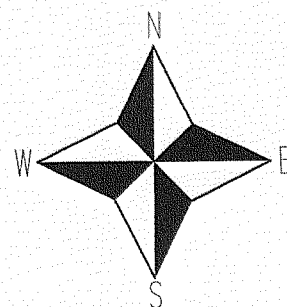

"I hereby certify that I have surveyed the above described property and that the above map is a true representation thereof and shows the size and location of all visible structures, apparent easements and encroachments if any."

This survey is made for the present owners of the property, and those who purchase, mortgage, or guarantee the title thereto, within one year from the date hereof.

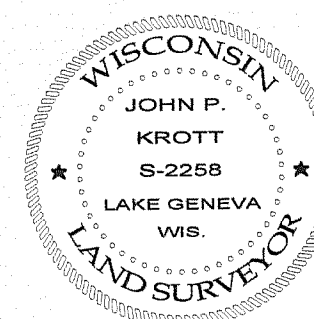

DATED THIS 4th, DAY OF NOVEMBER, 2008

John P. Krott

JOHN KROTT S - 2258
Wisconsin Registered Land Surveyor
(original if signed in red)

216-4587