


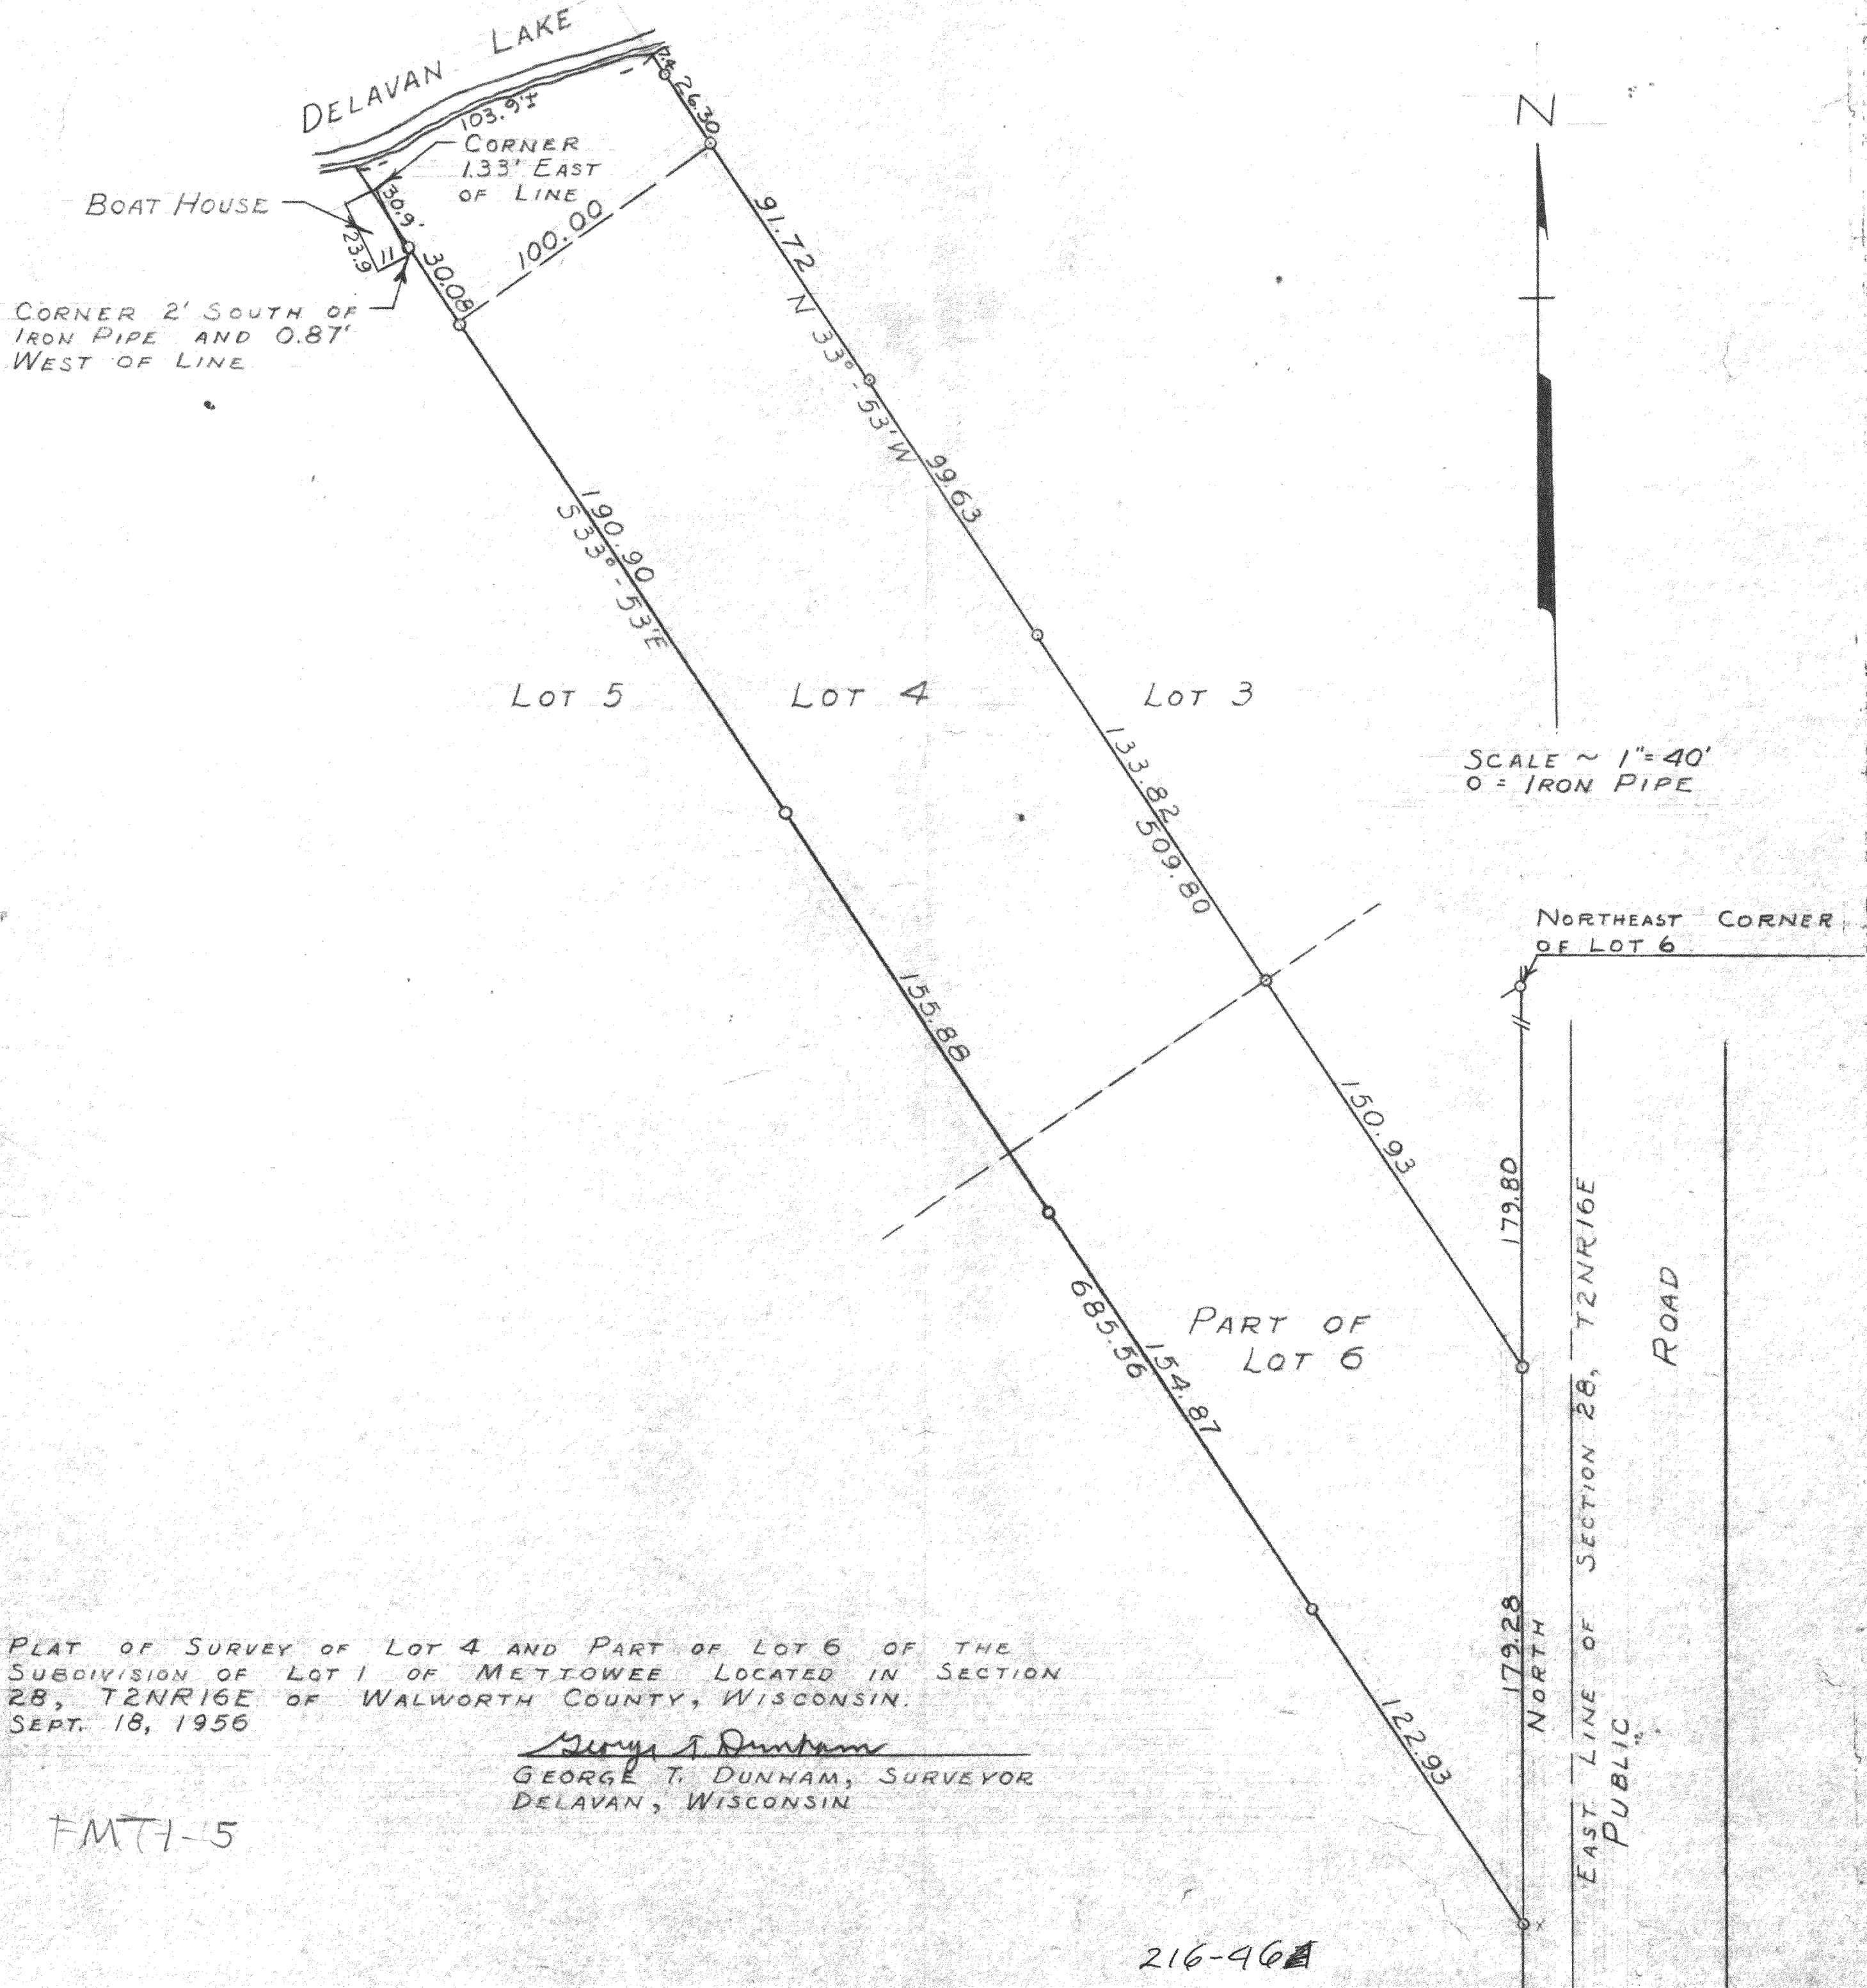

PLAT OF SURVEY OF LOT 4 AND PART OF LOT 6 OF THE
 SUBDIVISION OF LOT 1 OF METTOWEE LOCATED IN SECTION
 28, T2NR16E OF WALWORTH COUNTY, WISCONSIN.
 SEPT. 18, 1956

George T. Dunham
 GEORGE T. DUNHAM, SURVEYOR
 DELAVAN, WISCONSIN

FMTH-15

216-46