

DELANAN LAKE

ABELL
SURVEYING & MAPPING
1140 SEQUOIA STREET • DELAVAN, WISCONSIN 53115
262-728-6737


NOTE: BEARINGS ARE REFERENCED TO
EXISTING SURVEY RECORDS.

N

SCALE 1"=20'

LEGEND

⊙ - IRON PIPE FOUND
MH ⊙ - MANHOLE COVER

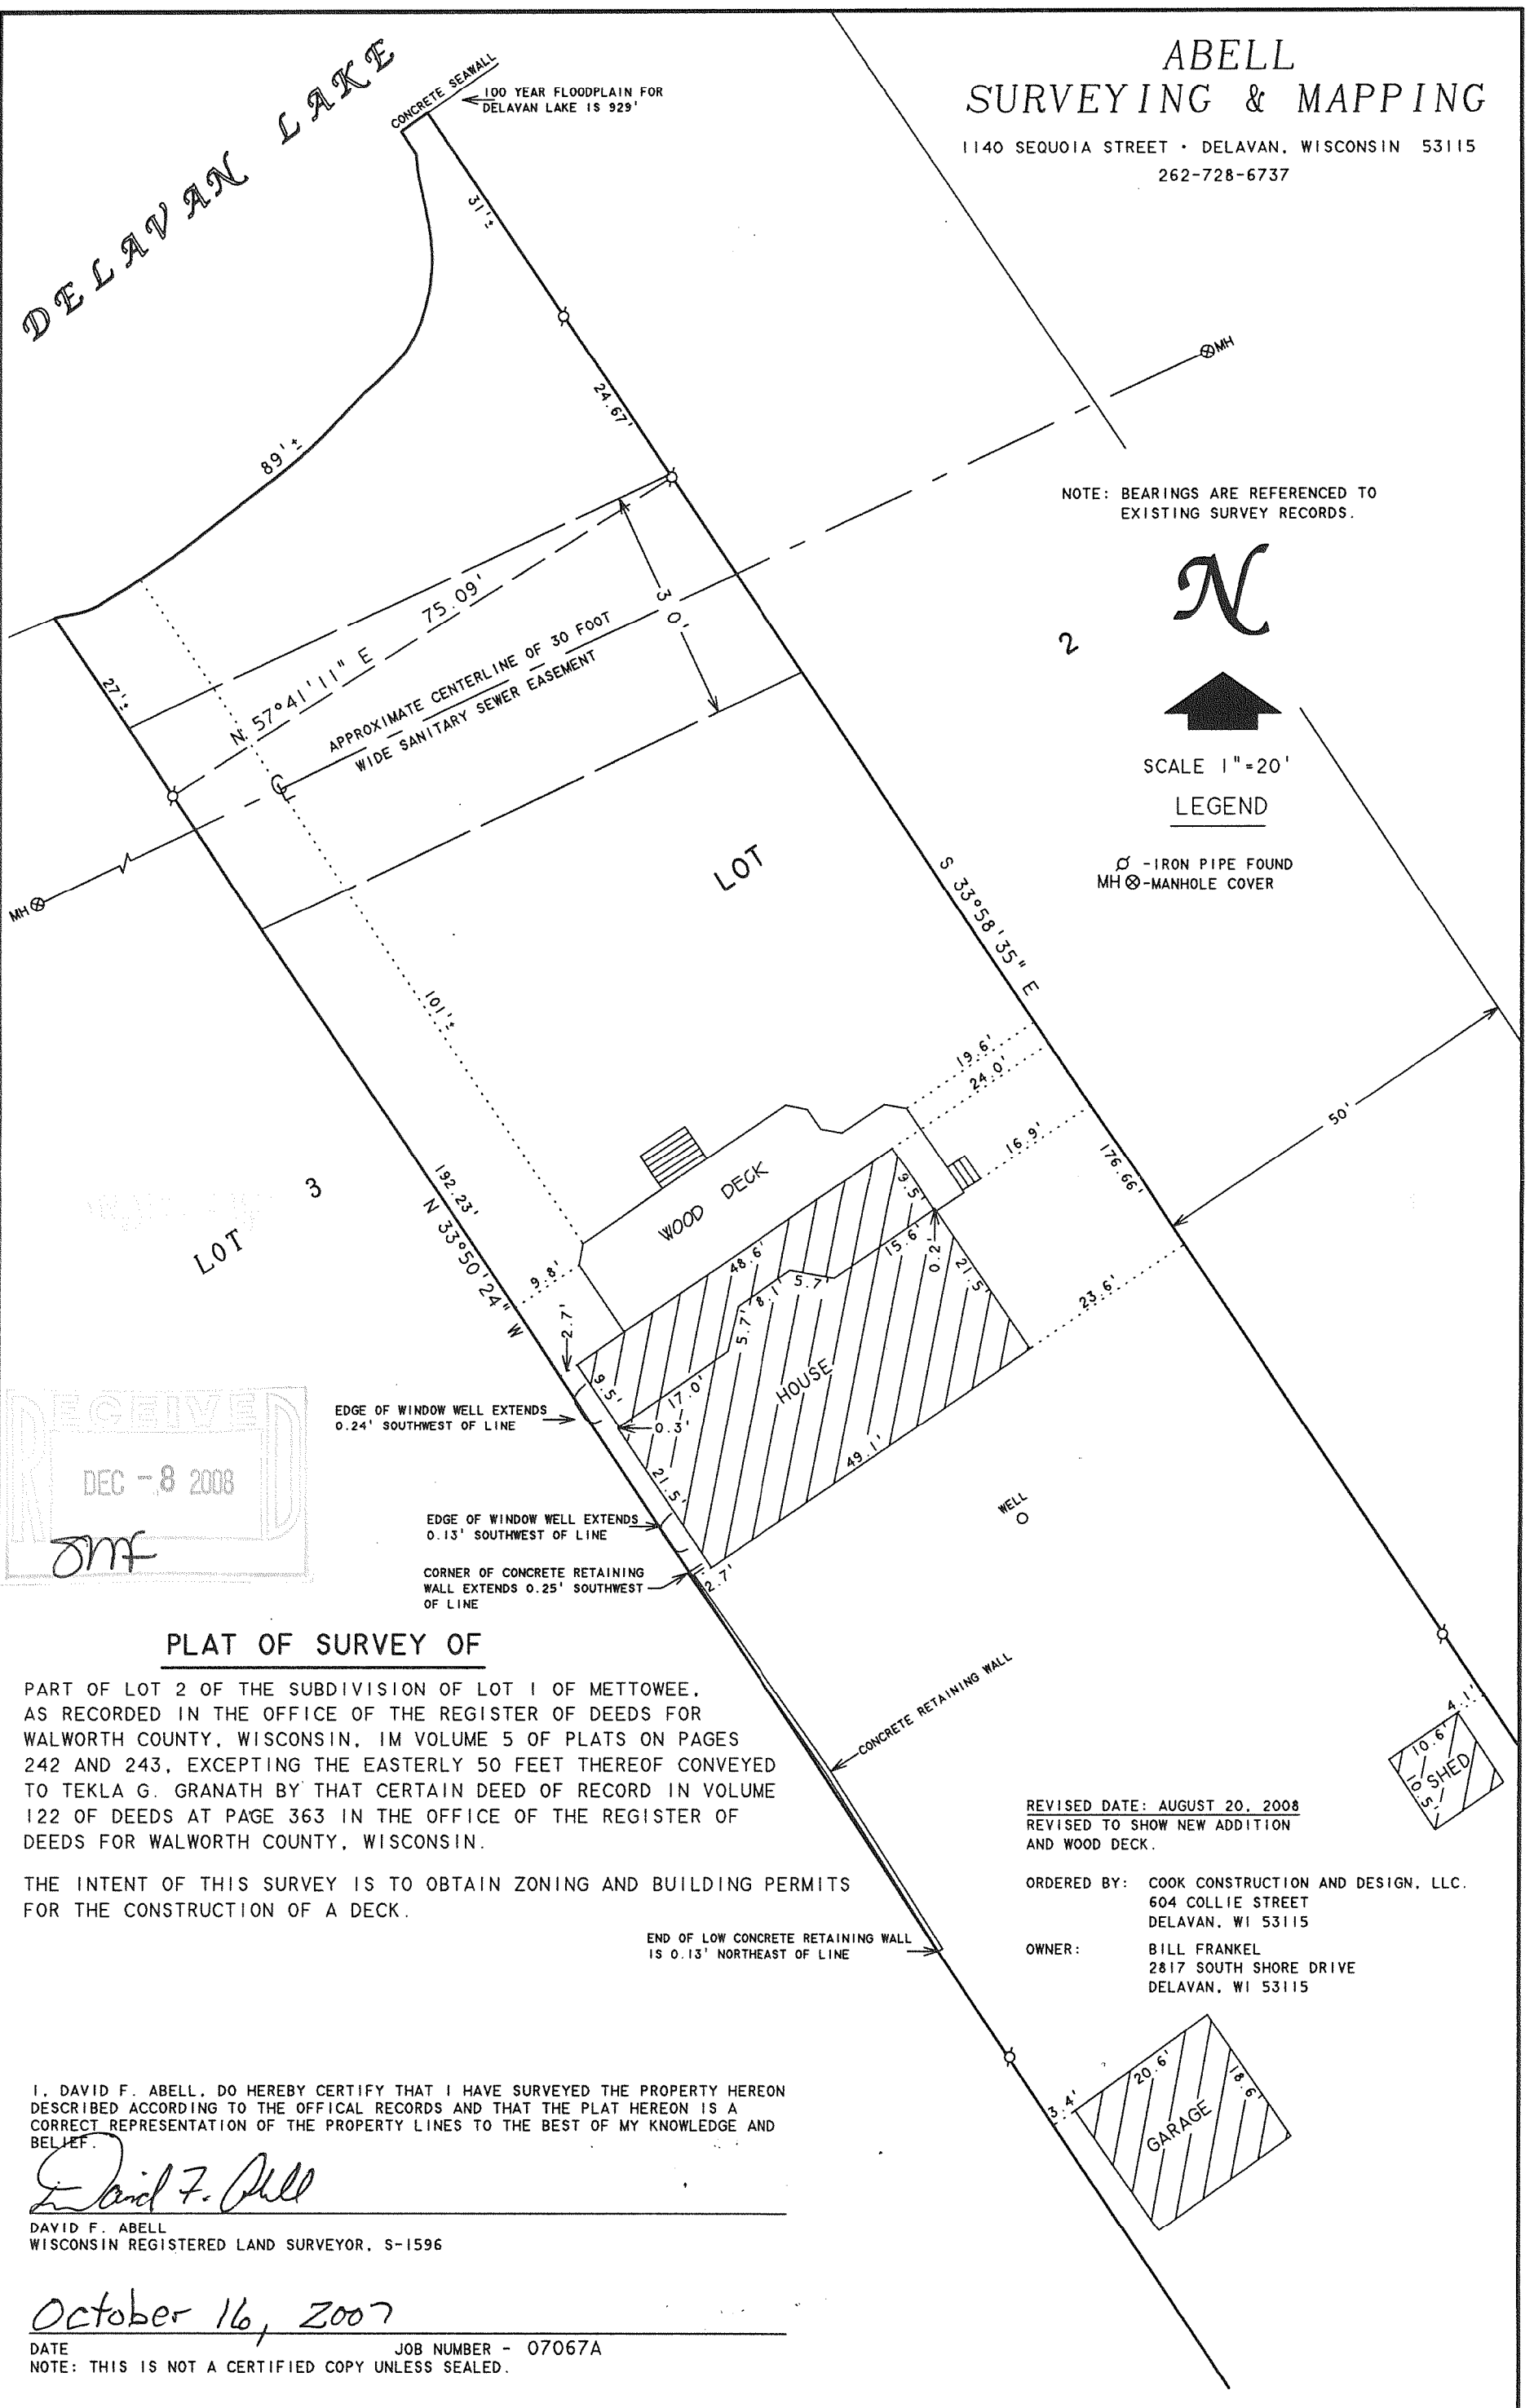

FMT1-4

216-4610