


PLAT OF SURVEY

PART OF LOT 3 OF THE ADDITION TO WILLOW POINT PARK  
LOCATED IN PART OF THE SOUTHEAST 1/4 OF SECTION 29, TOWN 2 NORTH,  
RANGE 16 EAST, TOWN OF DELAVAN, WALWORTH COUNTY, WISCONSIN

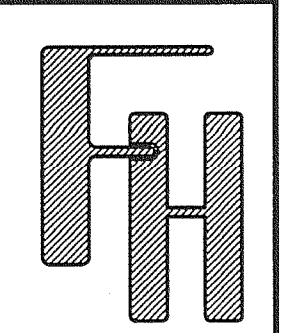



PLAT OF SURVEY

WORK ORDERED BY -  
JUDY JISA  
192 MILLBRIDGE  
RIVERSIDE, IL. 60546


FARRIS, HANSEN & ASSOCIATES, INC.  
ENGINEERING - ARCHITECTURE - SURVEYING  
7 RIDGWAY COURT P.O. BOX 437  
ELKHORN, WISCONSIN 53121  
OFFICE: (262) 723-2098 FAX: (262) 723-5886

| REVISIONS   |            |
|-------------|------------|
| PROJECT NO. | 7123       |
| DATE        | 06/07/2007 |
| SHEET NO.   | 1 OF 1     |

LEGAL DESCRIPTION:  
LOT 3 OF THE ADDITION TO WILLOW POINT PARK, ACCORDING TO THE RECORDED PLAT THEREOF, EXCEPTING THEREFROM A PARCEL OF LAND DESCRIBED AS FOLLOWS: BEGINNING AT THE SOUTHEAST CORNER OF SAID LOT 3 AND RUNNING SOUTHWESTERLY ALONG THE SOUTH LINE OF SAID LOT, 63 FEET TO A POINT, THENCE RUNNING NORTHWESTERLY TO THE NORTH-EAST CORNER OF SAID LOT 3; THENCE SOUTHWESTERLY ALONG THE EAST LINE OF SAID LOT 3 TO THE POINT OF BEGINNING. SAID LAND BEING IN THE TOWN OF DELAVAN, WALWORTH COUNTY, WISCONSIN. SUBJECT TO: MUNICIPAL AND ZONING ORDINANCES, RECORDED EASEMENTS FOR PUBLIC UTILITIES LOCATED ADJACENT TO SIDE AND REAR LOT LINES, RECORDED BUILDING AND USE RESTRICTIONS AND COVENANTS, GENERAL TAXES FOR THE YEAR 1978 AND SUBSEQUENT YEARS, EASEMENT GRANTED DELAVAN LAKE SANITARY DISTRICT FOR INSTALLATION OF SEWER SYSTEM IN THE DELAVAN LAKE AREA, SPECIAL ASSESSMENT LEVIED BY THE DELAVAN LAKE SANITARY DISTRICT.

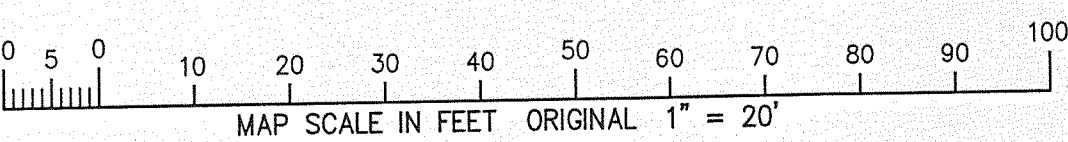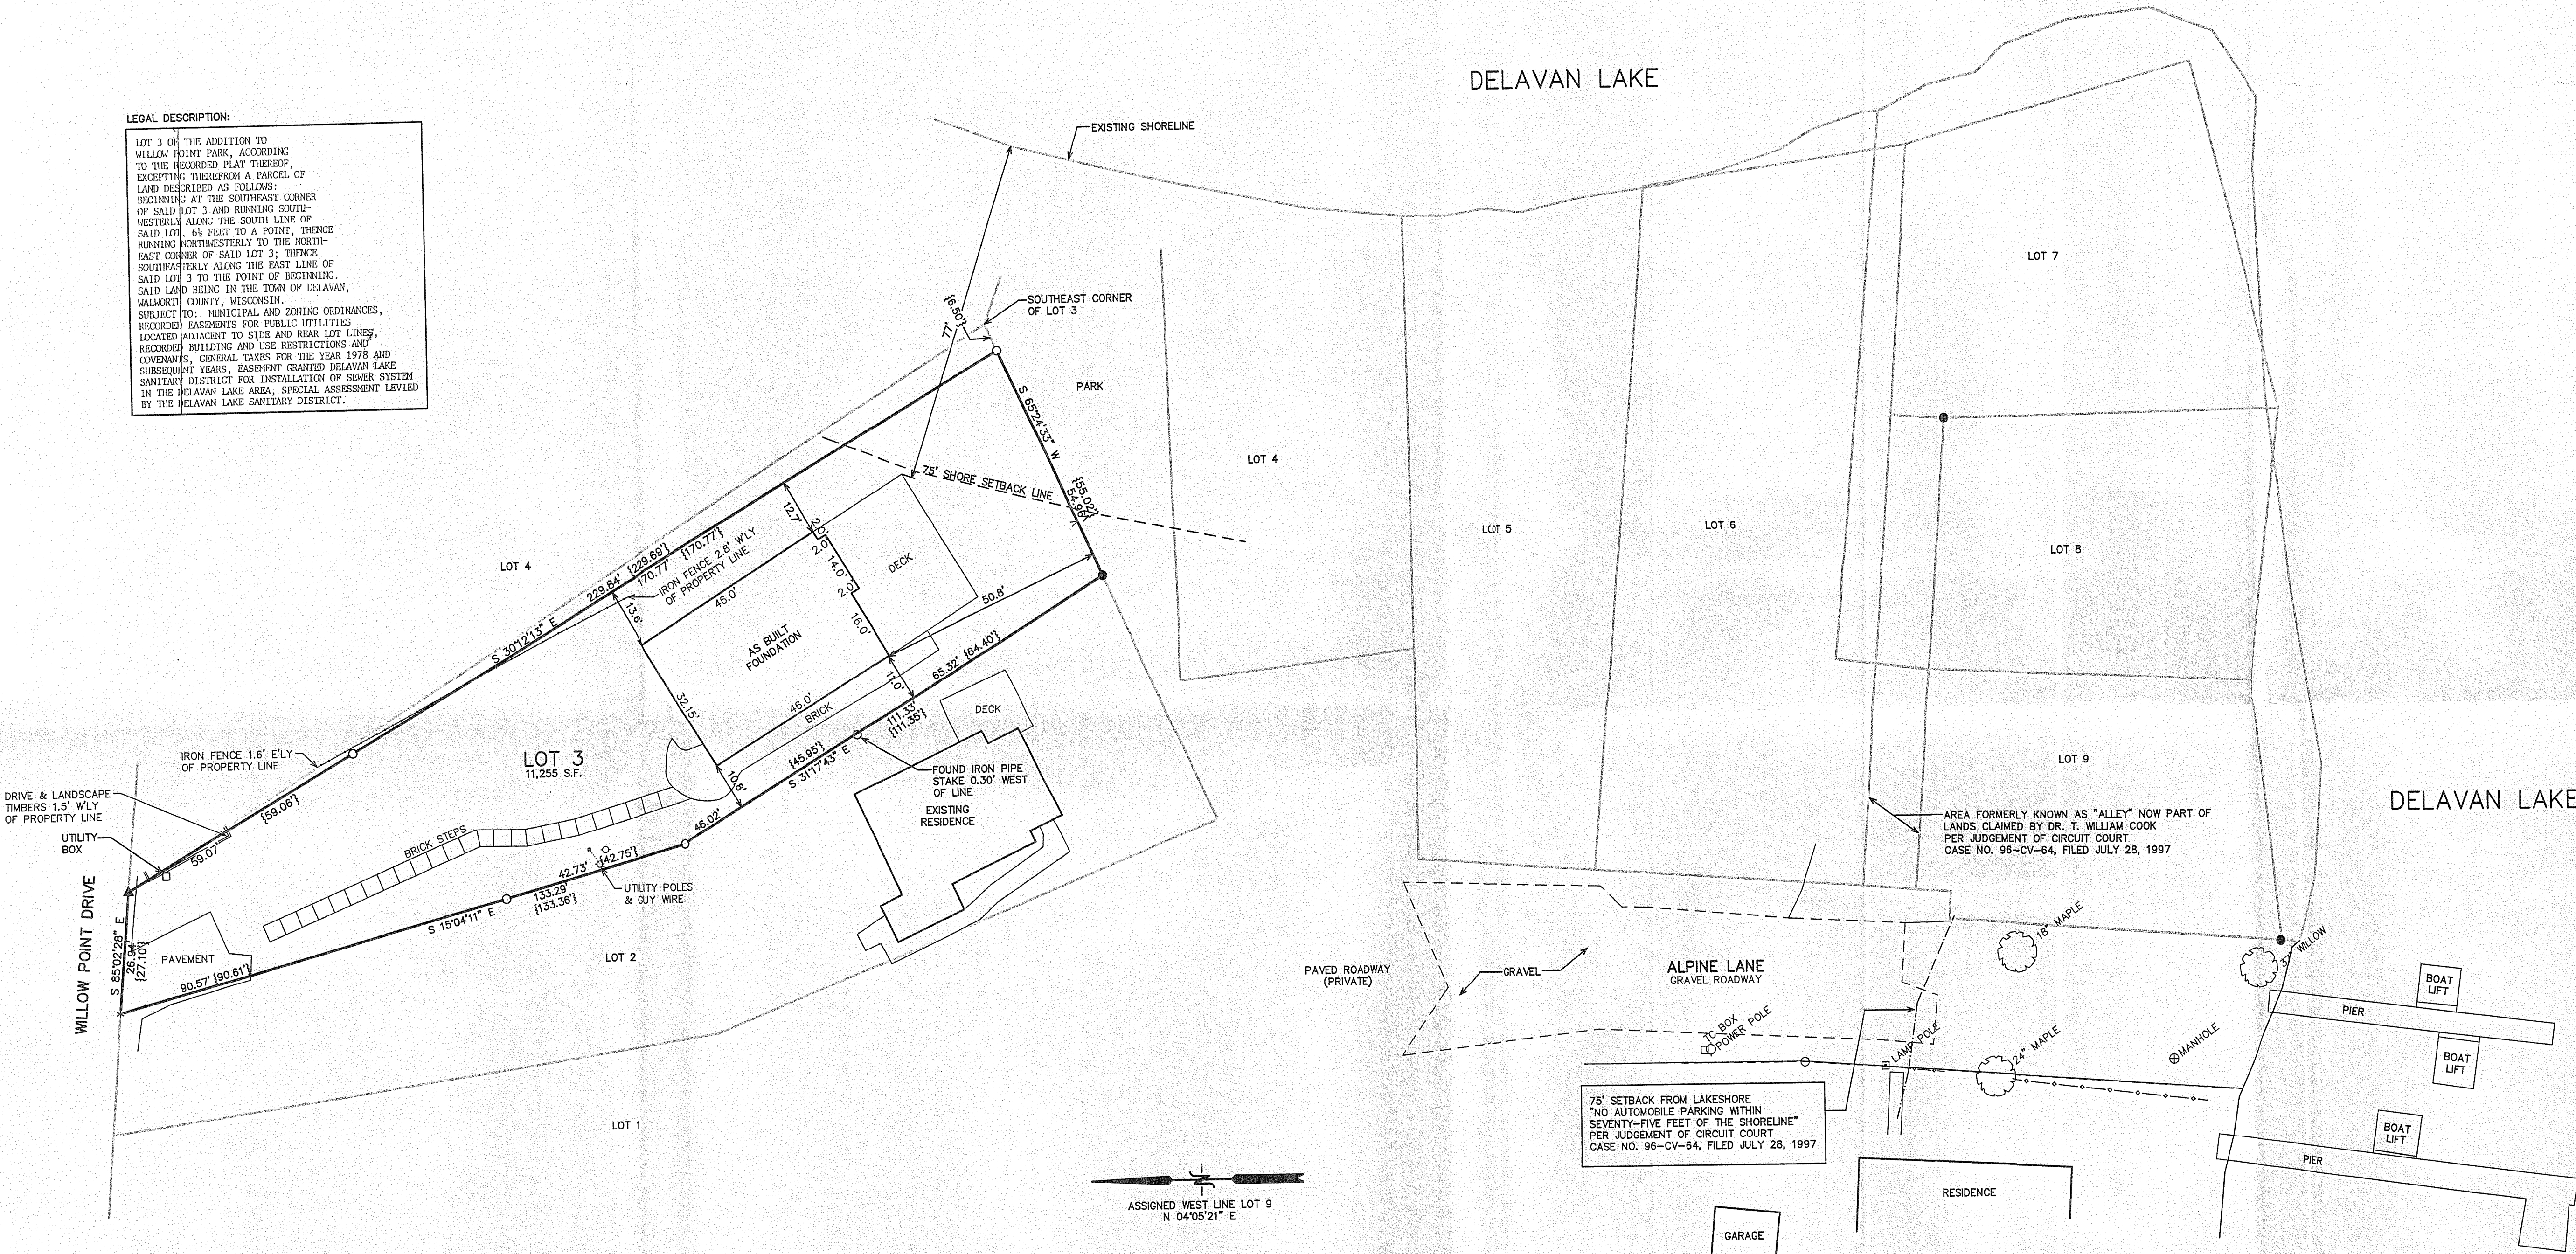

- LEGEND
- \* = SET NAIL
  - = FOUND IRON PIPE STAKE
  - = FOUND IRON REBAR STAKE
  - = SET LANDSCAPE SPIKE IN CONCRETE MONUMENT
  - ▲ = EXISTING GEAR SPIKE
  - [XXX] = RECORDED AS

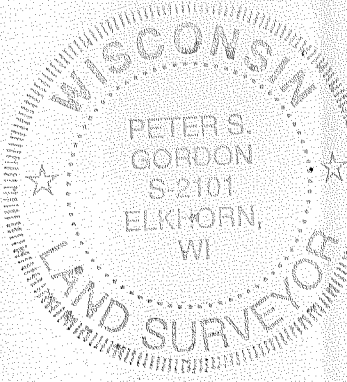


NOTE: COPIES OF THIS MAP TO WHICH THE FOLLOWING CERTIFICATE WILL APPLY SHOW THE SURVEYOR'S ORIGINAL SEAL AND SIGNATURE IN RED INK. COPIES BY ANY OTHER MEANS MAY HAVE ALTERATIONS WHICH DO NOT REPRESENT THE SURVEYOR'S WORK PRODUCT.

I HEREBY CERTIFY THAT THE ABOVE DESCRIBED PROPERTY HAS BEEN SURVEYED UNDER MY DIRECTION AND THAT THE ABOVE MAP IS A TRUE REPRESENTATION THEREOF AND SHOWS THE SIZE AND LOCATION OF THE PROPERTY AND ITS EXTERIOR BOUNDARIES. THIS SURVEY IS MADE FOR THE USE OF THE PRESENT OWNERS OF THE PROPERTY, AND ALSO THOSE WHO PURCHASE, MORTGAGE, OR GUARANTEE THE TITLE THERETO WITHIN ONE YEAR FROM THE DATE HEREOF.

DATED: JUNE 7, 2007

PETER S. GORDON  
R.L.S. 2101

REVISED 09-12-2007  
TO SHOW SIZE & LOCATION OF  
AS BUILT FOUNDATION  
REVISED 12-9-2008  
TO UPDATE SURVEY

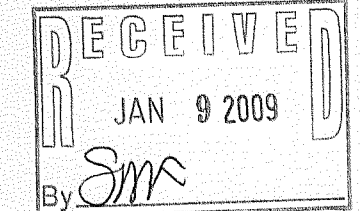

216-1620

FWIA-3