


GEORGE T. DUNHAM
SURVEYING & SUBDIVIDING
DELAVER, WISCONSIN

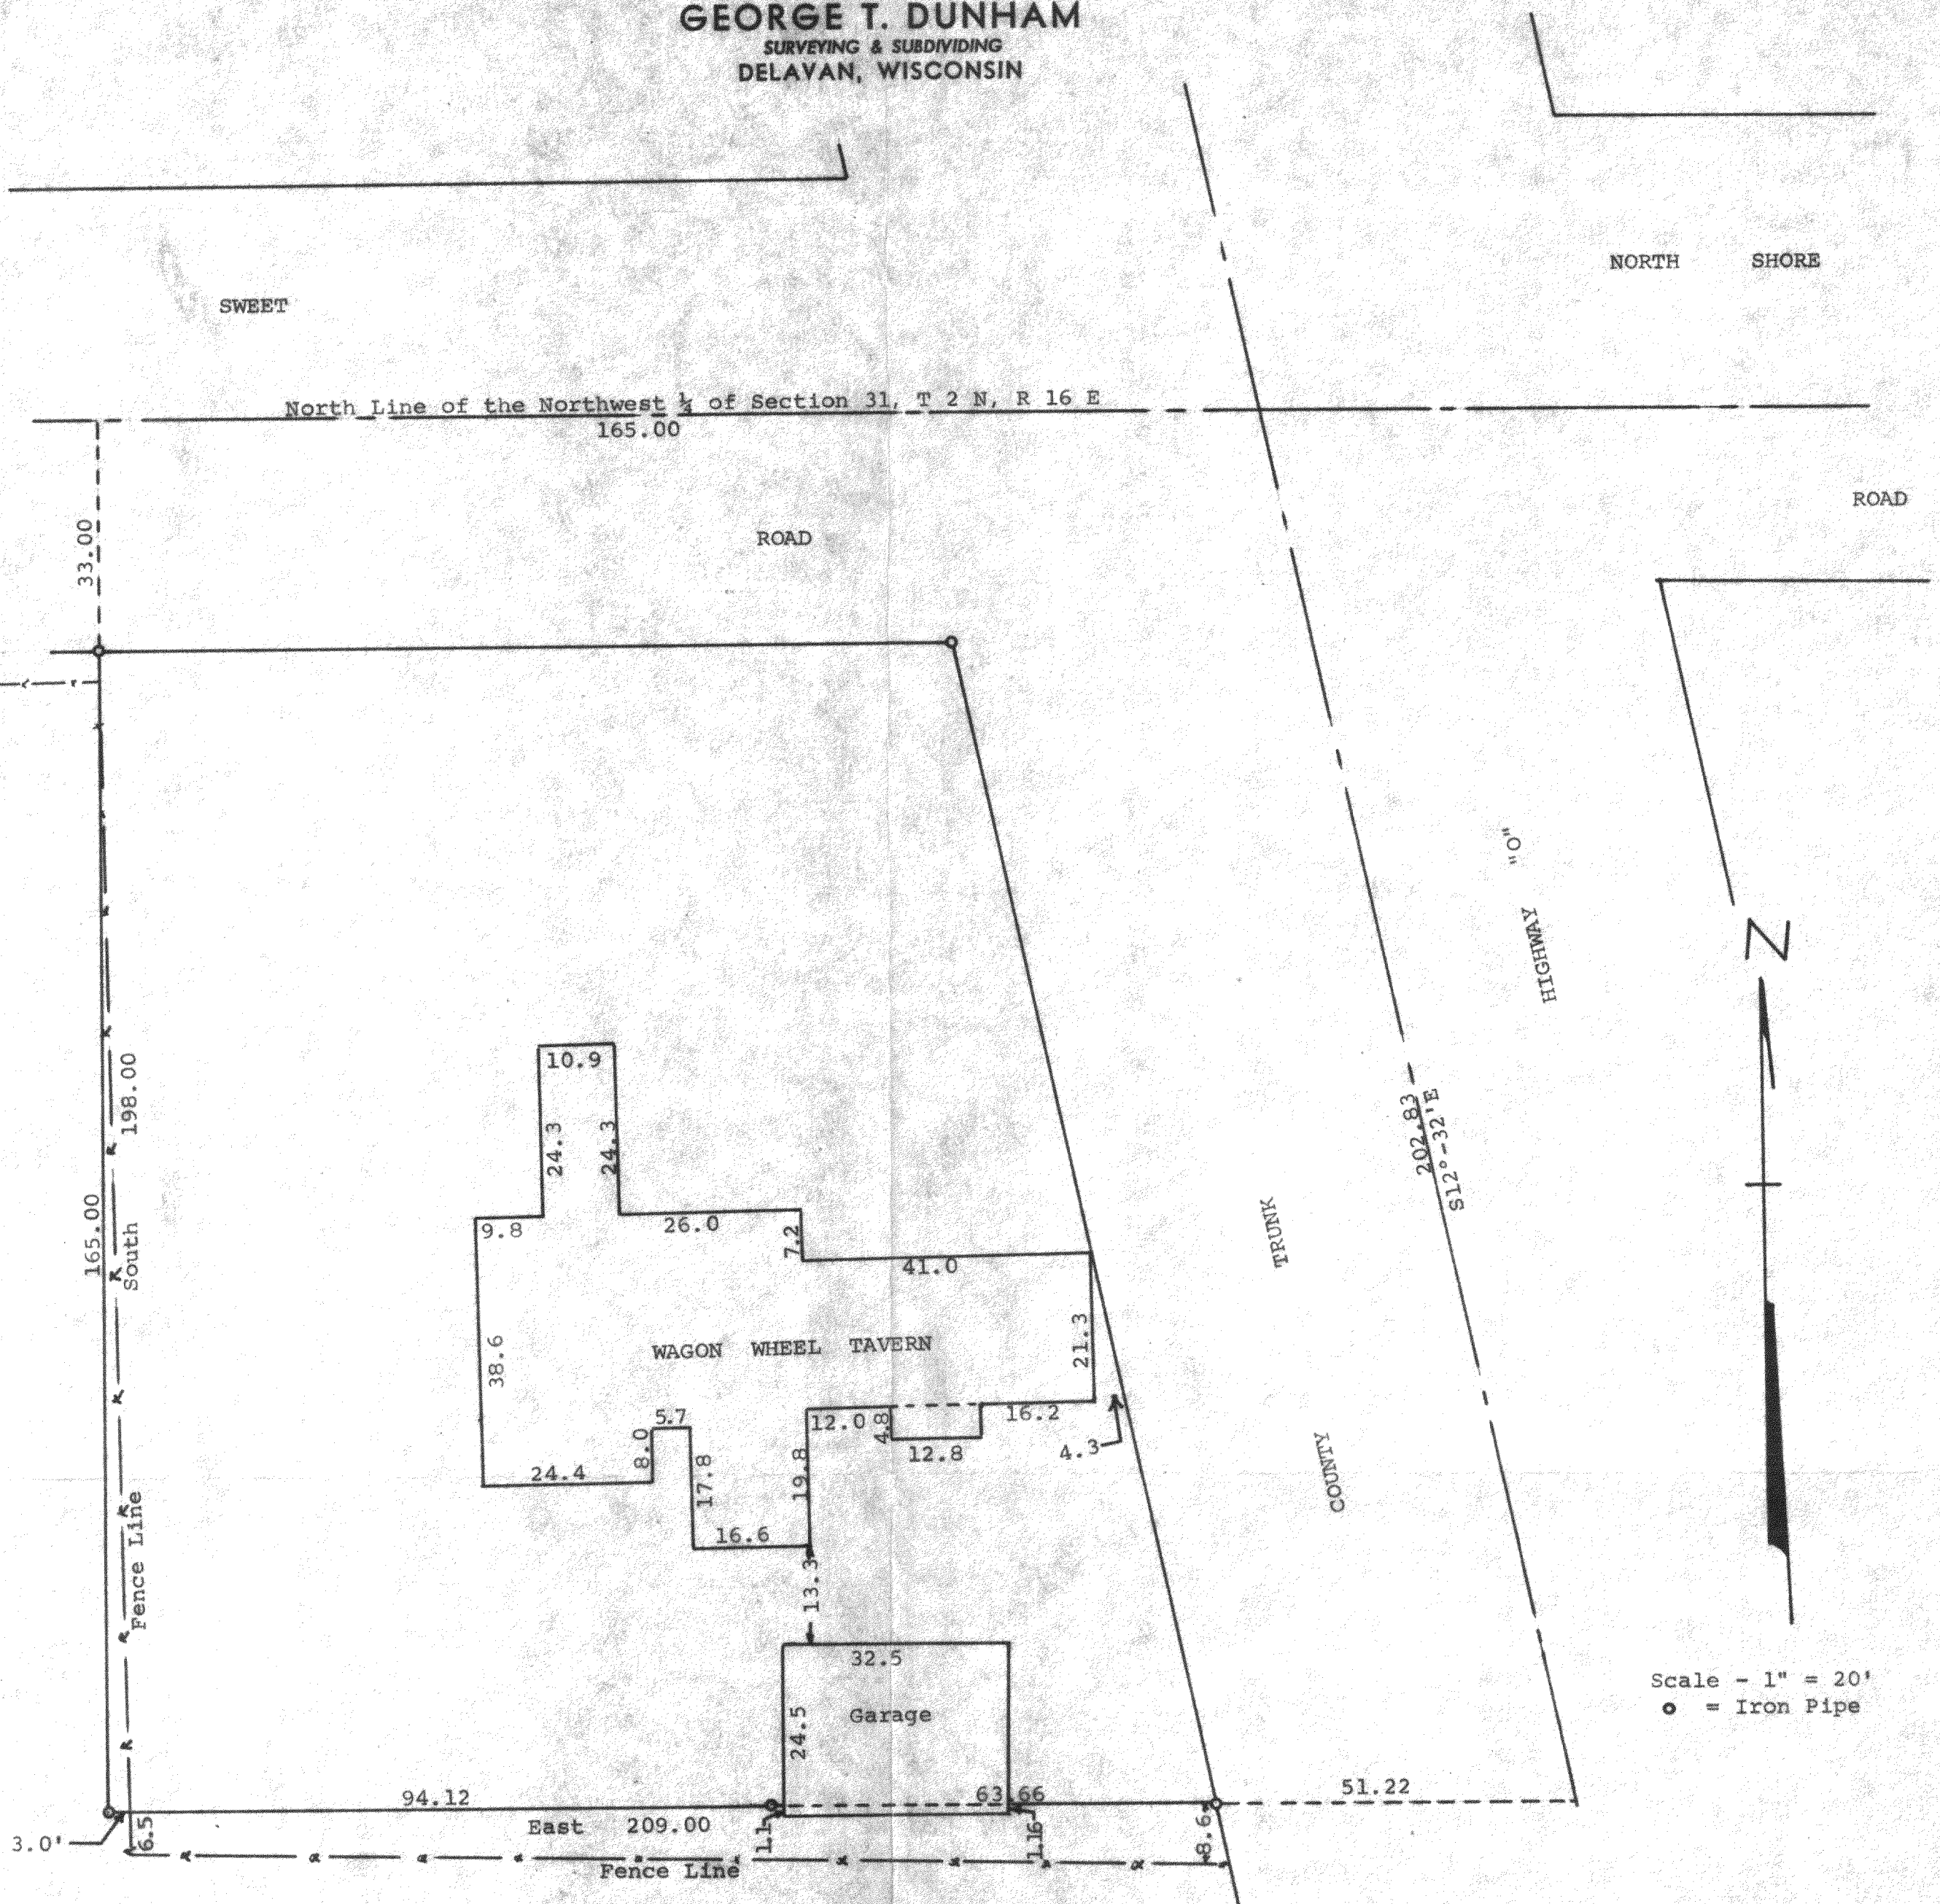

Scale - 1" = 20'
● = Iron Pipe


STATE OF WISCONSIN)
COUNTY OF WALWORTH) SS

I, George T. Dunham, Surveyor, certify that I have surveyed the property described as follows.

A parcel of land located in the Northwest 1/4 of Section 31, T 2 N, R 16 E, Walworth County, Wisconsin, described as follows, to-wit: Beginning at the intersection of the centerline of the highway from Delavan to Walworth (County Trunk Highway "O") and the north line of said Section 31; thence West along the north line of said section 31, 165.00 feet; thence South 198.00 feet; thence East to the centerline of said County Trunk Highway "O"; thence N12°-32'W along said centerline 202.83 feet to the place of beginning.

and that the above plat is an accurate survey and a true representation thereof and correctly shows the exterior boundary lines and location of buildings on said property and the correct measurements thereof.
March 27, 1974

George T. Dunham
George T. Dunham, Surveyor

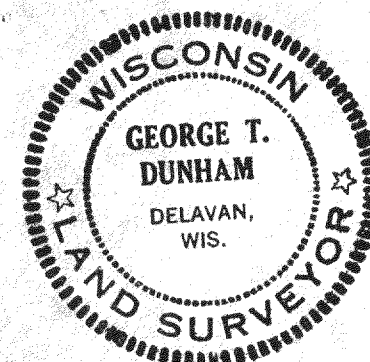

D-31-2 Wagon Wheel