PREPARED FOR GARY KAPITAN C/O ROSE MILLER CENTURY 21 AFFILIATED 1741 E. GENEVA ST # 800 DELAVAN WI. 53115


## PLAT OF SURVEY

-OF-

LOTS 3, 4 AND 5 BLOCK 6, INLET OAKS SUBDIVISION NO. 4 LOCATED IN SECTION 15, TOWN 2 NORTH, RANGE 16 EAST, WALWORTH COUNTY, WISCONSIN.

KROTT SUR VEYING INC.

N3705 WILLOW BEND LANE
LAKE GENEVA WI. 53147
PHONE # (262)248-3697
FAX # (262)249-0639

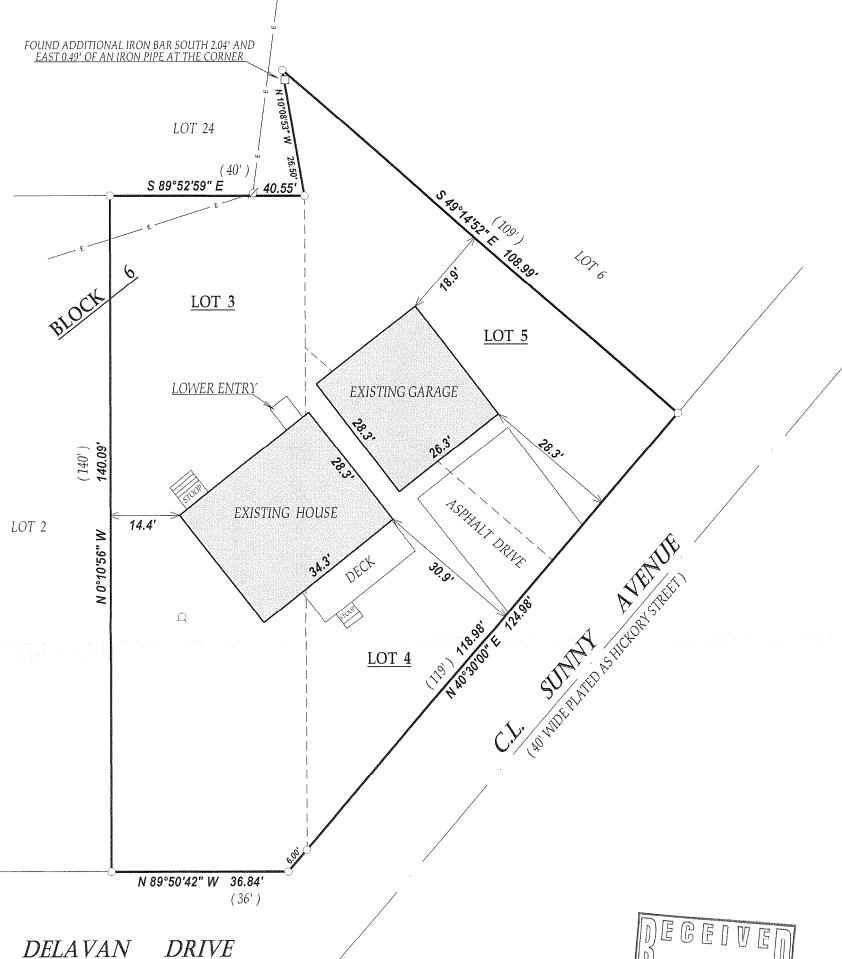

LEGEND

C.L.

O FOUND IRON PIPE

(40' WIDE)

☐ FOUND IRON BAR

Ø UTILITY POLE


— E— OVERHEAD UTILITIES

Q WELL

JOB # 09-097


(XX) RECORDED AS


TAX ID #(FIN400043)

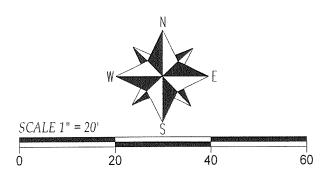

"I hereby certify that I have surveyed the above described property and that the above map is a true representation thereof and shows the size and location of all visible structures, apparent easements and encroachments if any."

This survey is made for the present owners of the property, and those who purchase, mortgage, or guarentee the title thereto, within one year from the date hereof.

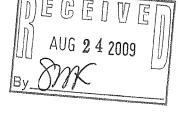

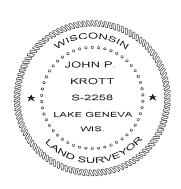

DATED THIS 23rd DAY OF JULY 2009.

John Black

JOHN KROTT S - 2258 Wisconsin Registered Land Surveyor ( original if signed in red )

216-467)