


FARRIS, HANSEN & ASSOCIATES, INC.

ENGINEERING — ARCHITECTURE — SURVEYING
7 RIDGWAY COURT — P.O. BOX 437 — ELKHORN, WISCONSIN 53121
PHONE: (262) 723-2098 FAX: (262) 723-5886

PLAT OF SURVEY LOT 27 BLOCK 17 OF DELAVAN LAKE VIEW CREST SUBDIVISION

LOCATED IN PART OF SECTION 31, TOWN 2 NORTH,
RANGE 16 EAST, WALWORTH COUNTY, WISCONSIN

— WORK ORDERED BY —
LOUISE NYGARD
7825 N. KOSTNER AVENUE
SKOKIE, IL 60076

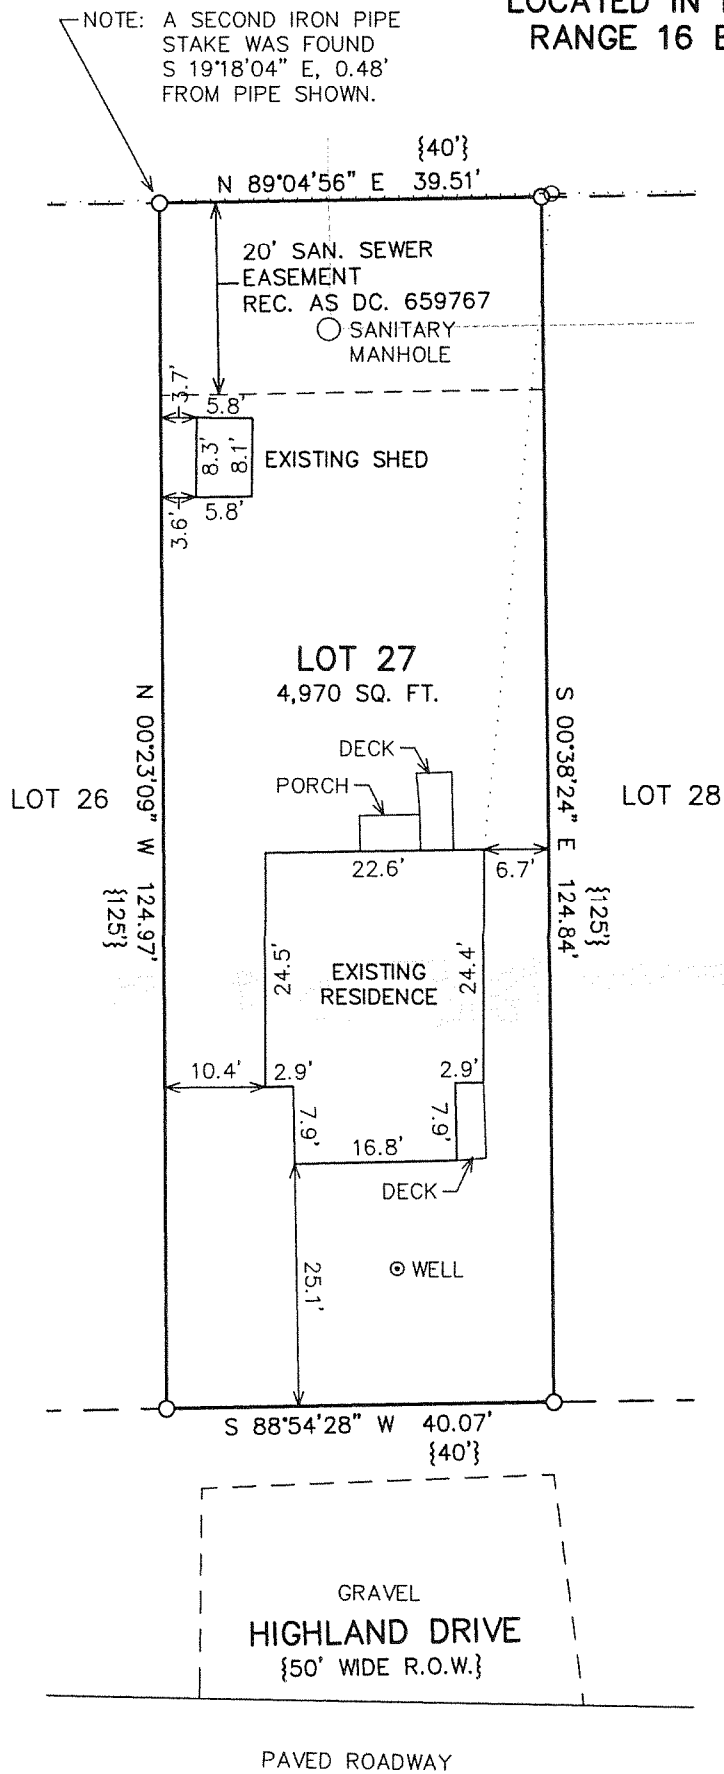

ASSIGNED THE NORTHERLY RIGHT
OF WAY LINE OF HIGHLAND DRIVE
S 88°54'28" W



3. The land referred to in the Commitment is described as follows:

Lot 27 Block 17 Delavan Lake View Crest Subdivision, being a Subdivision of a part of the North 1/2 of Section 31 in Township 2 North, Range 16 East of the Fourth Principal Meridian, Walworth County, Wisconsin.

Tax Key No: FDLV 00140

LEGEND

- = FOUND IRON PIPE STAKE
- = UTILITY POLE LOCATED
- = OVERHEAD WIRES LOCATED
- {XXX} = RECORDED AS

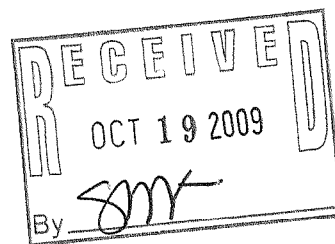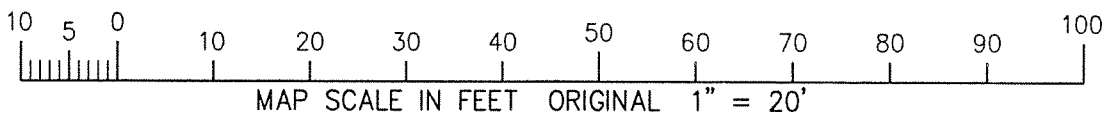

NOTE: COPIES OF THIS MAP TO WHICH THE FOLLOWING CERTIFICATE WILL APPLY SHOW SURVEYOR'S ORIGINAL SEAL AND SIGNATURE IN RED INK. COPIES BY ANY OTHER MEANS MAY HAVE ALTERATIONS WHICH DO NOT REPRESENT THE SURVEYOR'S WORK PRODUCT.

I HEREBY CERTIFY THAT THE ABOVE DESCRIBED PROPERTY HAS BEEN SURVEYED UNDER MY DIRECTION AND THAT THE ABOVE MAP IS A TRUE REPRESENTATION THEREOF AND SHOWS THE SIZE AND LOCATION OF THE PROPERTY, ITS EXTERIOR BOUNDARIES, THE LOCATION OF ALL VISIBLE STRUCTURES, AND DIMENSIONS OF ALL PRINCIPLE BUILDINGS THEREON, BOUNDARY FENCES, APPARENT EASEMENTS, ROADWAYS, AND VISIBLE ENCROACHMENTS, IF ANY. THIS SURVEY IS MADE FOR THE USE OF THE PRESENT OWNERS OF THE PROPERTY, AND ALSO THOSE WHO PURCHASE, MORTGAGE, OR GUARANTEE THE TITLE THERETO WITHIN ONE YEAR FROM THE DATE HEREOF.

DATED: 9/8/2009

PETER S. GORDON R.L.S. 2101



PROJECT: 7987
DATE: 09/08/2009
SHEET 1 OF 1