


ABELL  
SURVEYING & MAPPING

1140 SEQUOIA STREET • DELAVAN, WISCONSIN 53115  
262-728-6737

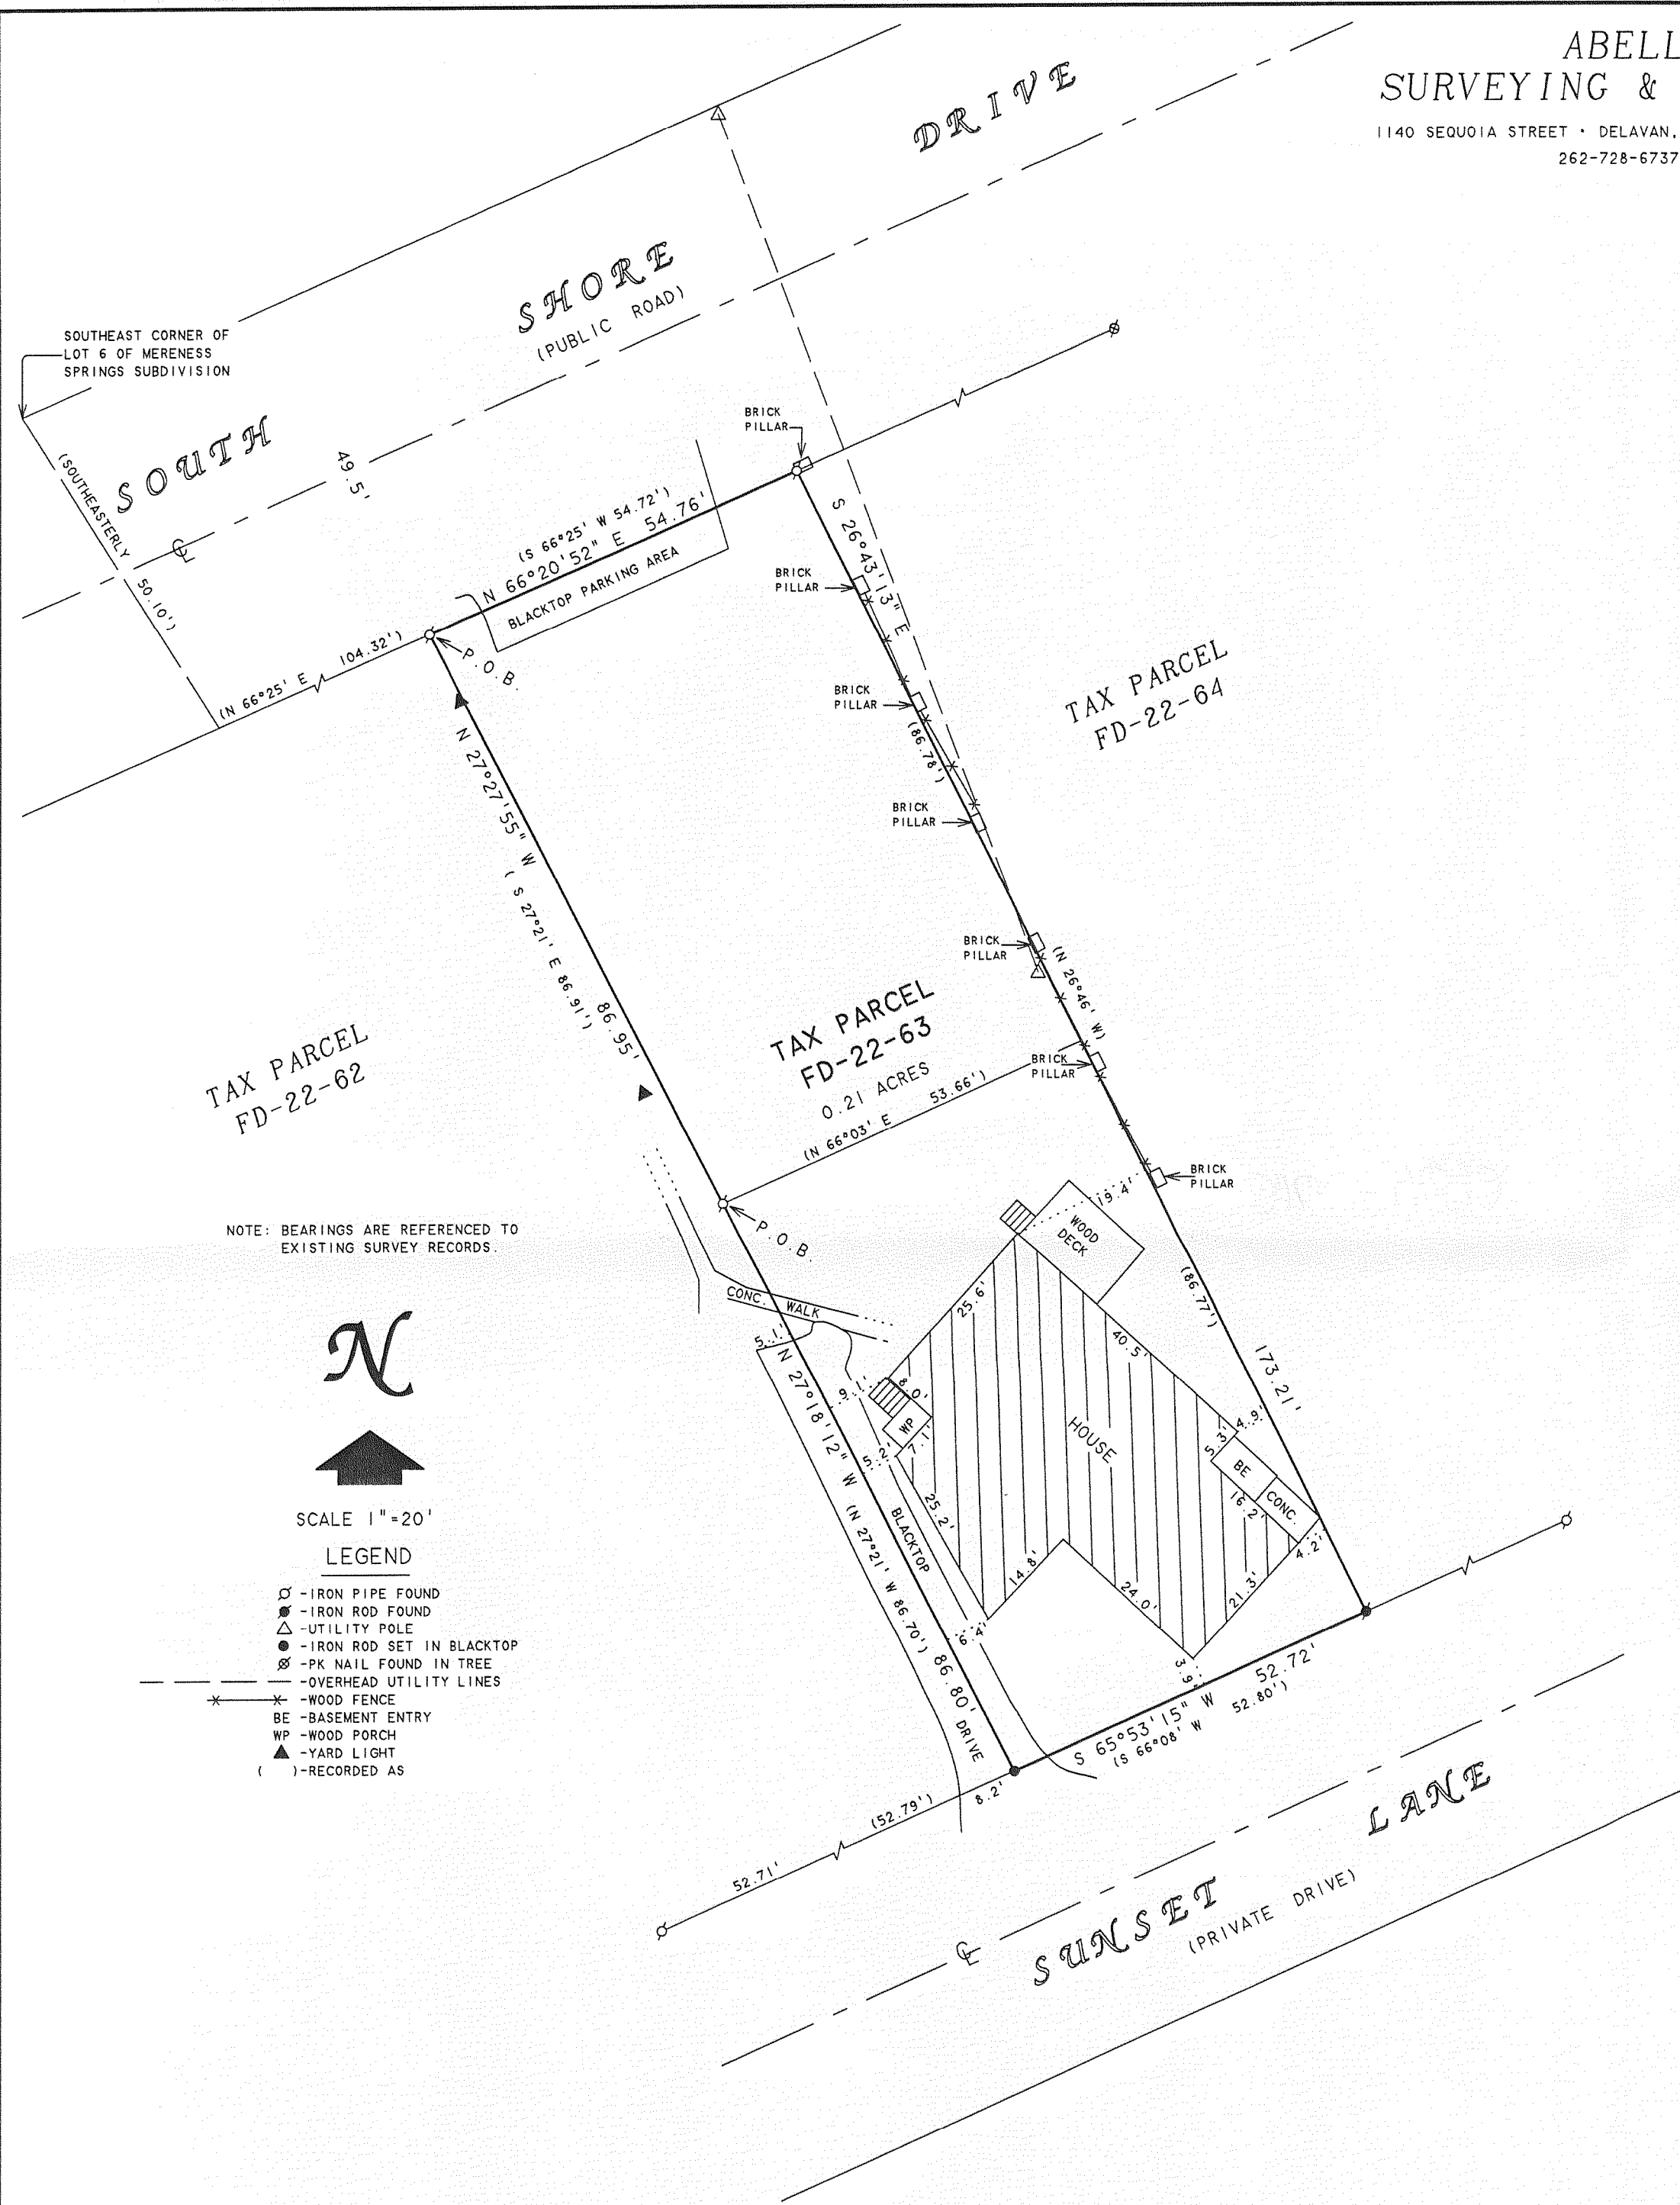


PLAT OF SURVEY OF  
QUIT CLAIM DEED 0505232

A parcel of land located in the Southeast 1/4 of Section 22, Town 2 North, Range 16 East of Walworth County, Wisconsin, described as follows, to-wit: Commencing at the Southeast corner of Lot 6 of Mereness Springs Subdivision, thence Southeasterly on a line that is the prolongation of the Easterly line of said Lot 6, 50.10 feet to an iron pipe in the Southeasterly line of the Public Road; thence North 66 degrees 25' East along said Southeasterly line of said Public Road 104.32 feet to an iron pipe as the place of beginning, thence South 27 degrees 21' East 86.91 feet to an iron pipe, thence North 66 degrees 03' East, 53.66 feet to an iron pipe, thence North 26 degrees 46' West, 86.78 feet to an iron pipe located in the Southeasterly line of said Public Road, thence South 66 degrees 25' West, 54.72 feet to the place of beginning.

The following parcel of land is to be added to the above described parcel and identified as Tax Parcel Number FD2200063.

A parcel of land located in the SE 1/4 of Section 22, T2N, R16E of Walworth County, Wisconsin, described as follows, to-wit: Commencing at the Southeast corner of Lot 6 of Mereness Springs Subdivision; thence Southeasterly on a line that is the prolongation of the Easterly line of said Lot 6 50.10 feet to an iron pipe in the Southeasterly line of the Public Road, thence North 66 degrees 25' East along said Southeasterly line of the road 104.32 feet; thence South 27 degrees 21' East 86.91 feet to an iron pipe at the place of beginning; thence North 66 degrees 03' East 53.66 feet to an iron pipe; thence South 26 degrees 46' East 86.77 feet to an iron pipe located on the Northwesterly line of a private road; thence South 66 degrees 08' West along said private road 52.80 feet to an iron pipe; thence North 27 degrees 21' West 86.70 feet to the place of beginning.

THE LEGAL DESCRIPTION RECORDED IN THE SHERIFF'S DEED DOCUMENT NUMBER 750214 RECORDED ON NOVEMBER 26, 2008 DOES NOT MATCH THE QUIT CLAIM DEED DOCUMENT NUMBER 0505232 RECORDED ON MARCH 28, 2002.

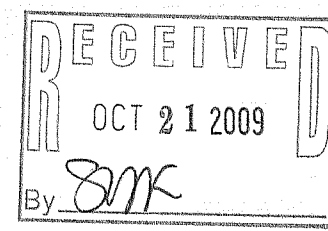

I HEREBY CERTIFY THAT I HAVE SURVEYED THE ABOVE DESCRIBED PROPERTY AND THAT THE ABOVE MAP IS A TRUE REPRESENTATION THEREOF AND SHOWS THE SIZE AND LOCATION OF THE PROPERTY, ITS EXTERIOR BOUNDARIES, THE LOCATION OF ALL VISIBLE STRUCTURES AND DIMENSIONS OF ALL PRINCIPAL BUILDINGS THEREON, BOUNDARY FENCES, APPARENT EASEMENTS, ROADWAYS AND VISIBLE ENCROACHMENTS, IF ANY, TO THE BEST OF MY KNOWLEDGE AND BELIEF.

THIS SURVEY IS MADE FOR THE USE OF THE PRESENT OWNERS OF THE PROPERTY, AND ALSO THOSE WHO PURCHASE, MORTGAGE, OR GUARANTEE THE TITLE THERETO WITHIN ONE (1) YEAR FROM DATE HEREON.

*David F. Abell*

DAVID F. ABELL  
WISCONSIN REGISTERED LAND SURVEYOR, S-1596

ORDERED BY: MARK ENDRESS  
BEST REALTY  
2213 PRAIRIE AVENUE  
BELOIT, WI 53511

May 11, 2009

DATE: May 11, 2009 JOB NUMBER - 09013  
NOTE: THIS IS NOT A CERTIFIED COPY UNLESS SEALED.

FD 22-63

216-4092