


HAROLD H. KOLB

REGISTERED PROFESSIONAL LAND SURVEYOR
LAKE GENEVA, WISCONSIN

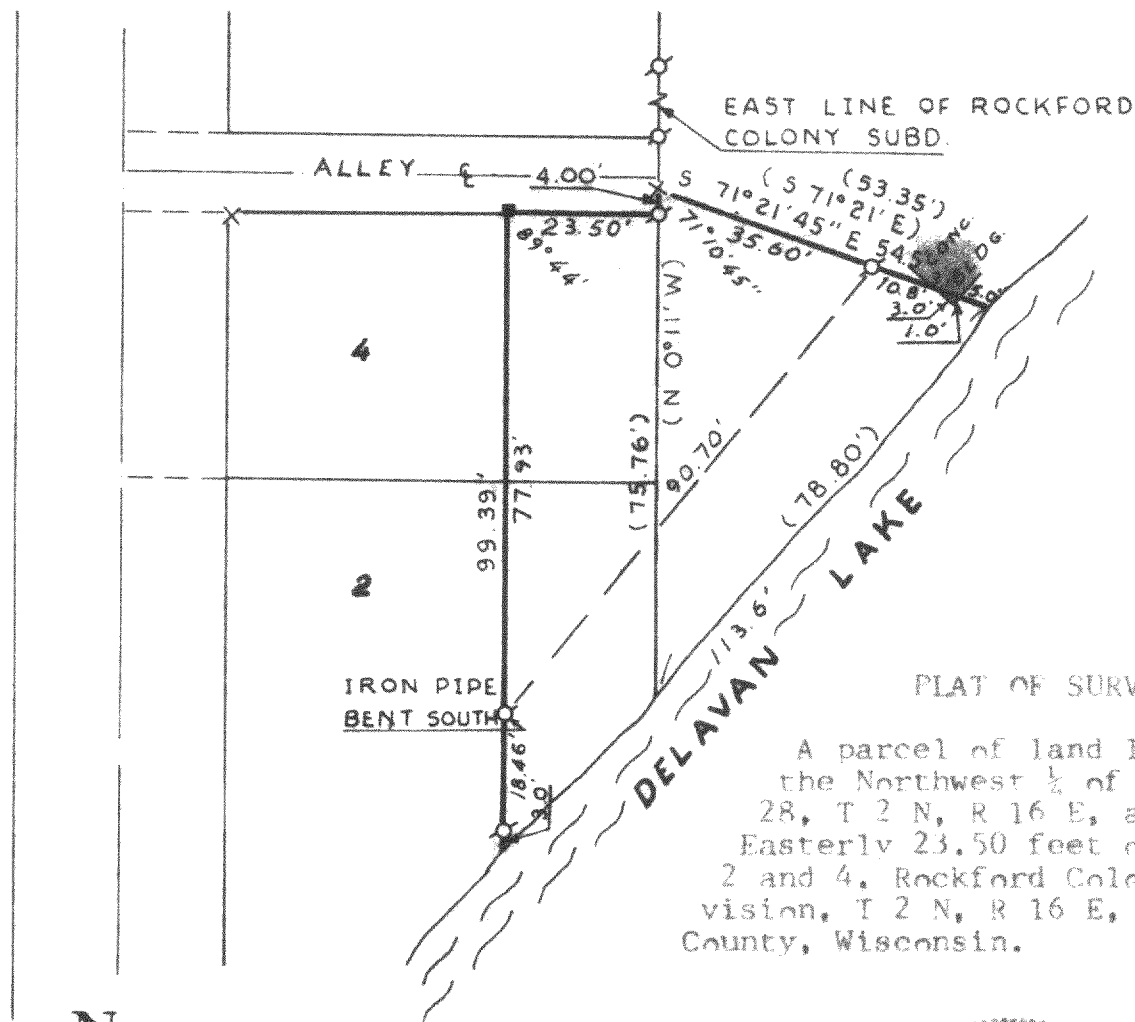

PLAT OF SURVEY OF

A parcel of land located in the Northwest $\frac{1}{4}$ of Section 28, T 2 N, R 16 E, and the Easterly 23.50 feet of Lots 2 and 4, Rockford Colony Subdivision, T 2 N, R 16 E, Walworth County, Wisconsin.


N



SCALE: 1"=30'

LEGEND

- φ — IRON PIPE FOUND
- — IRON PIPE PLACED
- — CONCRETE MONUMENT
- ✕ — CUT-CROSS IN CONCRETE
- — IRON BAR FOUND
- () — DESCRIBED AS

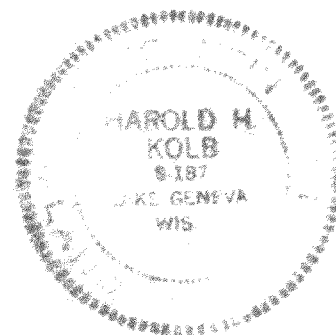

I, HAROLD H. KOLB, DO HEREBY CERTIFY THAT I HAVE SURVEYED THE PROPERTY HEREON DESCRIBED ACCORDING TO THE OFFICIAL RECORDS, AND THAT THE PLAT HEREON IS A CORRECT REPRESENTATION OF THE LOT LINES.

Harold H. Kolb

HAROLD H. KOLB
WISCONSIN REGISTERED LAND SURVEYOR, S-187

DATE Jan 4, 1974

FRUC-2
11-6

D-28-11F

216-470