


FARRIS, HANSEN & ASSOCIATES, INC.

ENGINEERING — ARCHITECTURE — SURVEYING
7 RIDGWAY COURT — P.O. BOX 437 — ELKHORN, WISCONSIN 53121
PHONE: (262) 723-2098 FAX: (262) 723-5886


PLAT OF SURVEY

LOTS 5 & 6, BLOCK 7, INLET OAKS SUBDIVISION NO. 4
LOCATED IN PART OF THE SE 1/4 OF THE SE 1/4 OF
SECTION 15, TOWN 2 NORTH, RANGE 16 EAST,
WALWORTH COUNTY, WISCONSIN

— WORK ORDERED BY —
ANTHONY SCHROEDER
307 INLET SHORE DRIVE
DELAVER, WISCONSIN 53115

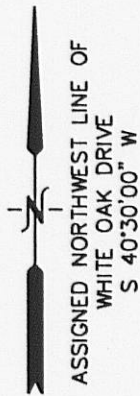

- LEGEND
- = FOUND IRON PIPE STAKE
 - × = SET HUB ON PROPERTY LINE
 - {xxx} = RECORDED AS

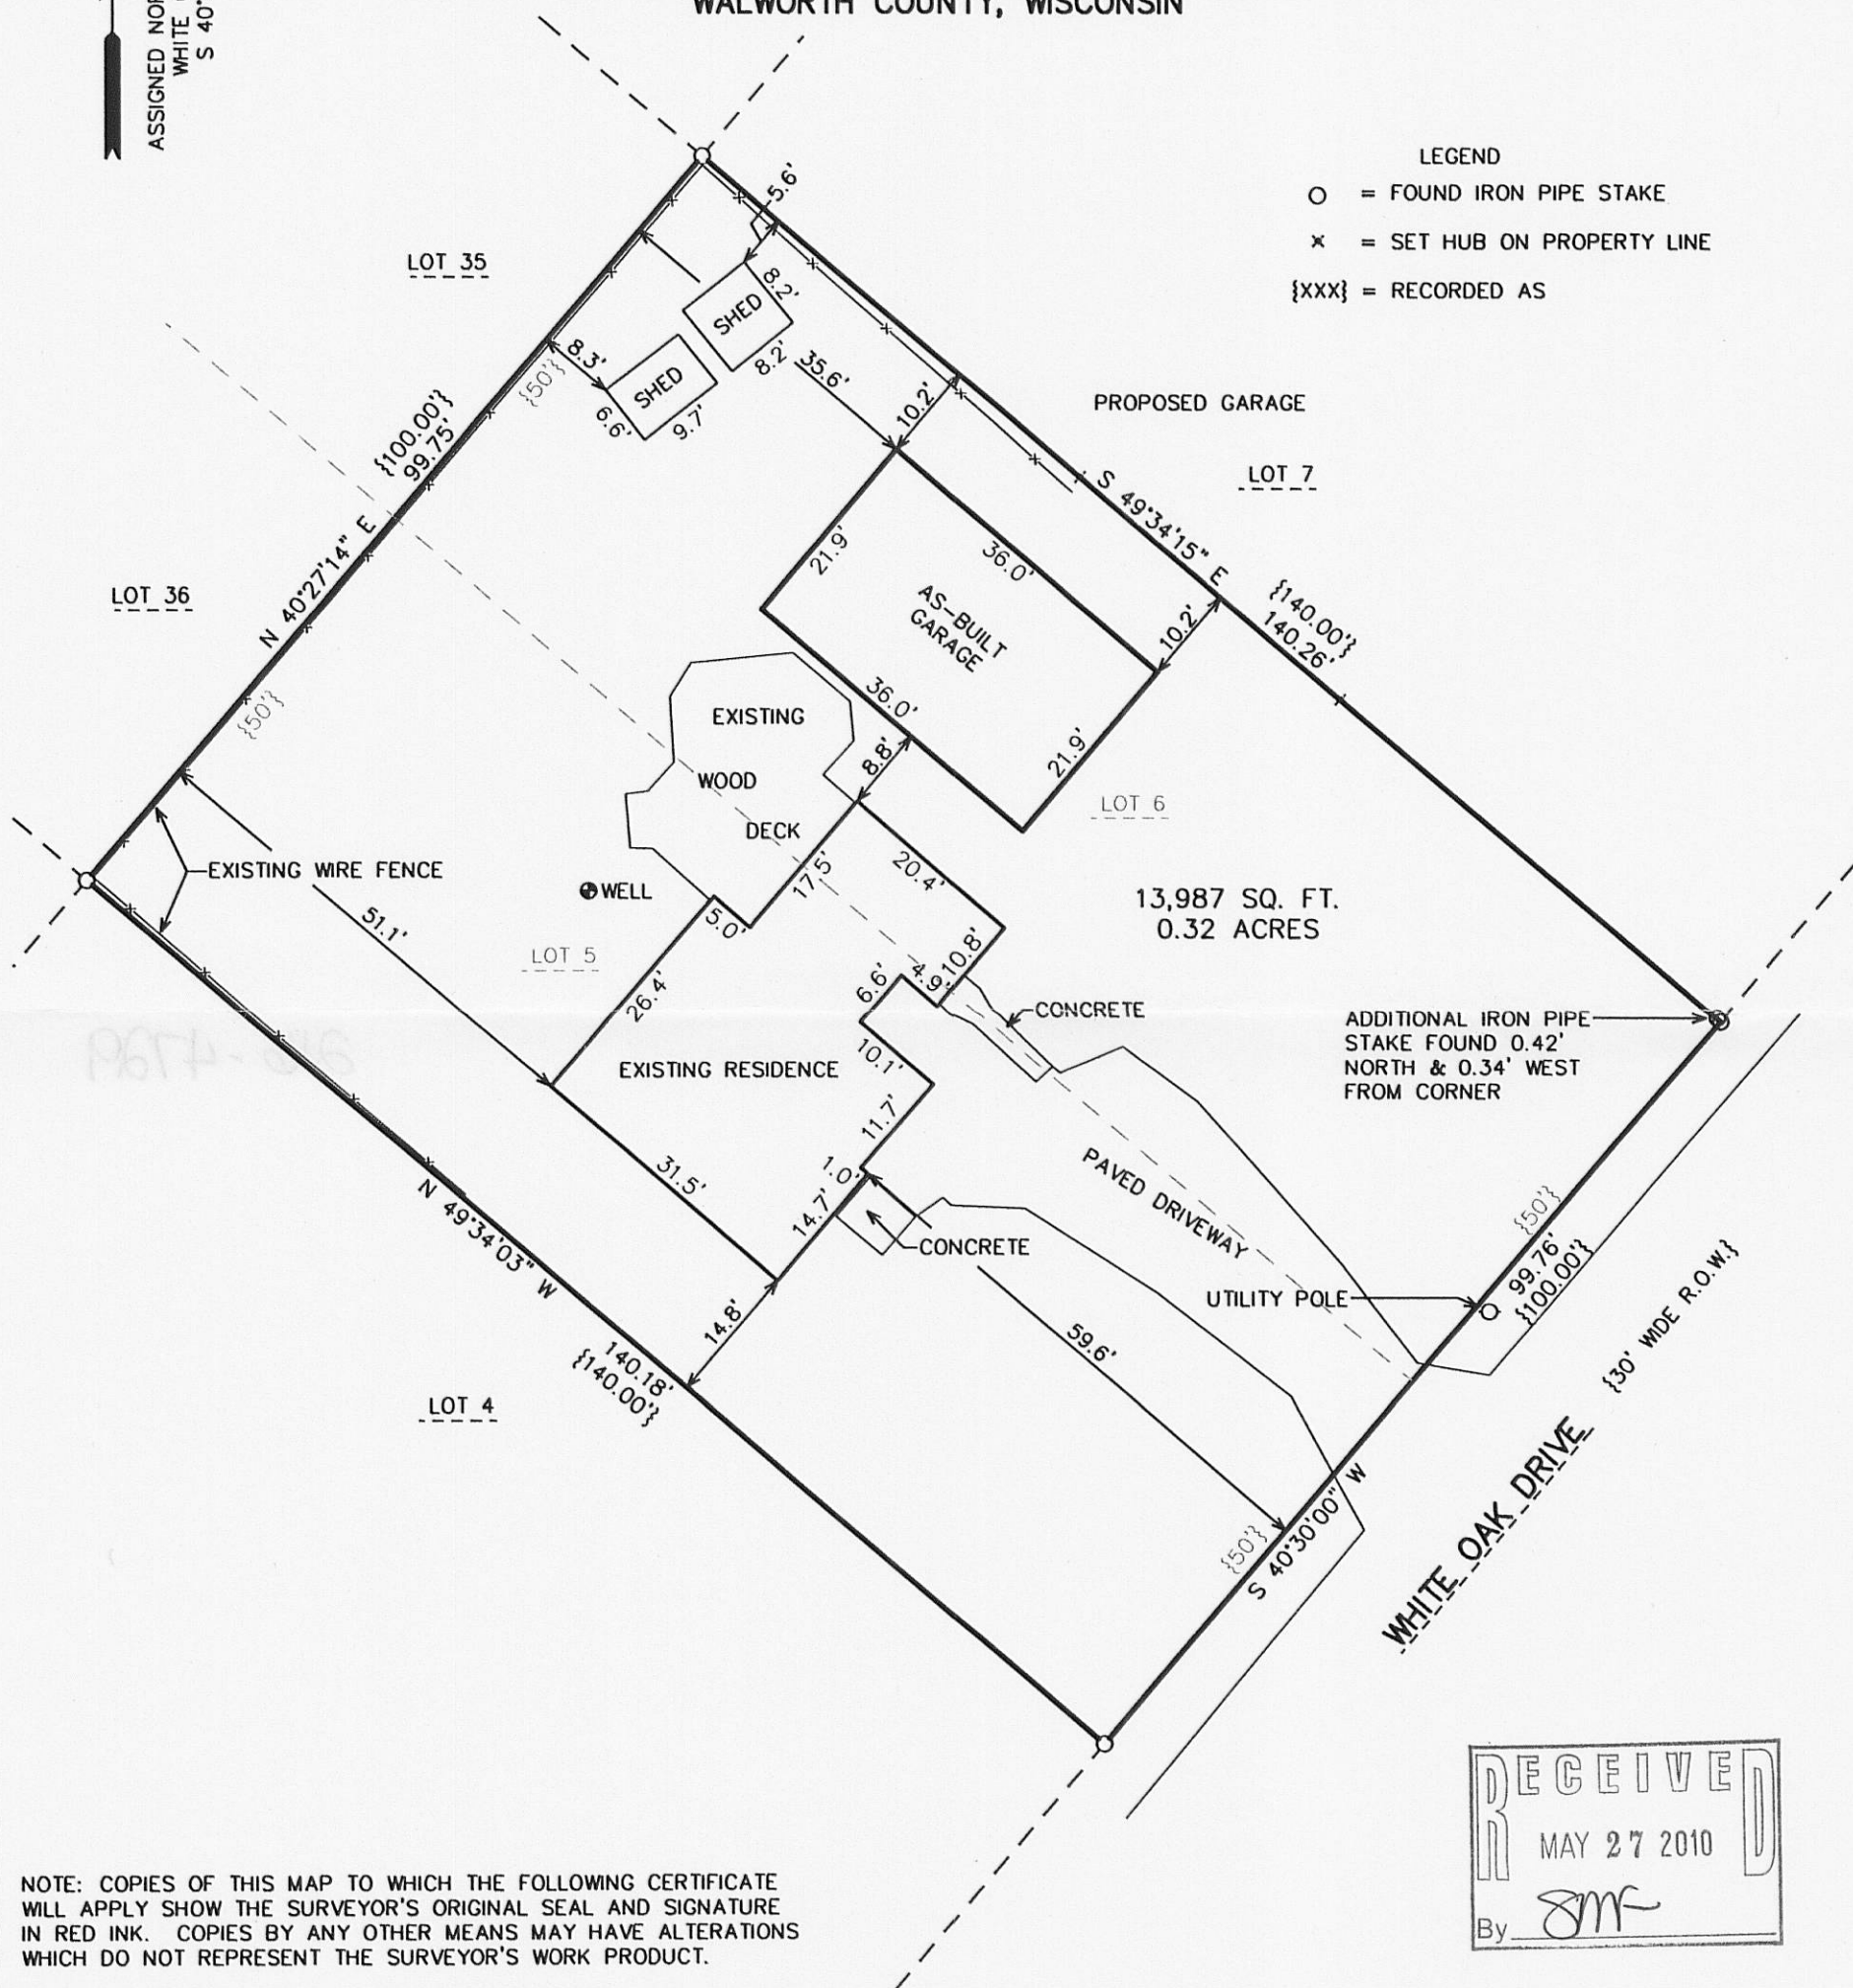




NOTE: COPIES OF THIS MAP TO WHICH THE FOLLOWING CERTIFICATE WILL APPLY SHOW THE SURVEYOR'S ORIGINAL SEAL AND SIGNATURE IN RED INK. COPIES BY ANY OTHER MEANS MAY HAVE ALTERATIONS WHICH DO NOT REPRESENT THE SURVEYOR'S WORK PRODUCT.

I HEREBY CERTIFY THAT THE ABOVE DESCRIBED PROPERTY HAS BEEN SURVEYED UNDER MY DIRECTION AND THAT THE ABOVE MAP IS A TRUE REPRESENTATION THEREOF AND SHOWS THE SIZE AND LOCATION OF THE PROPERTY AND ITS EXTERIOR BOUNDARIES. THIS SURVEY IS MADE FOR THE USE OF THE PRESENT OWNERS OF THE PROPERTY, AND ALSO THOSE WHO PURCHASE, MORTGAGE, OR GUARANTEE THE TITLE THERETO WITHIN ONE YEAR FROM THE DATE HEREOF.

DATED: MARCH 30, 2010

REVISED: 5/6/2010-KB
TO SHOW SIZE & LOCATION OF
AS-BUILT GARAGE

PETER S. GORDON R.L.S. 2101

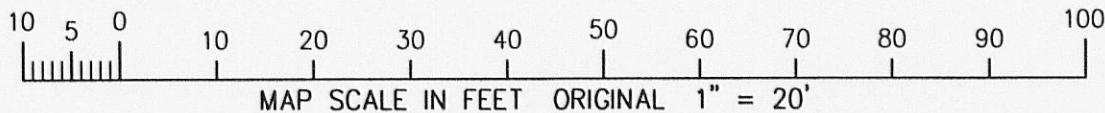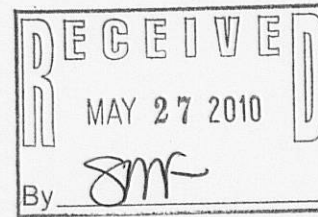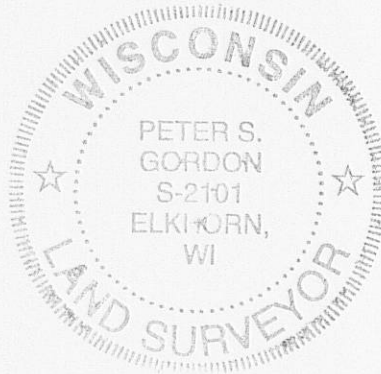

PROJECT: 8098
DATE: 3/30/2010
SHEET 1 OF 1