

PREPARED FOR
NANCY GENTILE
3483 FOXTAIL LN
DELAVER WI 53115





PLAT OF SURVEY

-OF-


LOT 10, COUNTRY VIEW SUBDIVISION, LOCATED IN
THE SOUTHWEST 1/4 OF SECTION 23, TOWN 2 NORTH.
RANGE 16 EAST, WALWORTH COUNTY, WISCONSIN.

KROTT SURVEYING INC.

N3705 WILLOW BEND LANE
LAKE GENEVA WI. 53147
PHONE # (262)248-3697
FAX # (262)249-0639

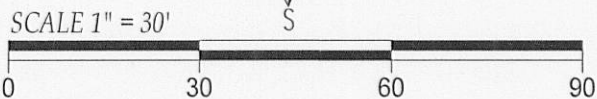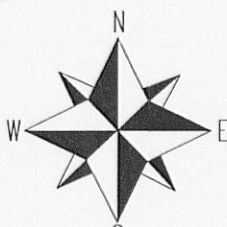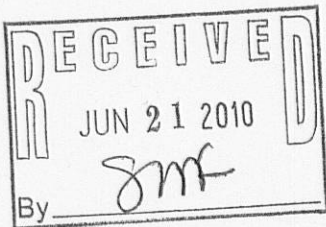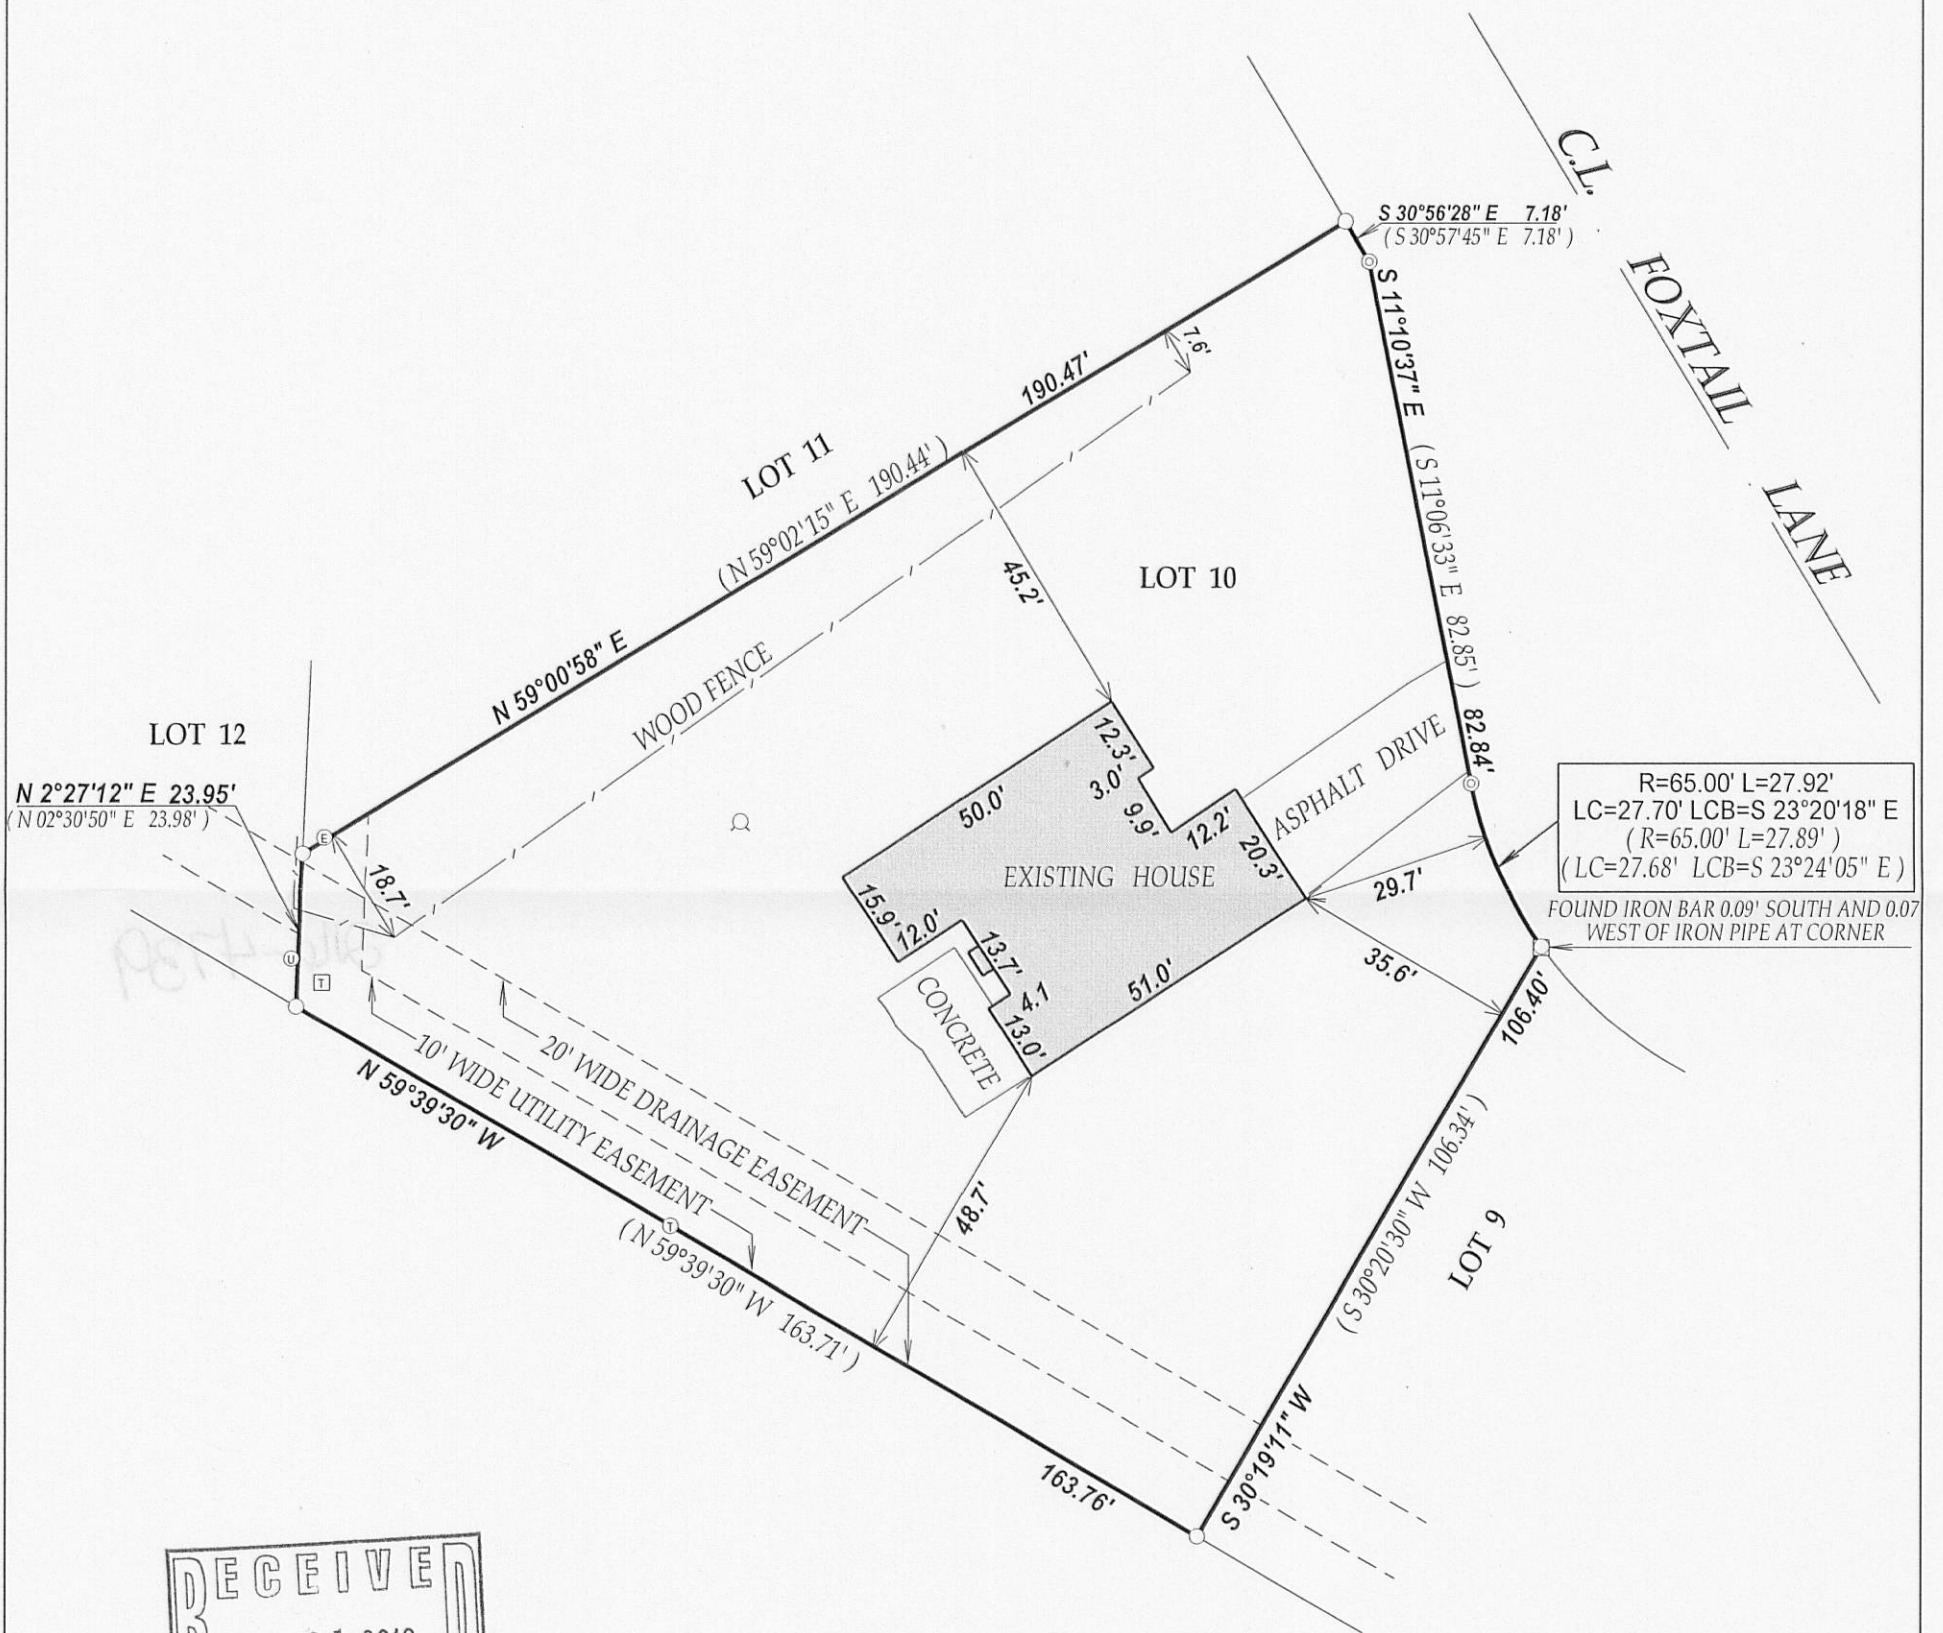

NOTE: BEARINGS ARE REFERENCED TO THE RECORD PLAT OF COUNTRY VIEW SUB.

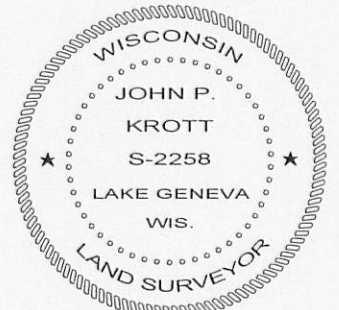

DATED THIS 15th DAY OF JUNE 2010.

John P. Krott

JOHN KROTT S - 2258
Wisconsin Registered Land Surveyor
(original if signed in red)

(xx) RECORDED AS

TAX ID # FCV00010

JOB # 10-095