


GEORGE T. DUNHAM
SURVEYING & SUBDIVIDING
DELAVER, WISCONSIN

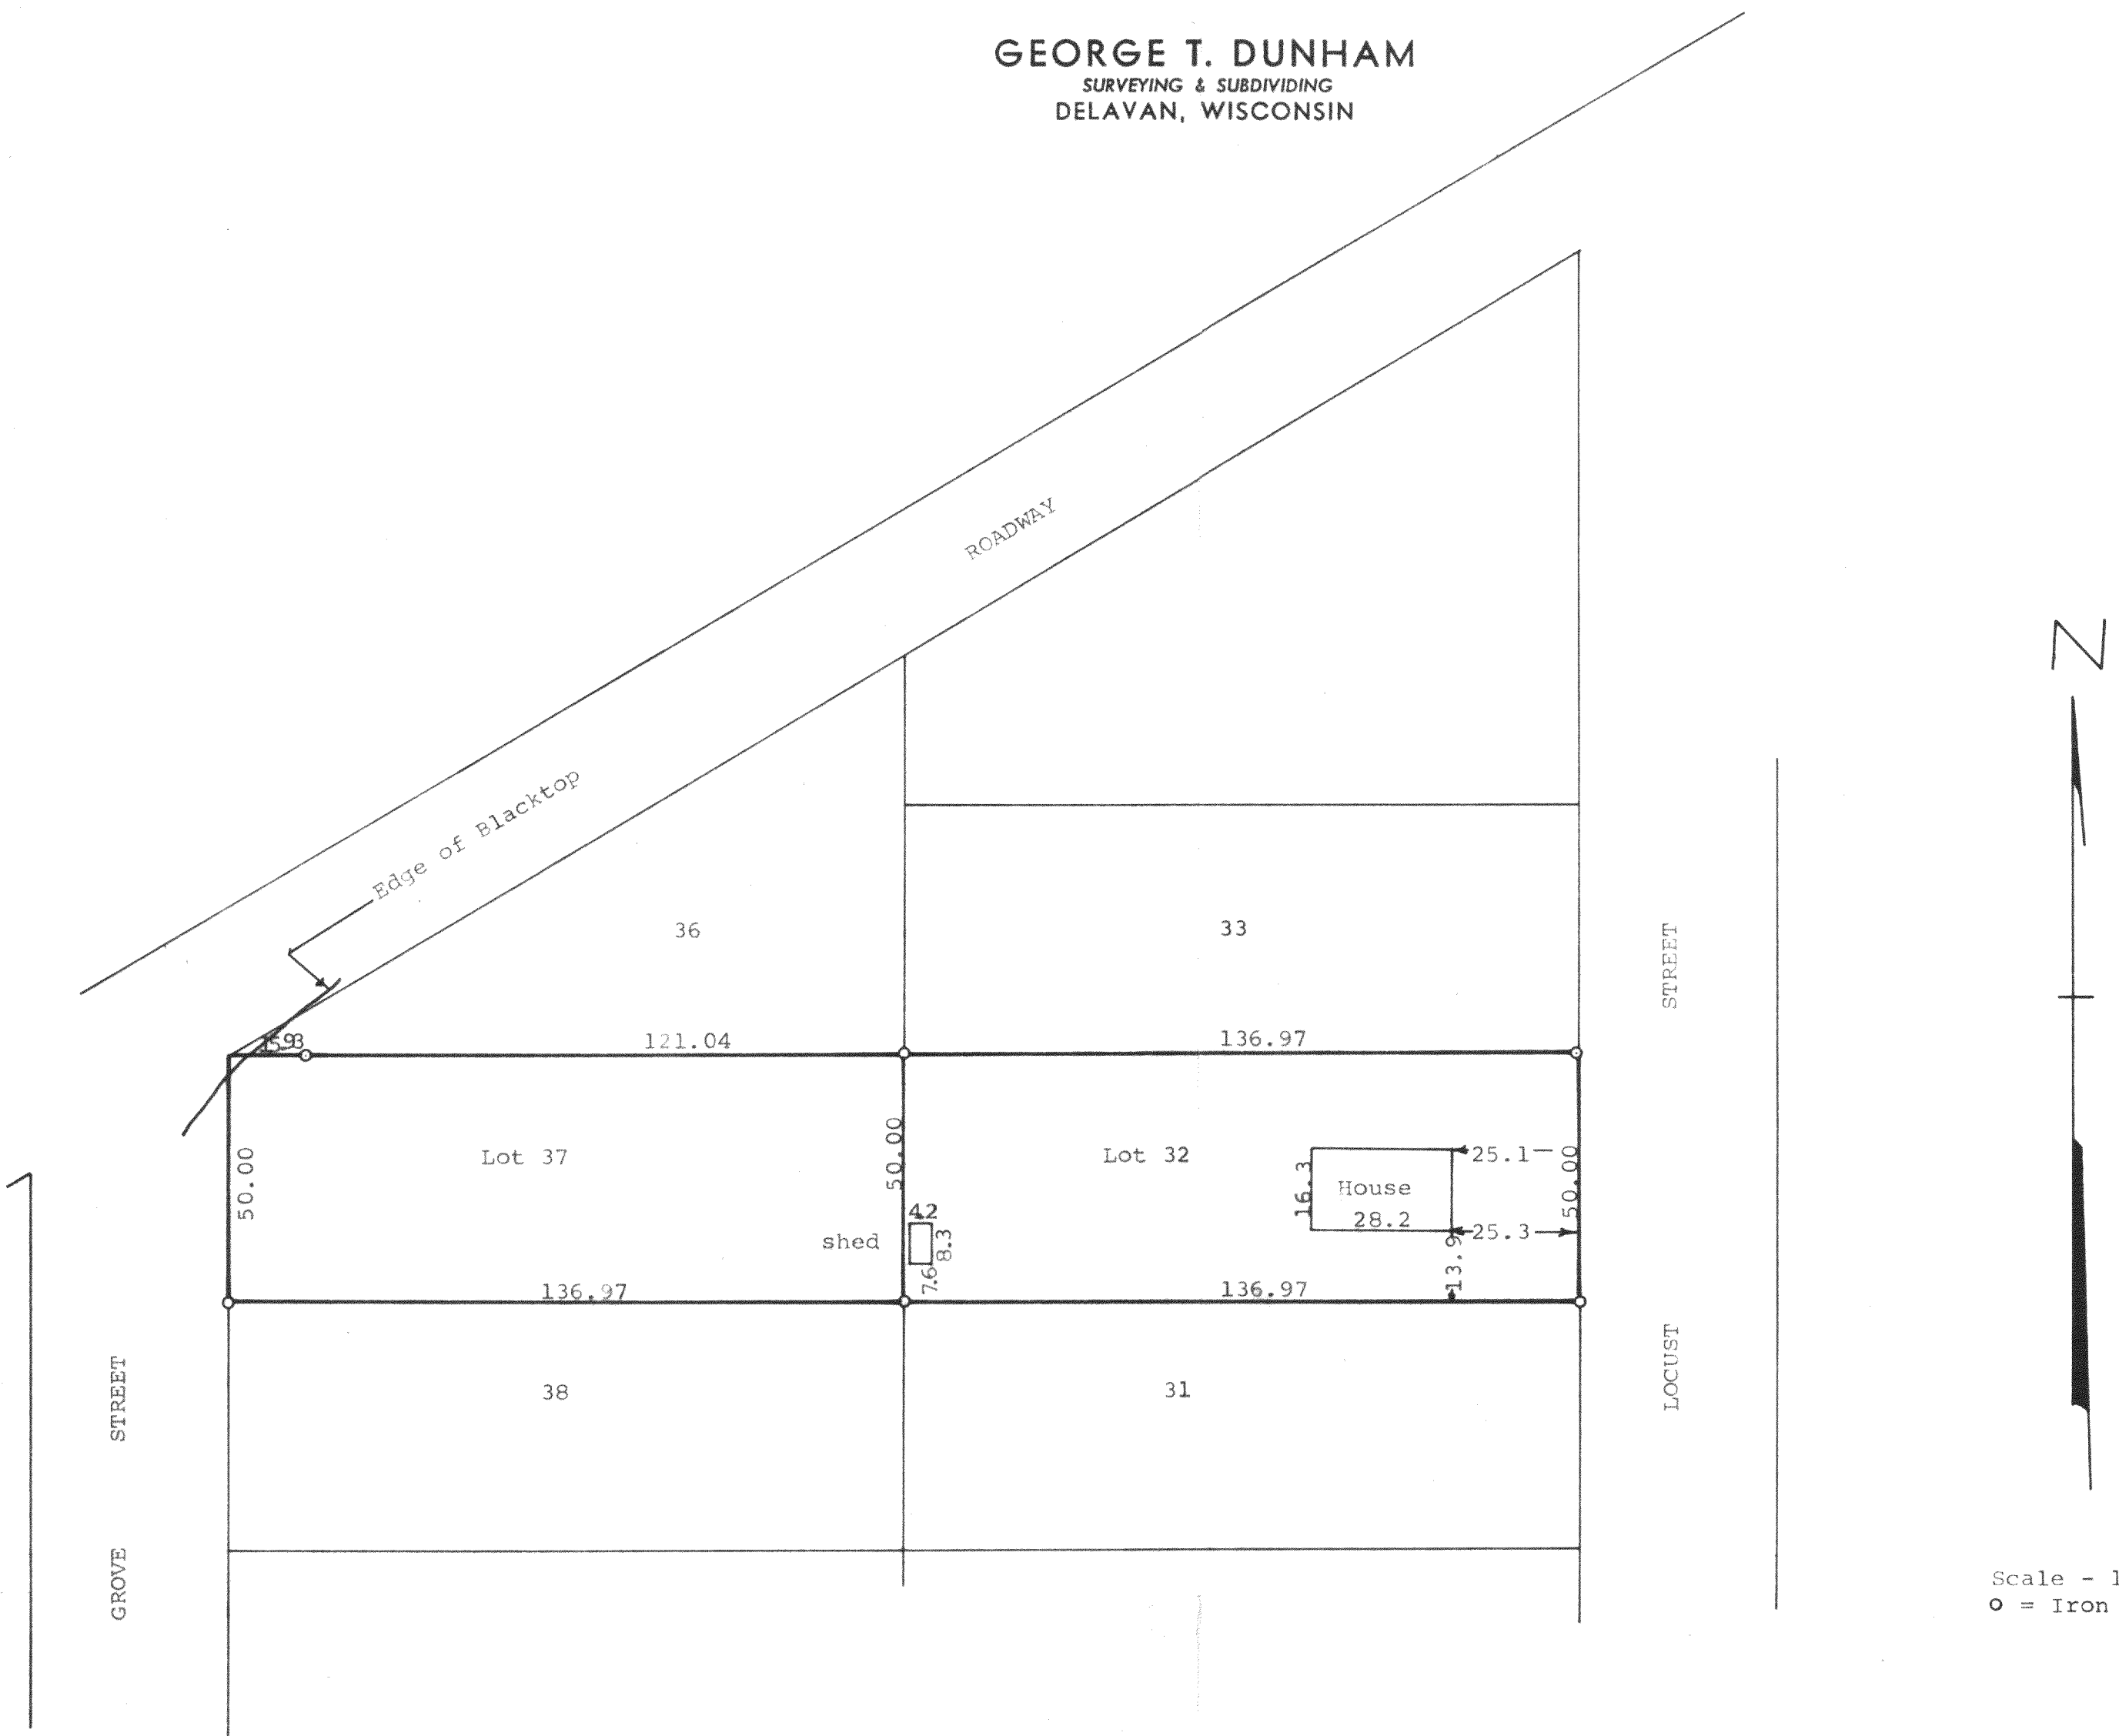

Scale - 1" = 30'
○ = Iron Pipe

STATE OF WISCONSIN)
COUNTY OF WALWORTH) SS

I, George T. Dunham, Surveyor, certify that I have surveyed the property described as follows,

Lots 32 and 37 in Lake View Subdivision located in Section 32, T 2 N, R 16 E, Walworth County, Wisconsin, and that the above map is a true representation thereof and shows the size and location of the property, its exterior boundaries, location and dimensions of all structures thereon, apparent easements and there are no visible encroachments other than the edge of the blacktop roadway.

May 24, 1974

George T. Dunham
George T. Dunham, Surveyor

