

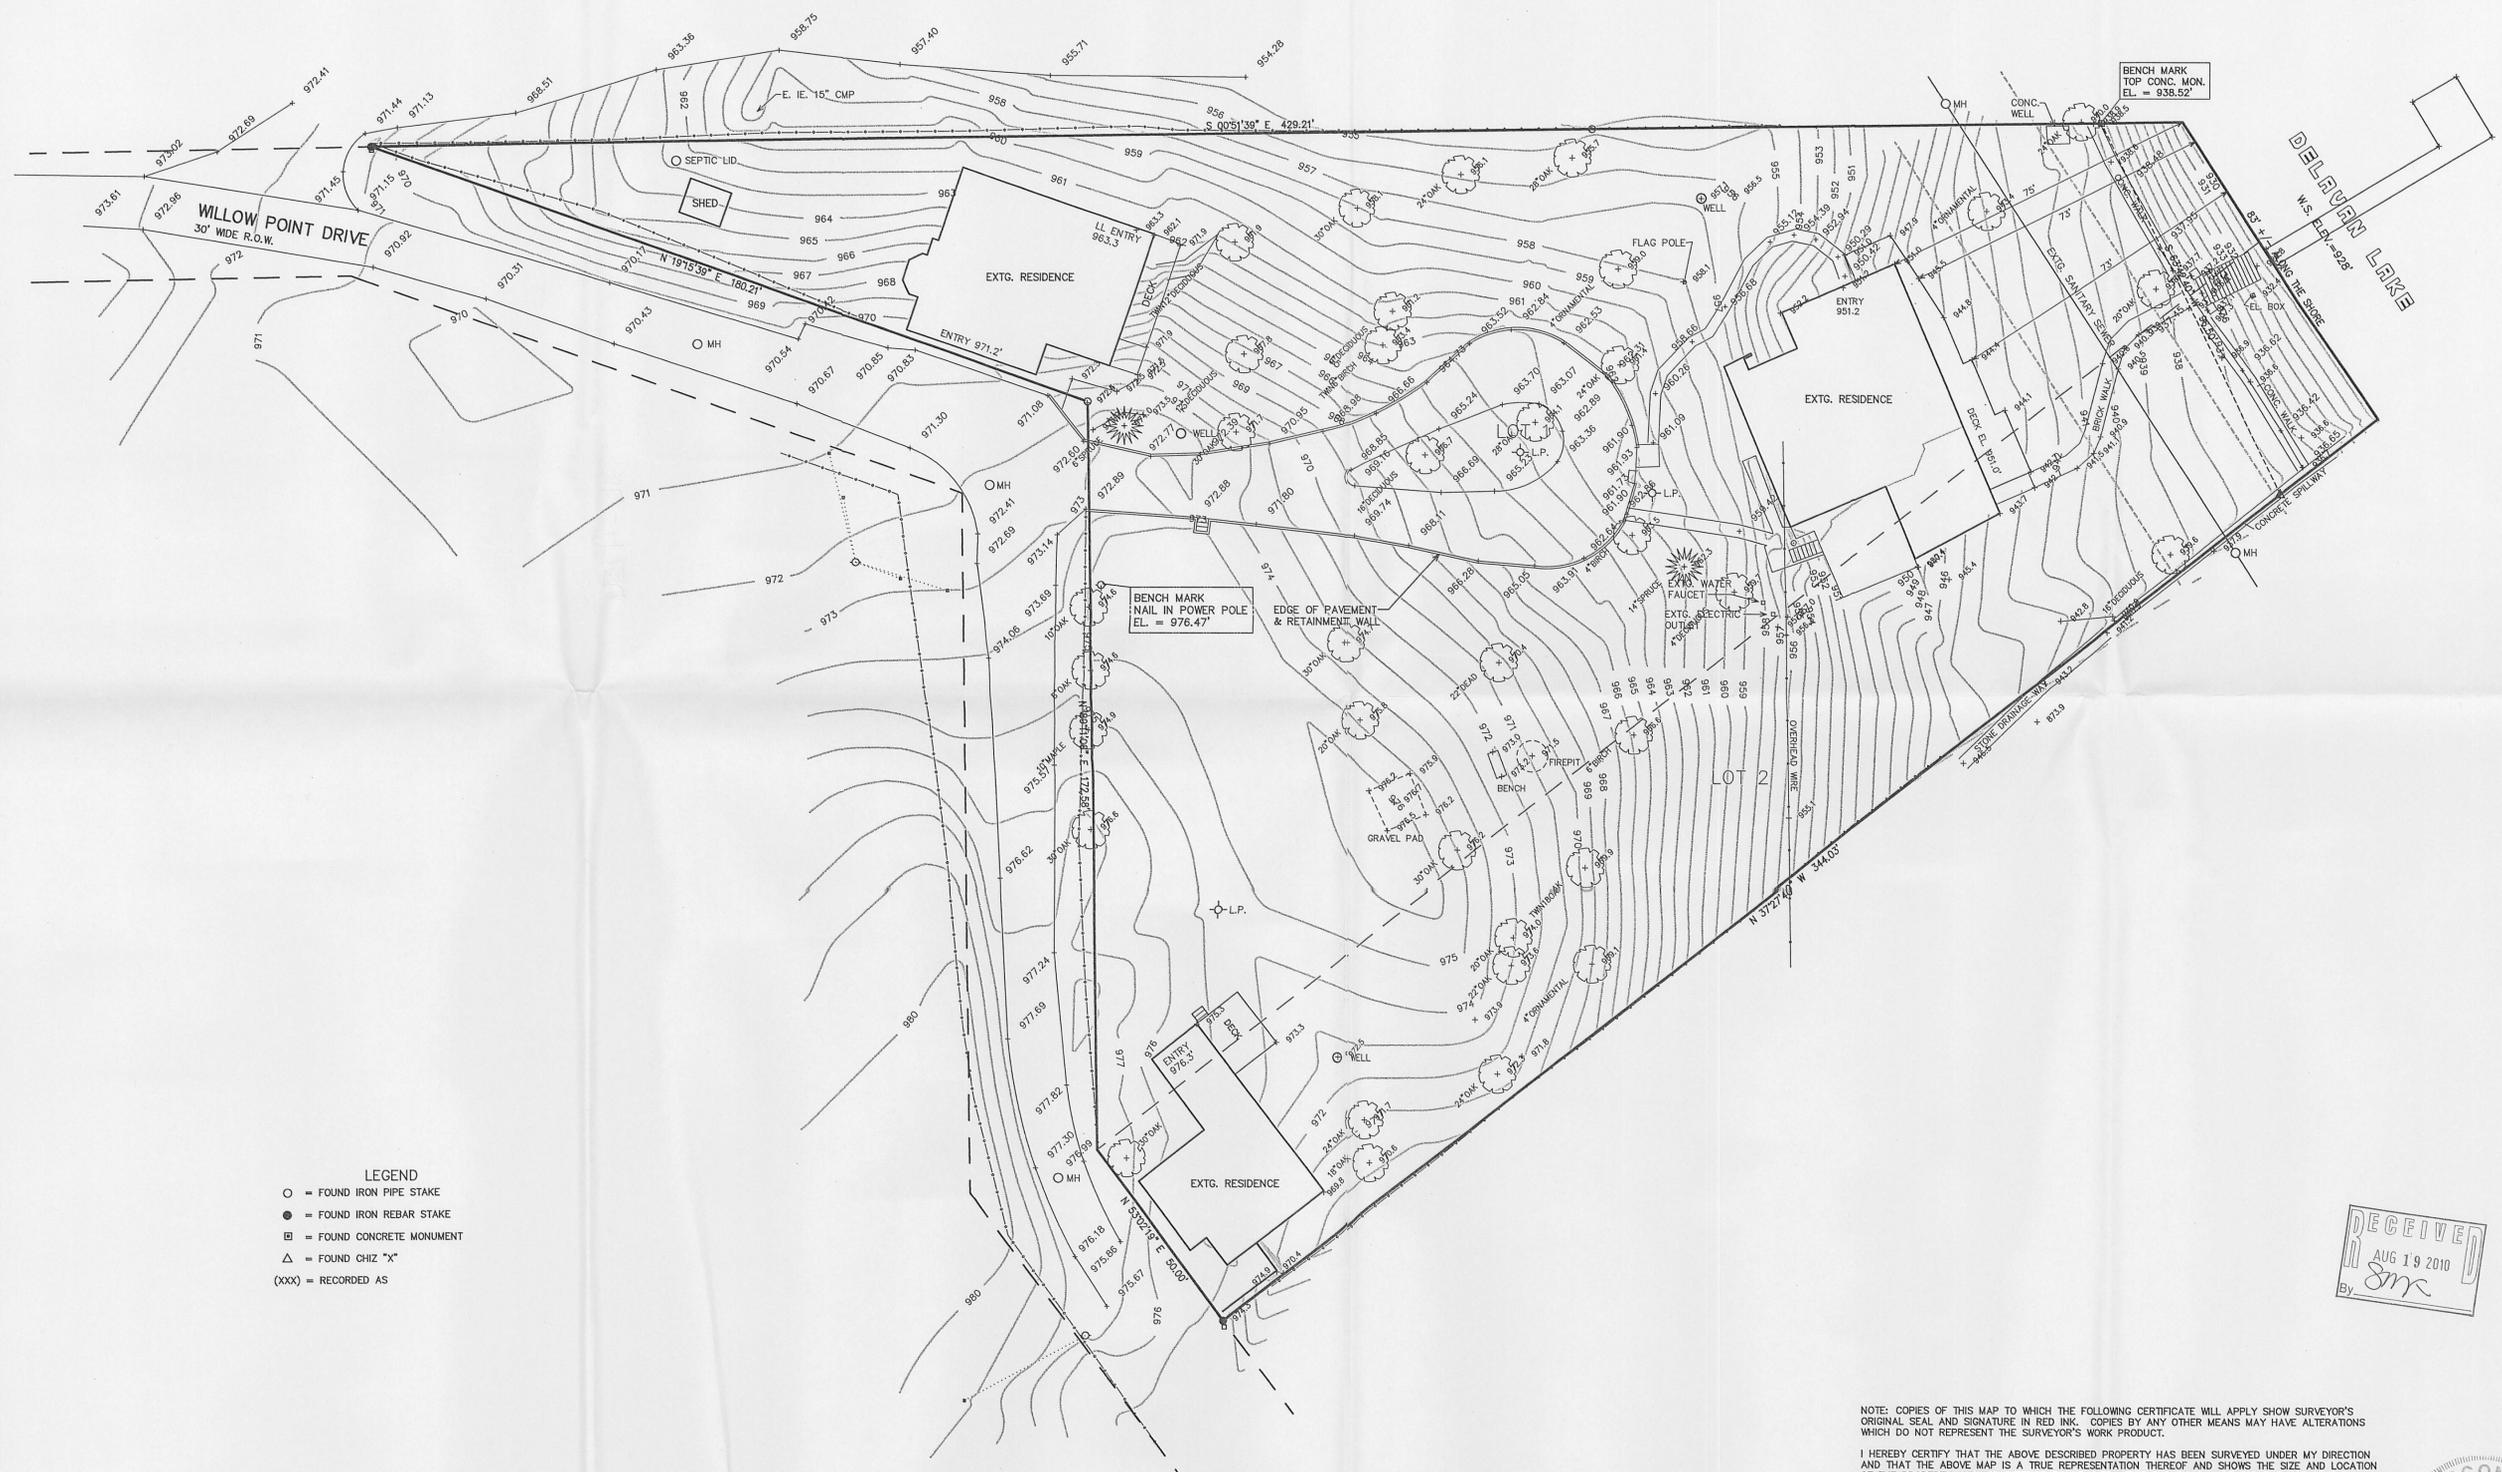


BOUNDARY & TOPOGRAPHIC SURVEY
LOTS 1 & 2 OF WILLOW POINT PARK,
 LOCATED IN THE SE 1/4 OF SECTION 29, TOWN 2 NORTH,
 RANGE 16 EAST, WALWORTH COUNTY, WISCONSIN

ASSIGNED EAST LINE LOT 1
 S 00°51'39" E

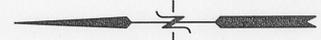

- LEGEND**
- = FOUND IRON PIPE STAKE
 - = FOUND IRON REBAR STAKE
 - = FOUND CONCRETE MONUMENT
 - △ = FOUND CHIZ "X"
 - (xxx) = RECORDED AS

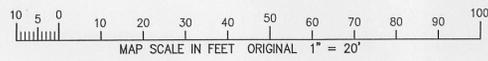

RECEIVED
 AUG 19 2010
 By *sm*

NOTE: COPIES OF THIS MAP TO WHICH THE FOLLOWING CERTIFICATE WILL APPLY SHOW SURVEYOR'S ORIGINAL SEAL AND SIGNATURE IN RED INK. COPIES BY ANY OTHER MEANS MAY HAVE ALTERATIONS WHICH DO NOT REPRESENT THE SURVEYOR'S WORK PRODUCT.

I HEREBY CERTIFY THAT THE ABOVE DESCRIBED PROPERTY HAS BEEN SURVEYED UNDER MY DIRECTION AND THAT THE ABOVE MAP IS A TRUE REPRESENTATION THEREOF AND SHOWS THE SIZE AND LOCATION OF THE PROPERTY AND ITS EXTERIOR BOUNDARIES. THIS SURVEY IS MADE FOR THE USE OF THE PRESENT OWNERS OF THE PROPERTY, AND ALSO THOSE WHO PURCHASE, MORTGAGE, OR GUARANTEE THE TITLE THERETO WITHIN ONE YEAR FROM THE DATE HEREOF.

DATED: JULY 27, 2010

Peter S. Gordon
 PETER S. GORDON R.L.S. 2101



WORK ORDERED BY:
 SCOTT STONEBREAKER
 PO BOX 5534
 ELGIN, IL 60121

FARRIS, HANSEN & ASSOCIATES, INC.
 ENGINEERING - ARCHITECTURE - SURVEYING
 7 RIDGWAY COURT P.O. BOX 437
 ELKHORN, WISCONSIN 53121
 OFFICE: (262) 723-2088 FAX: (262) 723-5886

REVISIONS

PROJECT NO.
5292.10
 DATE
07-27-2010
 SHEET NO.
1 OF 1

FW1-1

216-4756

JUL 23 2010

7/27/2010 x:\Projects\5292\DCAD\2010