


PREPARED FOR:  
HOMESTEAD REALTY  
520 BROAD STREET  
LAKE GENEVA, WI  
53147




PATHFINDER SURVEYING INC.  
(formerly)  
J.K. SURVEYING INC.  
W2888 KRUEGER RD. STE. "D"  
262-248-8303

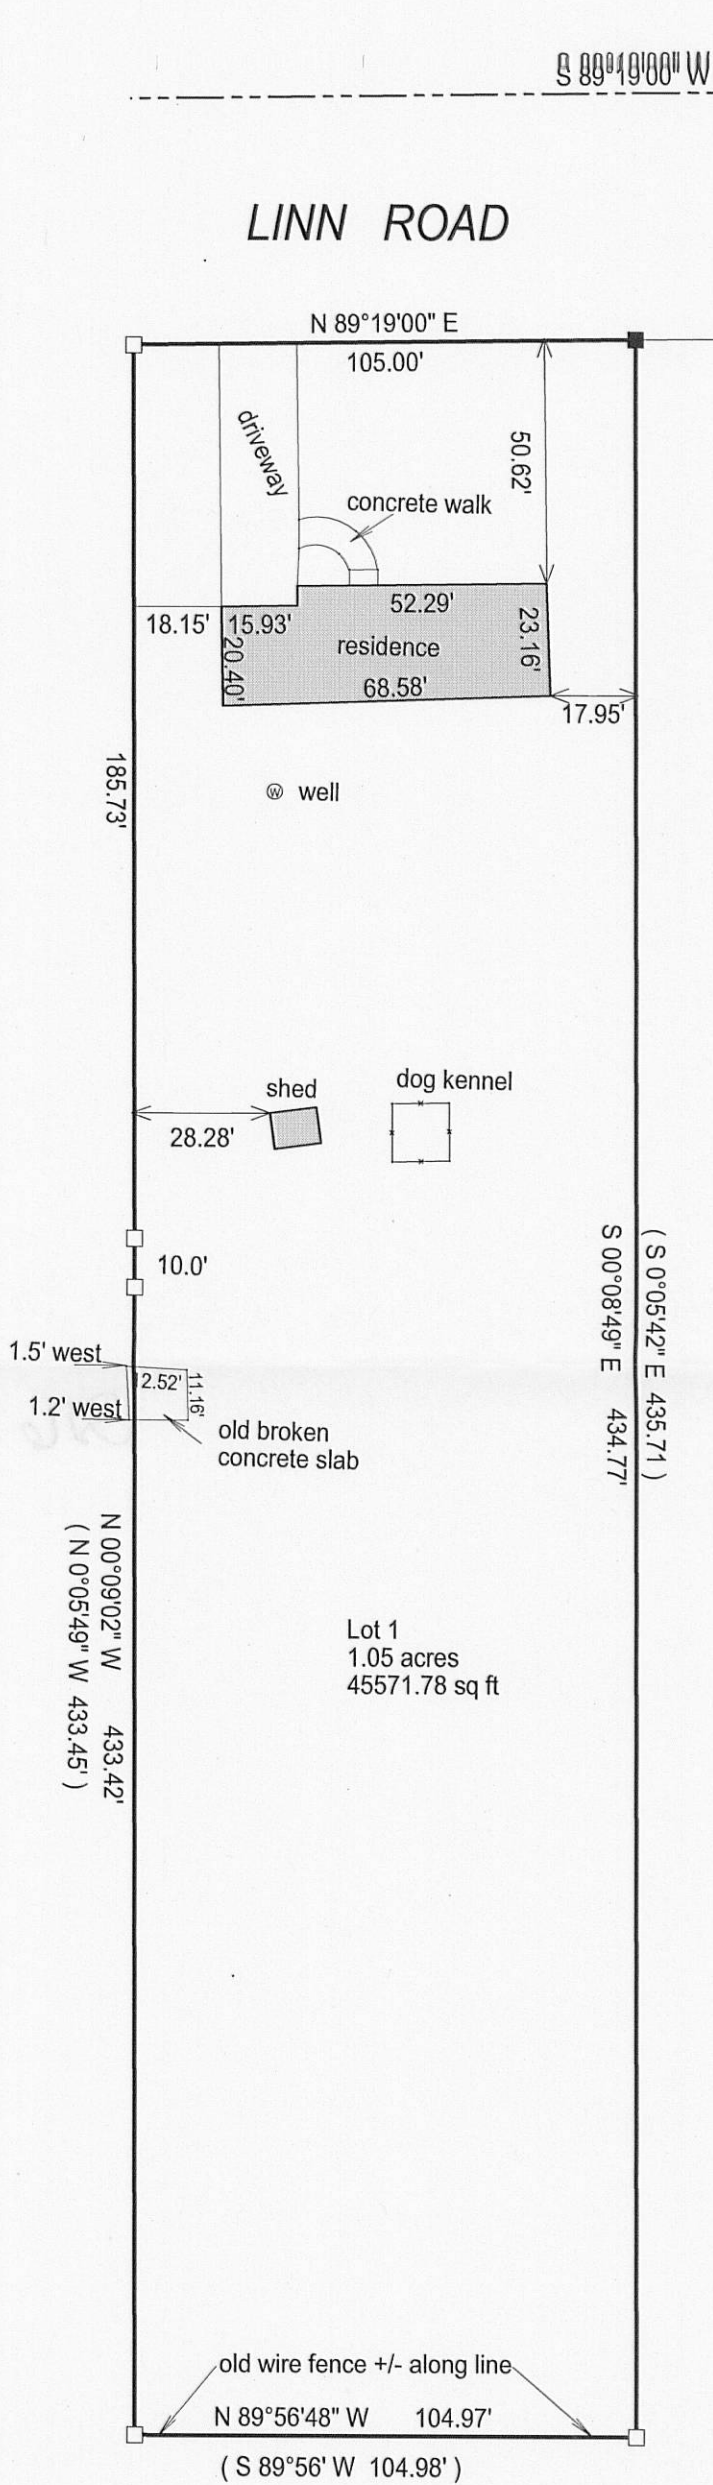

# PLAT OF SURVEY

- OF -

LOT 1 OF WALWORTH COUNTY CERTIFIED SURVEY  
MAP No. 2471, LOCATED IN THE NE 1/4 OF THE NW 1/4  
OF SECTION 28, TOWN 2 NORTH, RANGE 16 EAST  
OF THE FOURTH PRINCIPAL MERIDIAN, TOWN OF  
DELAVER, COUNTY OF WALWORTH AND STATE OF  
WISCONSIN.

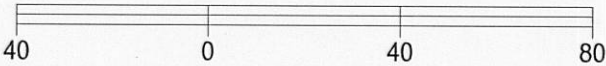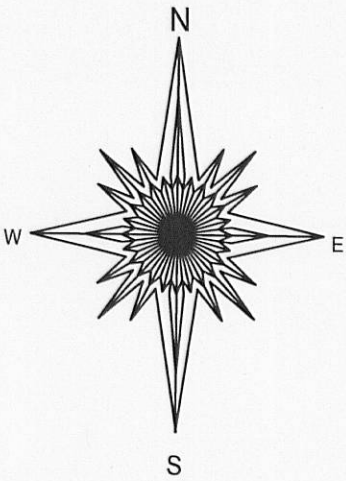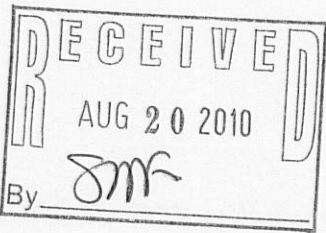

BASIS OF BEARING OF THIS PLAT: THE SOUTH LINE  
OF LINN RD WAS ASSUMED TO BEAR N89°19' E.  
AS SHOWN ON THE CSM OF RECORD.

- ( ) = recorded as
- = found iron bar
- = found iron pipe
- = set iron pipe
- = set iron bar

SCALE 1" = 40'

JOB # 10-26

TAX ID #  
FA247100001

COMPARE LEGAL DESCRIPTION ABOVE AND DRAWING WITH DEED. FOR BUILDING RESTRICTIONS AND  
EASEMENTS NOT SHOWN, REFER TO DEED, ABSTRACT SOURCES AND LOCAL MUNICIPAL CODES. NOTIFY  
THE SURVEYOR IMMEDIATELY OF ANY DISCREPANCY.

"I hereby certify that I have surveyed the above described property and that  
the above map is a true representation thereof and shows the size and  
location of all visible structures, apparent easements and encroachments  
if any."  
This survey is made for the present owners of the property, and those who  
purchase, mortgage, or guarantee the title thereto, within one year from  
the date hereof.

DATED THIS 18TH DAY OF MARCH, 2010.



JEFFREY L. KIMPS S - 2436  
Wisconsin Registered Land Surveyor  
(original if signed in red)