

PREPARED FOR:


LUANNE SMITH
KEEFE REAL ESTATE
751 GENEVA PARKWAY
LAKE GEVEVA, WI.

PLAT OF SURVEY


- OF -

PATHFINDER SURVEYING INC.
(formerly)
J.K. SURVEYING INC.
W2888 KRUEGER RD. STE. "D"
262-248-8303

LOTS 25 AND THE WEST 1/2 OF LOT 24, BLOCK 3 INLET OAKS SUBDIVISION
No. 3, LOCATED IN SECTIONS 15 AND 22, TOWN 2 NORTH, RANGE 16 EAST
OF THE FOURTH PRINCIPAL MERIDIAN, TOWN OF DELAVAN, COUNTY OF
WALWORTH AND STATE OF WISCONSIN.

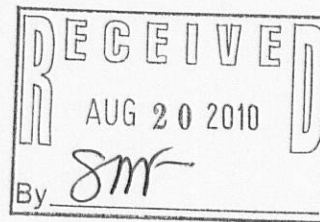

BREEZY DRIVE

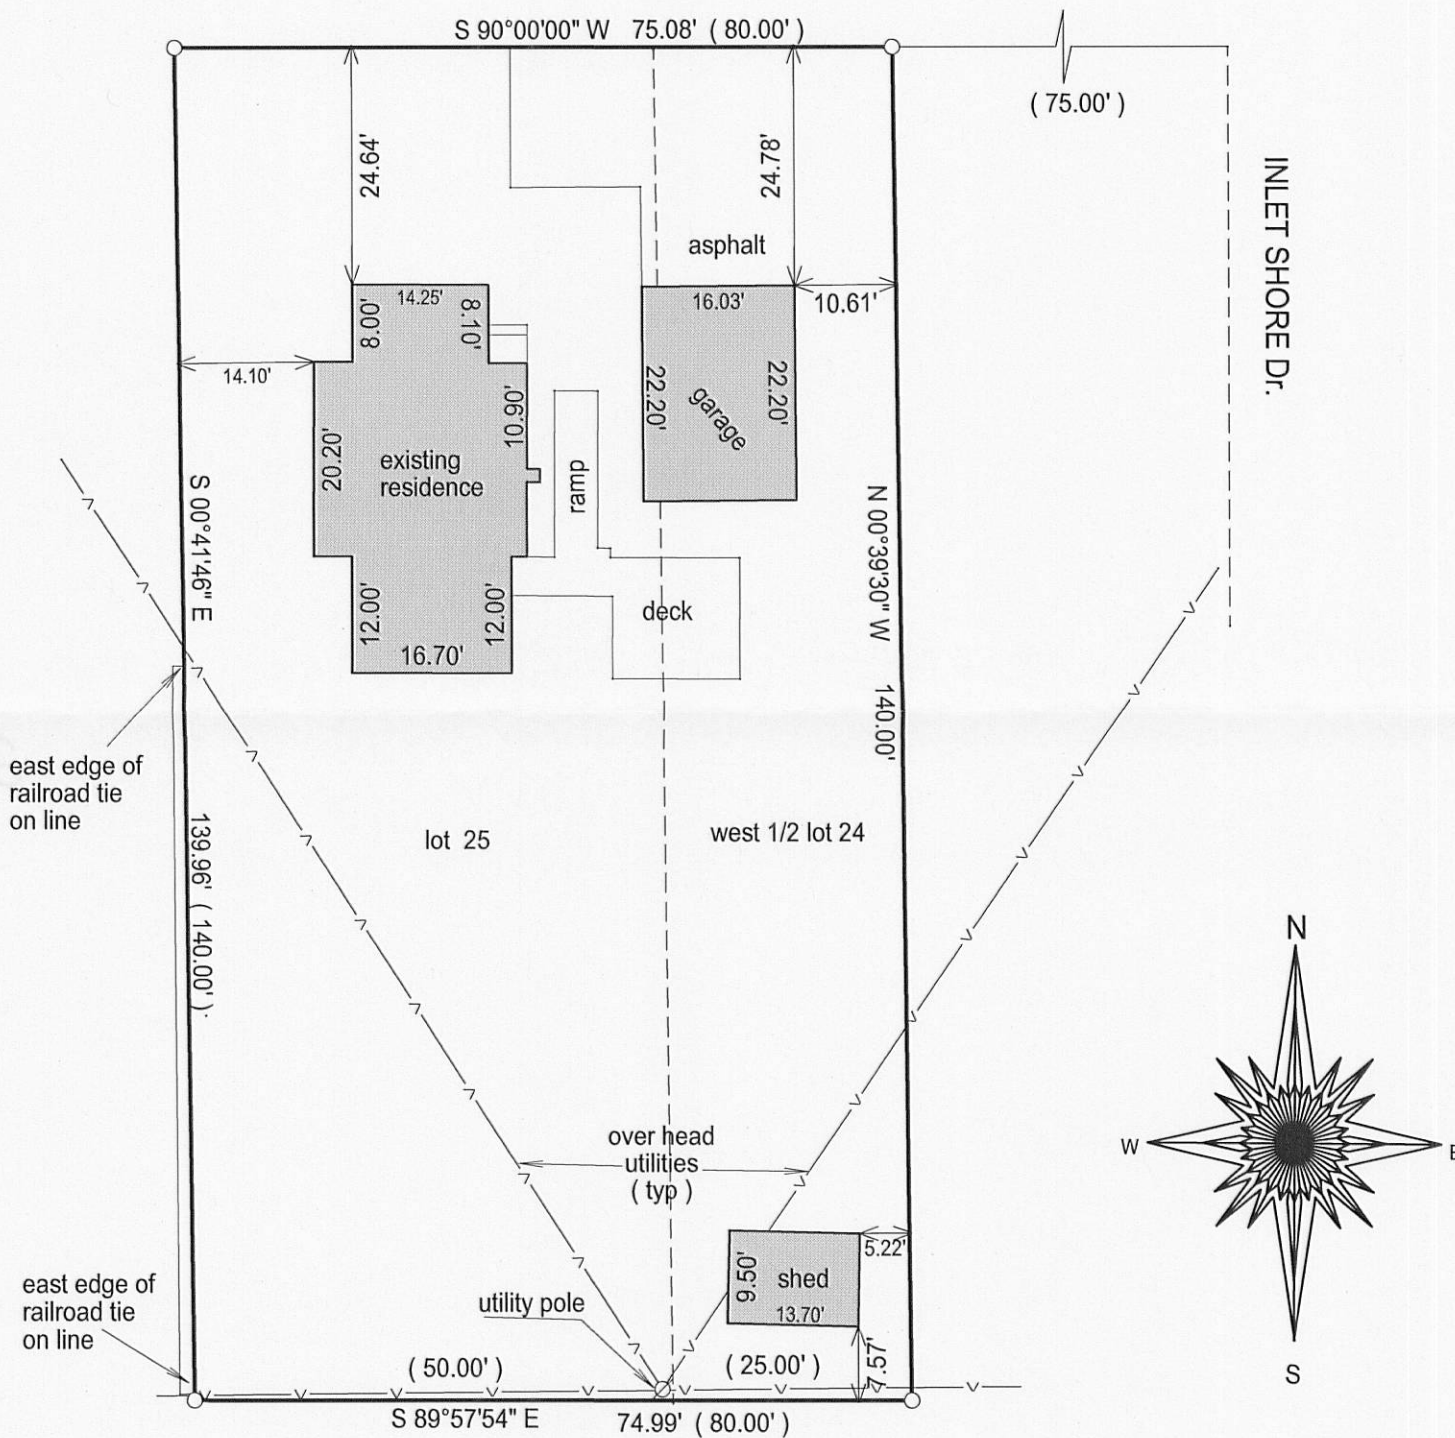

- () = recorded as
- = found iron bar
- = found iron pipe
- = set iron pipe
- = set iron bar

SCALE 1" = 20'

JOB # 10-32


TAX ID #

FIN3 00070

BASIS OF BEARING OF THIS PLAT: THE SOUTH LINE
OF BREEZY ST. WAS ASSUMED TO BEAR EAST - WEST.

"I hereby certify that I have surveyed the above described property and that
the above map is a true representation of its exterior boundaries and shows
the size and location of all visible structures, apparent easements and
encroachments if any."
This survey is made for the present owners of the property, and those who
purchase, mortgage, or guarantee the title thereto, within one year from
the date hereof.

DATED THIS 25TH DAY OF MARCH, 2009.

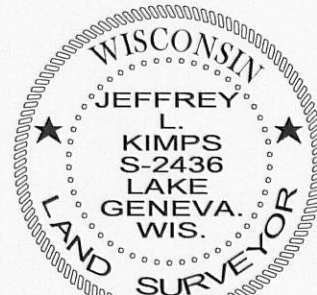

JEFFREY L. KIMPS S - 2436
Wisconsin Registered Land Surveyor
(original if signed in red)