


FARRIS, HANSEN & ASSOC. INC.

7 RIDGWAY COURT- P.O. BOX 437
ELKHORN, WISCONSIN 53121
PHONE (262) 723-2098
FAX (262) 723-5886

ORDERED BY: MIKE FIORINO FOR
SUSAN ROMBERG
5 BITTERSWEET COURT
WOOD RIDGE, IL. 60517

PLAT OF SURVEY
LOT 36 OF KRUMHAAR'S ADDITION TO RAVENSWOOD
LOCATED IN THE SE 1/4 SECTION 31
TOWN 2 NORTH, RANGE 16 EAST, WALWORTH COUNTY, WI.

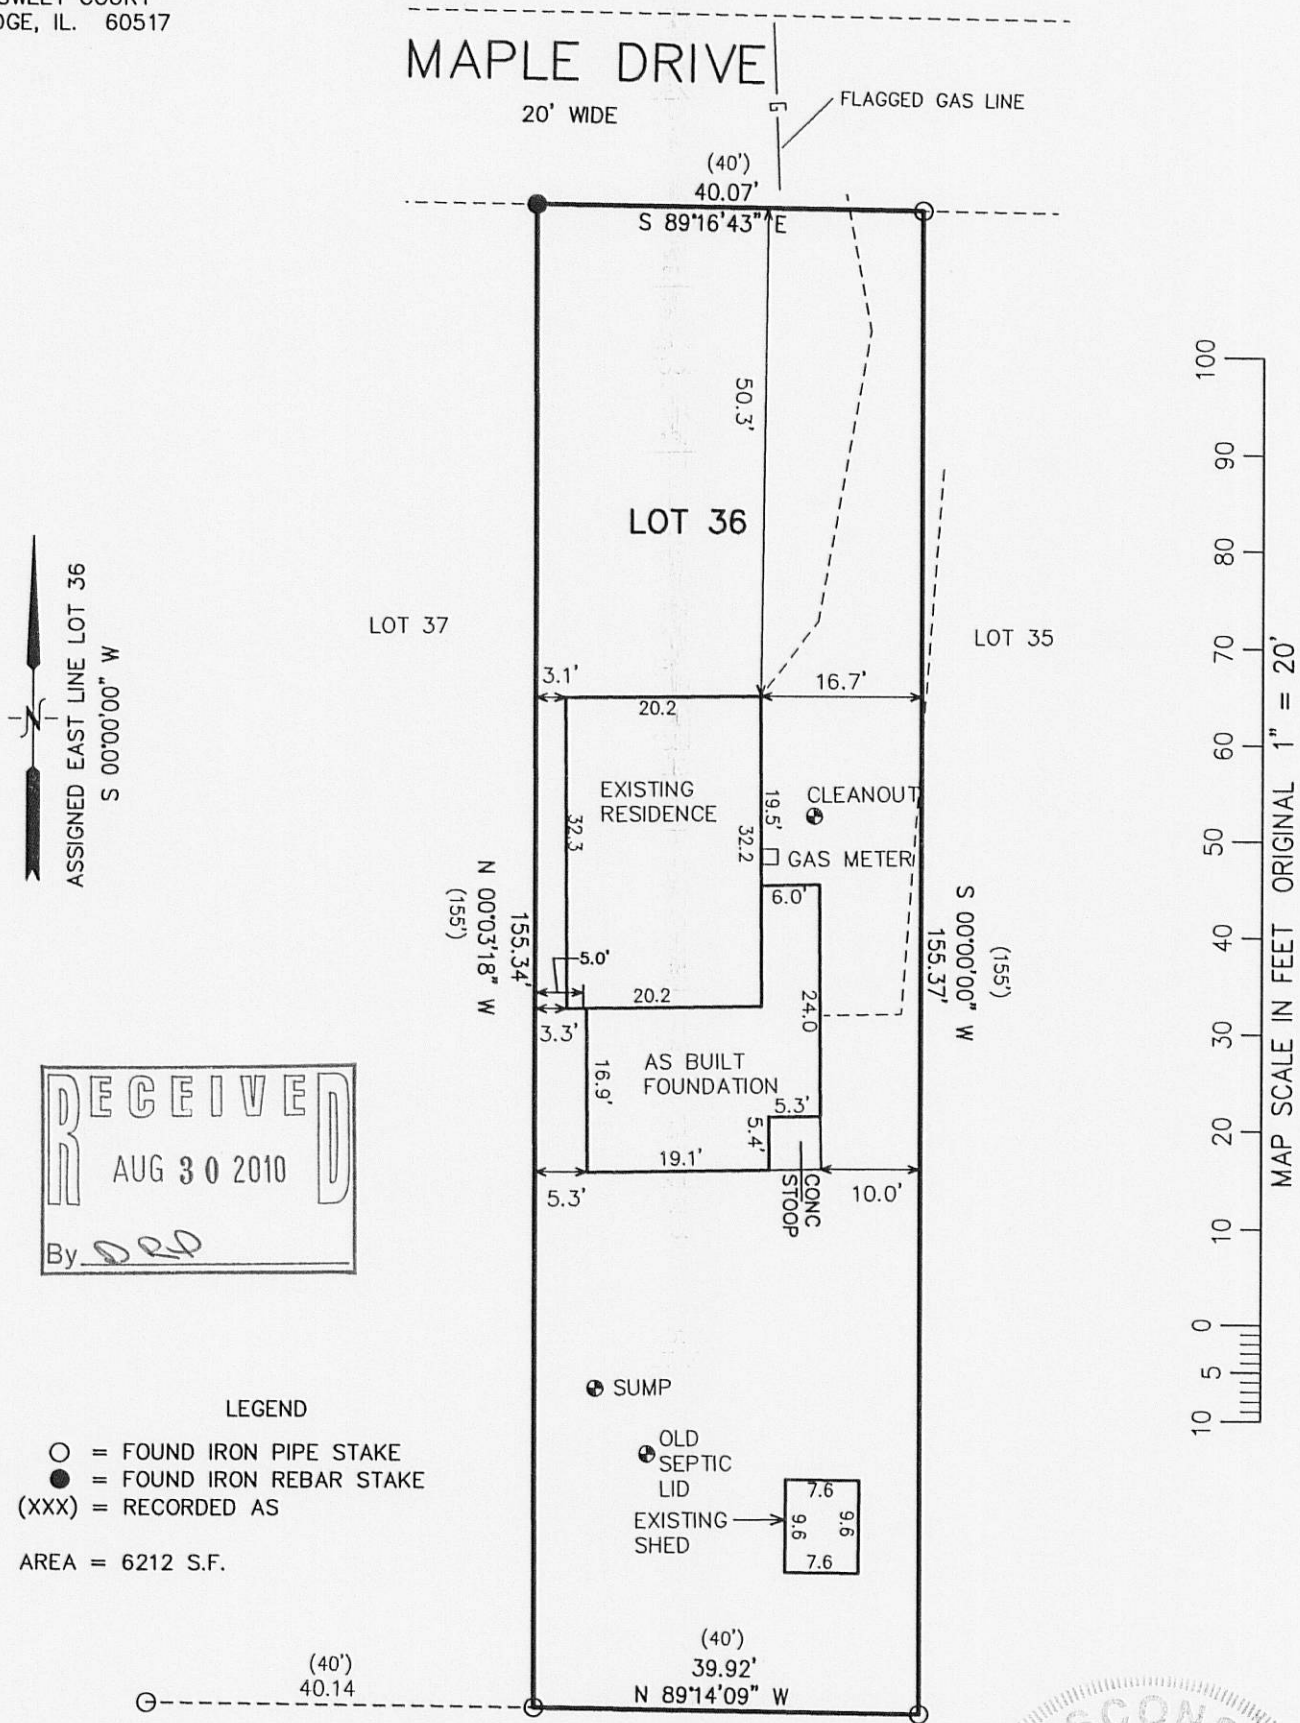

RECEIVED
AUG 30 2010
By *[Signature]*

LEGEND
○ = FOUND IRON PIPE STAKE
● = FOUND IRON REBAR STAKE
(XXX) = RECORDED AS
AREA = 6212 S.F.

NOTE: COPIES OF THIS MAP TO WHICH THE FOLLOWING CERTIFICATE WILL APPLY SHOW SURVEYOR'S ORIGINAL SEAL AND SIGNATURE IN RED INK. COPIES BY ANY OTHER MEANS MAY HAVE ALTERATIONS WHICH DO NOT REPRESENT THE SURVEYOR'S WORK PRODUCT.


I HEREBY CERTIFY THAT THE ABOVE DESCRIBED PROPERTY HAS BEEN SURVEYED UNDER MY DIRECTION AND THAT THE ABOVE MAP IS A TRUE REPRESENTATION THEREOF AND SHOWS THE SIZE AND LOCATION OF THE PROPERTY AND ITS EXTERIOR BOUNDARIES. THIS SURVEY IS MADE FOR THE USE OF THE PRESENT OWNERS OF THE PROPERTY, AND ALSO THOSE WHO PURCHASE, MORTGAGE, OR GUARANTEE THE TITLE THERETO WITHIN ONE YEAR FROM THE DATE HEREOF.

REVISED 05-07-2010

DATED: APRIL 28, 2010

REVISED 08-25-2010
TO SHOW AS BUILT FOUNDATION

[Signature]
PETER S. GORDON R.L.S. 2101

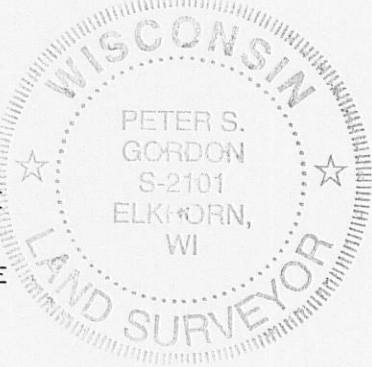

PROJECT NO. 8124
DATED: 04-28-2010
SHEET 1 OF 1 SHEETS

AUG 25 2010 FRA-33

216-4768