



GEORGE T. DUNHAM
SURVEYING & SUBDIVIDING
DELAVAN, WISCONSIN

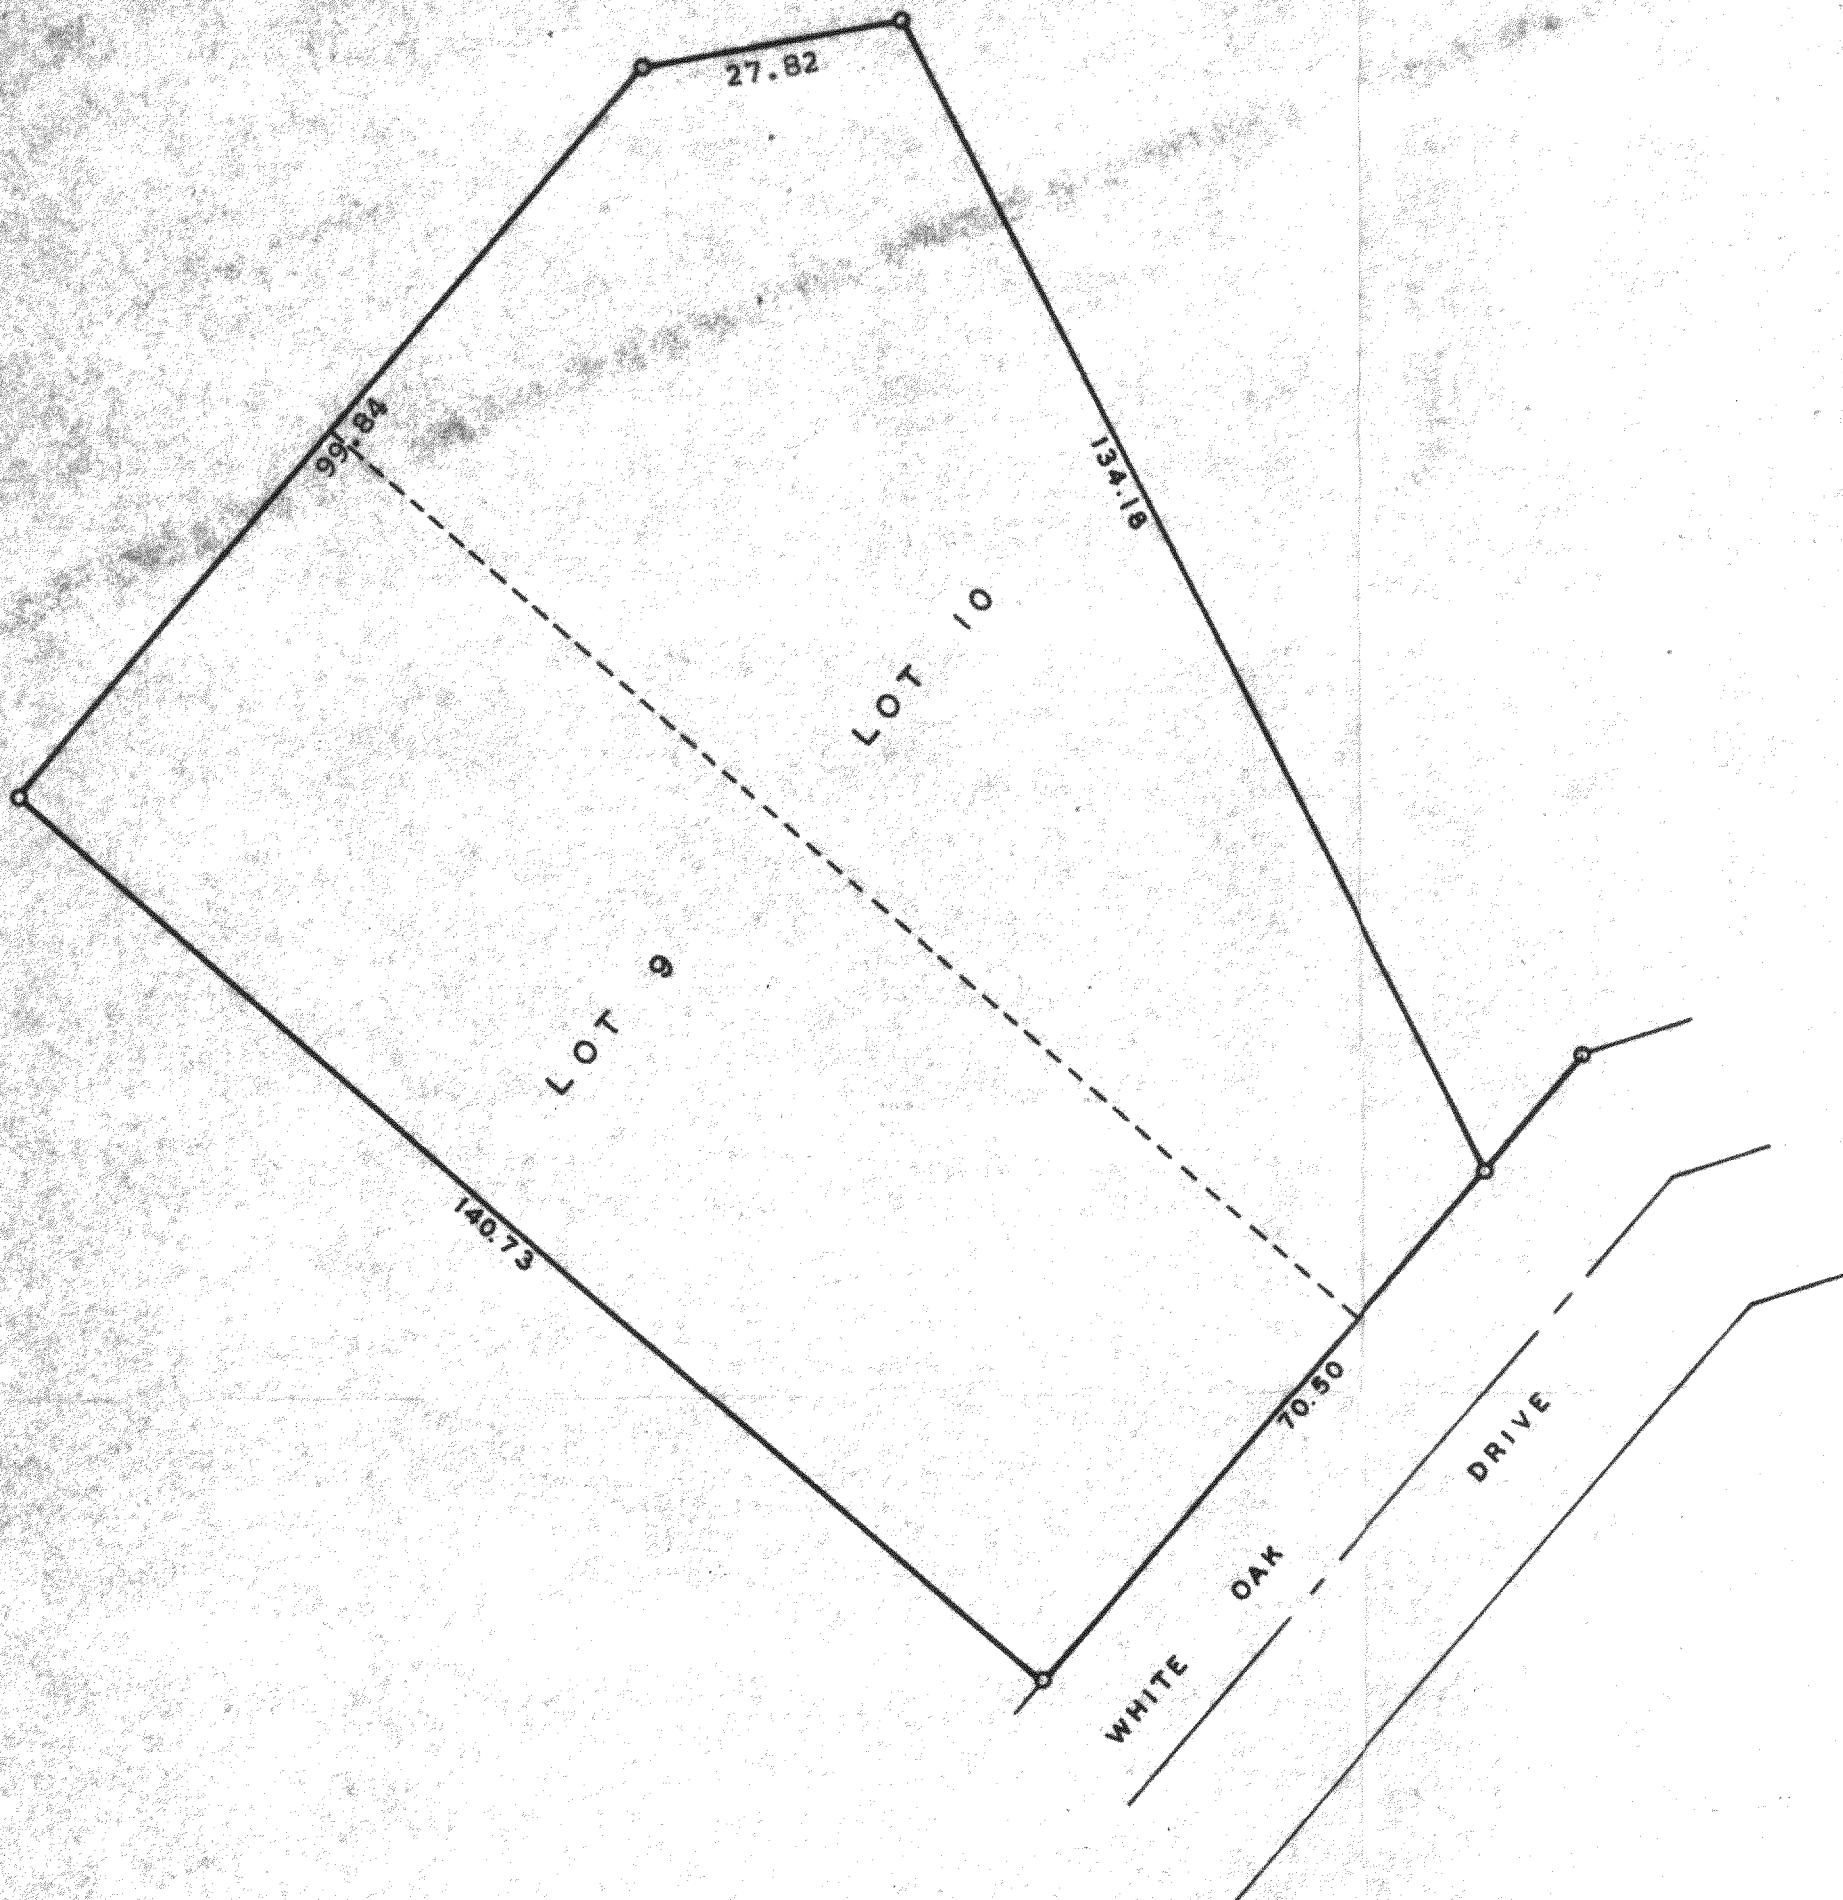

Scale - 1" = 20'
o = Iron pipe

Plat of survey of Lots 9 and 10, Block 7 of Inlet Oaks
Subdivision No. 4 located in Section 15, T 2 N, R 16 E,
Walworth County, Wisconsin.
July 24, 1974

George T. Dunham
George T. Dunham, Surveyor

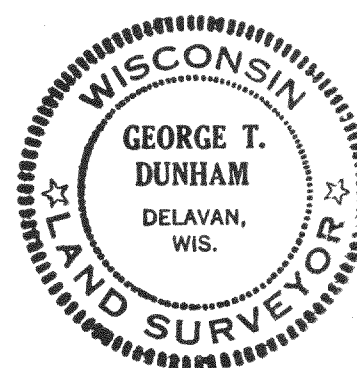

FIN 4-56

216-477