

PLAT

OF
OF

SURVEY



Walworth Co.

LOT 16, BLOCK 1, INLET OAKS SUBDIVISION NO. 3, IN SECTIONS 15 AND 22, T. 2 N., R. 16 E.
OF THE 4TH P.M., TOWNSHIP OF DELAVAN, COUNTY OF WALWORTH, STATE OF WISCONSIN.

FOR: PHILIP AND MARGARET PETERSON

SCALE 1" = 20'

o = IRON PIPE STATE FOUND.

o = IRON PIPE STAKE SET.

STREET ADDRESS: 313 FIRST St.



RACINE COUNTY SURVEYOR

FILE NO. _____

RECEIVED JUL 5 1985

BY Dennis W. Stephen
DEPUTY FOR RECORDS

± FIRST ST. 40' WIDE

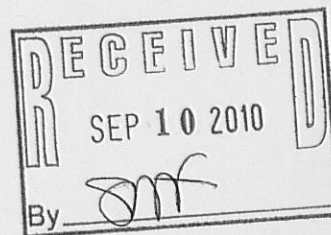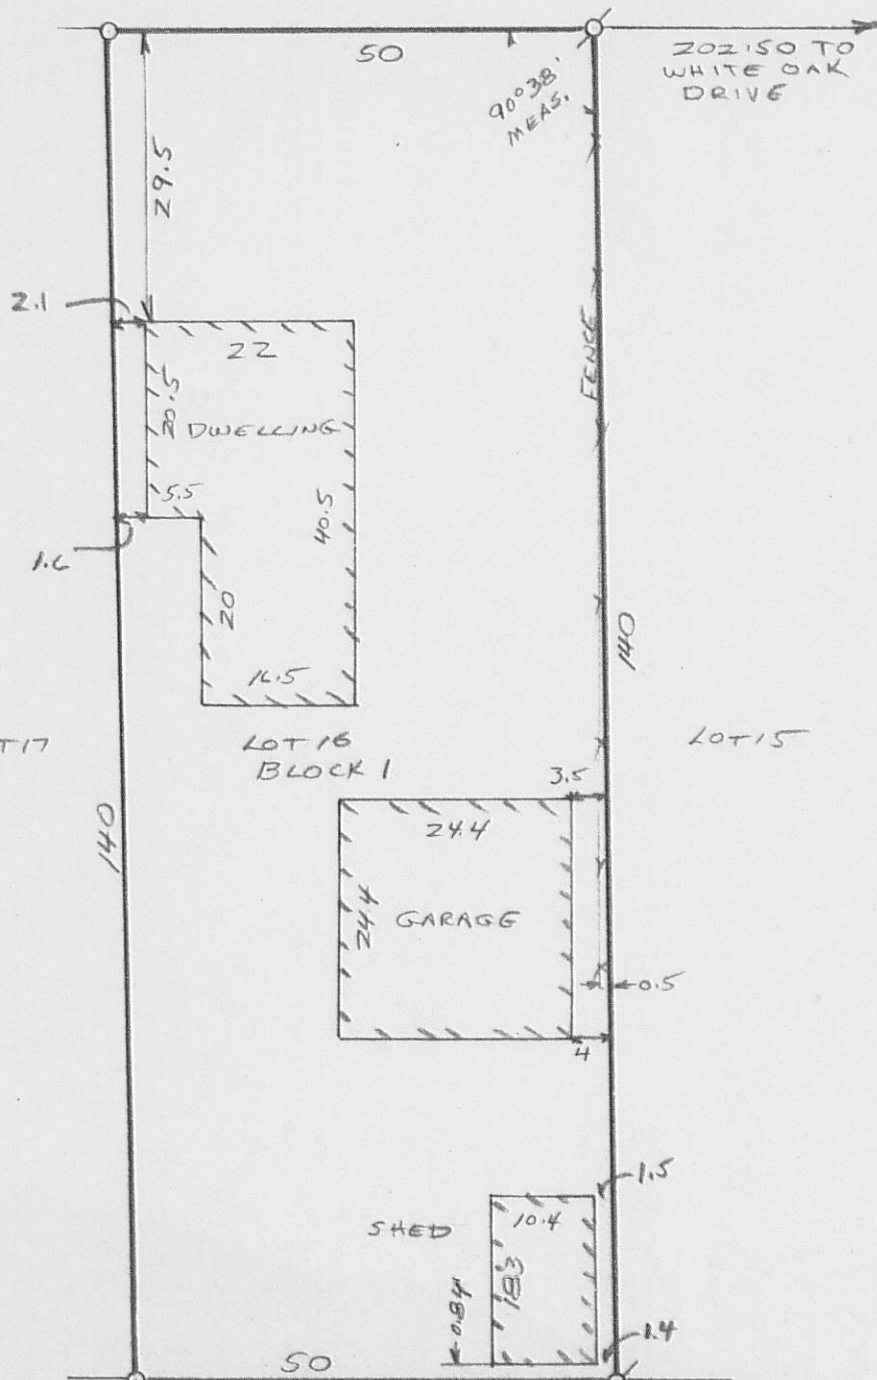

I have surveyed the above-described property, and the map hereon is a true representation thereof and shows the size and location of the property, its exterior boundaries, the location and dimensions of all visible structures thereon, fences, apparent easements and roadways and visible encroachments, if any.

This survey is made for the exclusive use of the present owners of the property, and also those who purchase, mortgage, or guarantee the title thereto, within one year from date hereof.

Dated at Burlington, this 10th day of JUNE 1985
John F. Degen
John F. Degen, Land Surveyor S 242