

ABELL
SURVEYING & MAPPING
1140 SEQUOIA STREET • DELAVAN, WISCONSIN 53115
262-728-6737

COUNTRY VIEW DRIVE

FOXTAIL LANE

LOT 11

LOT 12

HOUSE


PORCH

SHED

LOT 10

PLAT OF SURVEY OF

LOT 11 OF COUNTRY VIEW SUBDIVISION,
LOCATED IN THE SOUTHWEST 1/4 OF
SECTION 23, T2N.R16E, WALWORTH
COUNTY, WISCONSIN.

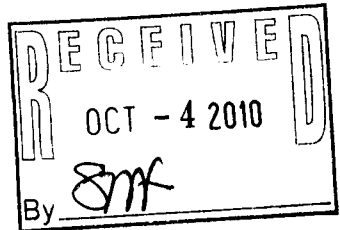

BEARINGS ARE REFERENCED TO THE
RECORDED SUBDIVISION PLAT.



SCALE 1"=20'

LEGEND

- - IRON PIPE FOUND
- - 2" DIA. IRON PIPE FOUND
- * - WOOD FENCE
- () - RECORDED AS

ORDERED BY: DON HARTMANN
3485 FOXTAIL LANE
DELAVAN, WI 53115

I, DAVID F. ABELL, DO HEREBY CERTIFY THAT I HAVE SURVEYED THE PROPERTY HEREON
DESCRIBED ACCORDING TO THE OFFICIAL RECORDS AND THAT THE PLAT HEREON IS A
CORRECT REPRESENTATION OF THE PROPERTY LINES TO THE BEST OF MY KNOWLEDGE AND
BELIEF.

David F. Abell

DAVID F. ABELL
WISCONSIN REGISTERED LAND SURVEYOR, S-1596

September 9, 2010

DATE: JOB NUMBER - 960708
NOTE: THIS IS NOT A CERTIFIED COPY UNLESS SEALED.

FCV-11

216-4795