


DUNHAM SURVEYING, S.C.
SURVEYING & SUBDIVIDING
DELAVER, WISCONSIN 53115

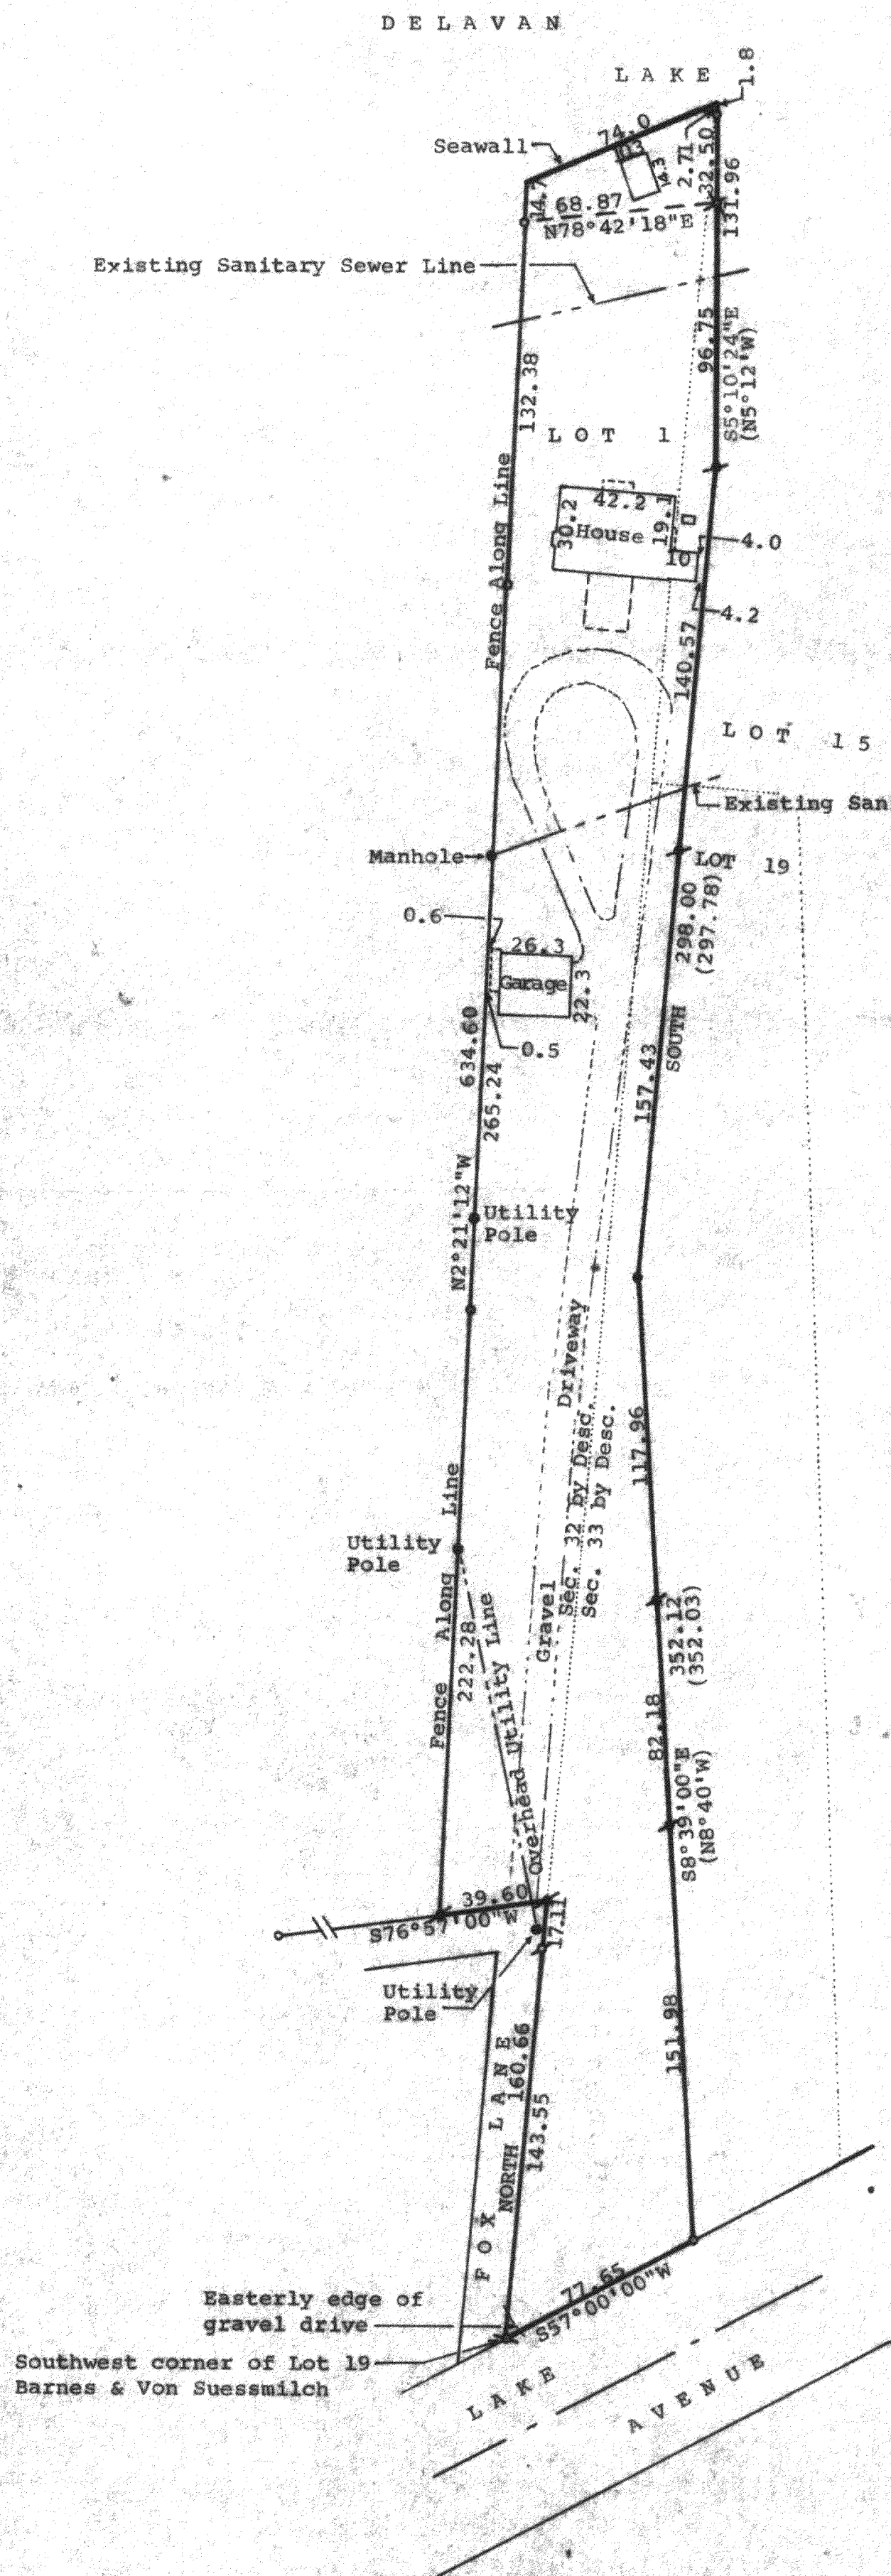

Scale - 1" = 50'

• = 1/2" Dia. Iron Pipe Found
x = 3/4" Dia. Iron Pipe Found
x = 1" Dia. Iron Pipe Found
o = 1 1/4" Dia. Iron Pipe Found
x = 3/4" Dia. Iron Pipe Set
(XXX) = Recorded Distance or Bearing

Bearings referenced to the Northerly line of Lake Avenue. Bearing of S57°00'W taken from records.

Survey ordered by: The Rauland Agency, Inc.
607 E. Walworth Ave.
Delaver, Wisconsin 53115

STATE OF WISCONSIN
COUNTY OF WALWORTH


I, George T. Dunham, Surveyor, certify that I have surveyed the property described as follows.

Lot 1 of Austin and Wallis Subdivision located in the East 1/2 of Section 32, T 2 N, R 16 E, Walworth County, Wisconsin and the following described part of Lots 15 and 19 of Barnes and Von Suessmilch Subdivision located in the West 1/2 of Section 33, T 2 N, R 16 E, Walworth County, Wisconsin, Beginning at the Southwest corner of said Lot 19; thence N57°00'E along the southeasterly line of said Lot 19, 77.65 feet; thence N8°39'00"W 352.12 feet to an iron pipe; thence North 298.00 feet to an iron pipe; thence N5°10'24"W 131.96 feet to the west line of said Barnes and Von Suessmilch Subdivision; thence South along said west line of said subdivision to the place of beginning, subject to easements of record.

and that the above map is a true representation thereof and shows the size and location of the property, its exterior boundaries, the location of all visible structures and dimensions of all principal buildings thereon, boundary fences, apparent easements, roadways and visible encroachments, if any, and that I have surveyed the property hereon described according to the official records to the best of my knowledge and belief.

April 26, 1983

George T. Dunham
George T. Dunham, Surveyor

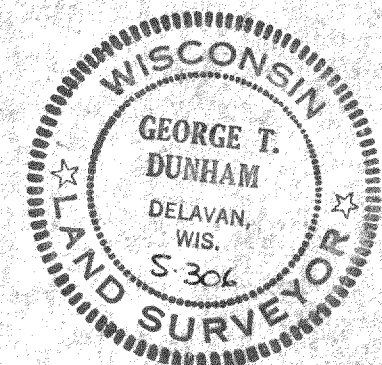

FBA-11

+ Lot of Austin & Wallis

216-481