


GEORGE T. DUNHAM
SURVEYING & SUBDIVIDING
DELAVAN, WISCONSIN

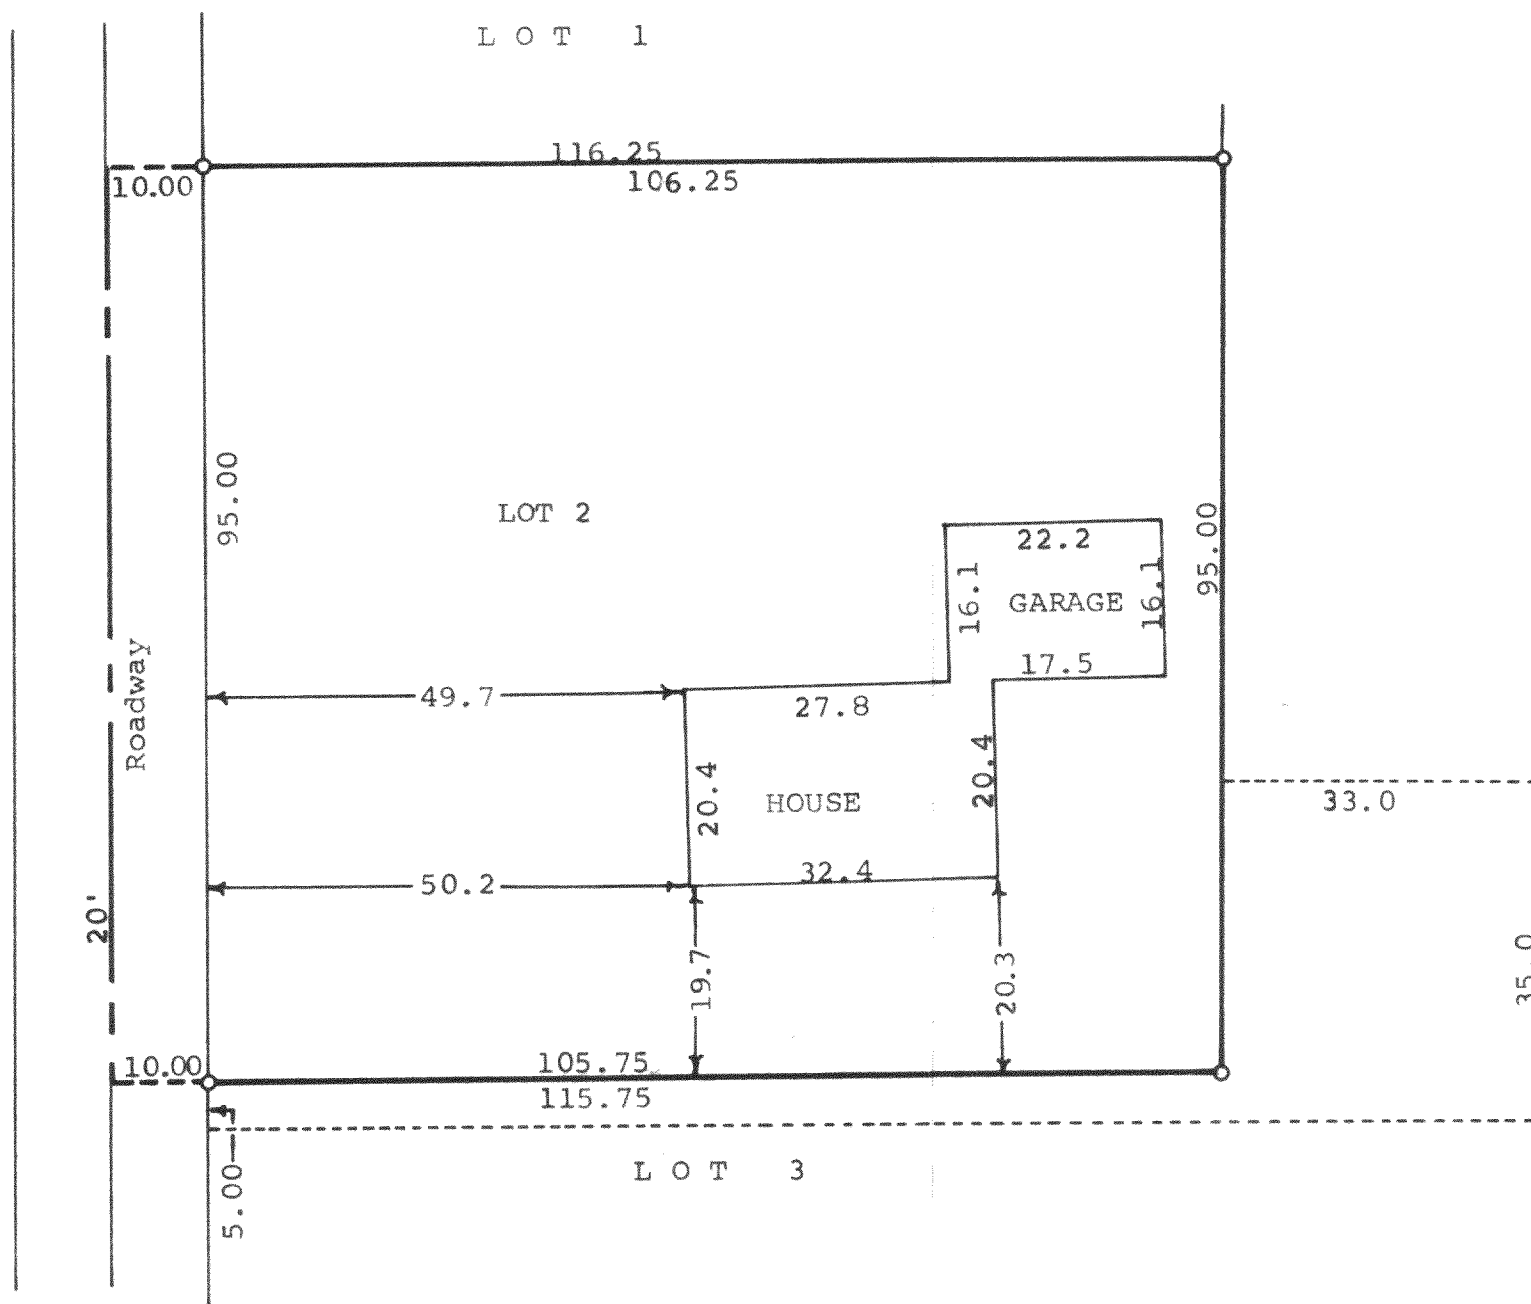

Scale - 1" = 20'
o = Iron Pipe


STATE OF WISCONSIN)
COUNTY OF WALWORTH) SS

I, George T. Dunham, Surveyor, certify that I have surveyed
the property described as follows,

The North $\frac{1}{2}$ of Lot 2 in Chicago Club Subdivision, according
to the recorded Plat thereof, Walworth County, Wisconsin.
The South $\frac{1}{2}$ of Lot 2 in said Chicago Club Subdivision, excepting
therefrom a tract 33 feet by 35 feet in the Southeast corner
thereof and further excepting therefrom the South 5 feet along
the south side of lot which is used for water main in Chicago
Club Subdivision, as shown by the plat thereof recorded in
Volume 9 of Plats at page 34 in the Town of Delavan, Walworth
County, Wisconsin.

and the above map is a true representation thereof and shows the size and
location of the property, its exterior boundaries, the location and dimen-
sions of all structures thereon, fences, apparent easements and roadway and
there are no visible encroachments. I do not certify to the location of
the water main as stated in the description above.
August 29, 1974

George T. Dunham
George T. Dunham, Surveyor

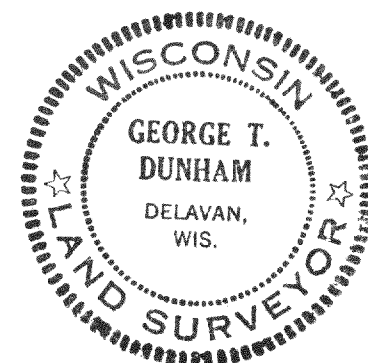

FCH-2

216-487