



PLAT OF SURVEY
LOT 1 OF CERTIFIED SURVEY MAP NO. 304


RECORDED IN VOL. 4, ON PAGE 71 OF WALWORTH COUNTY CERTIFIED SURVEYS
LOCATED IN THE SE 1/4 SECTION 21
TOWN 2 NORTH, RANGE 16 EAST
WALWORTH COUNTY, WISCONSIN

Lot 1 of Certified Survey Map No. 304, recorded in the Office of the Register of Deeds for Walworth County, Wisconsin, on November 2, 1973, in Volume 2, Page 71, as Document No. 671871, being a part of Lots 1, 2 and 3 in Mable Wood, a subdivision of the Southeast 1/4 of Section 21, Township 2 North, Range 16 East. Said land being in the Town of Delavan, County of Walworth, and State of Wisconsin.


Property Address: 1822 N Shore Drive, Delavan, WI 53115

Tax Key Number: FA 30400001

LINE	BEARING	DISTANCE
L1	N 00°46'21" W	32.33
L2	N 01°11'02" W	18.60 (18.34)
L3	N 36°05'02" E	47.00 (47.34)
L4	N 77°31'57" E	62.11 (62.09)
L5	S 01°23'49" E	14.90 (15.00)
L6	N 88°35'18" E	28.48 (30.00)
L10	N 00°46'25" W	17.57 (18)
L11	N 88°31'00" E	43.49 (43.50)
L12	N 88°27'45" E	15.07 (15.00)

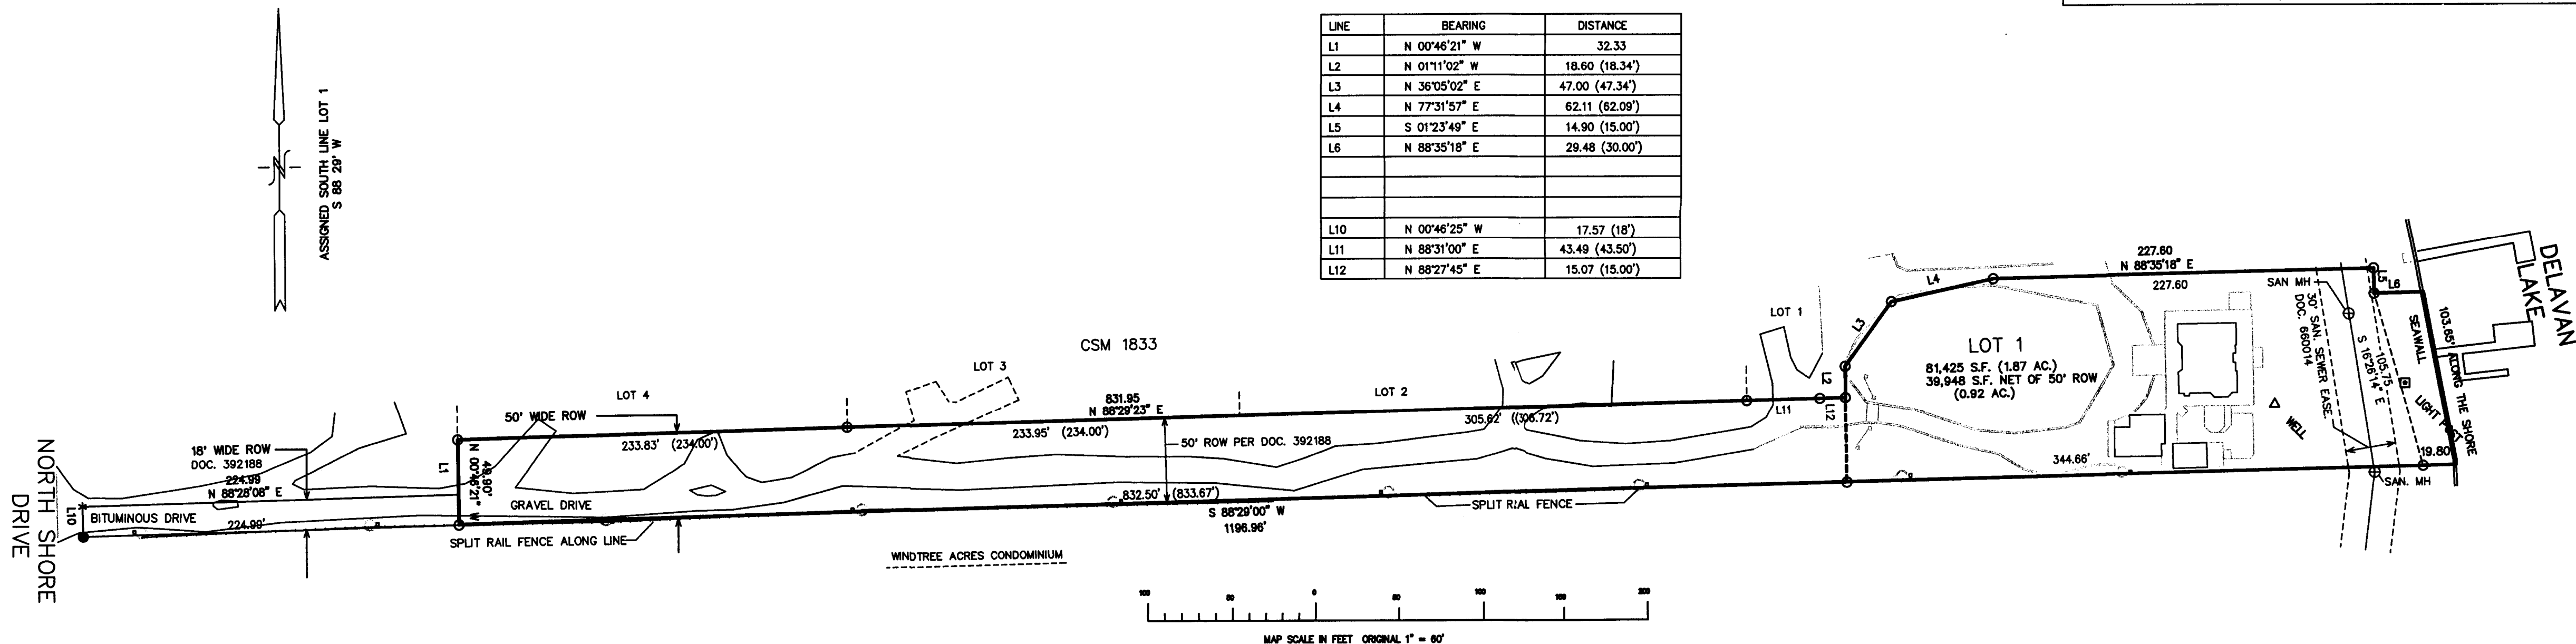

1" = 20' DETAIL

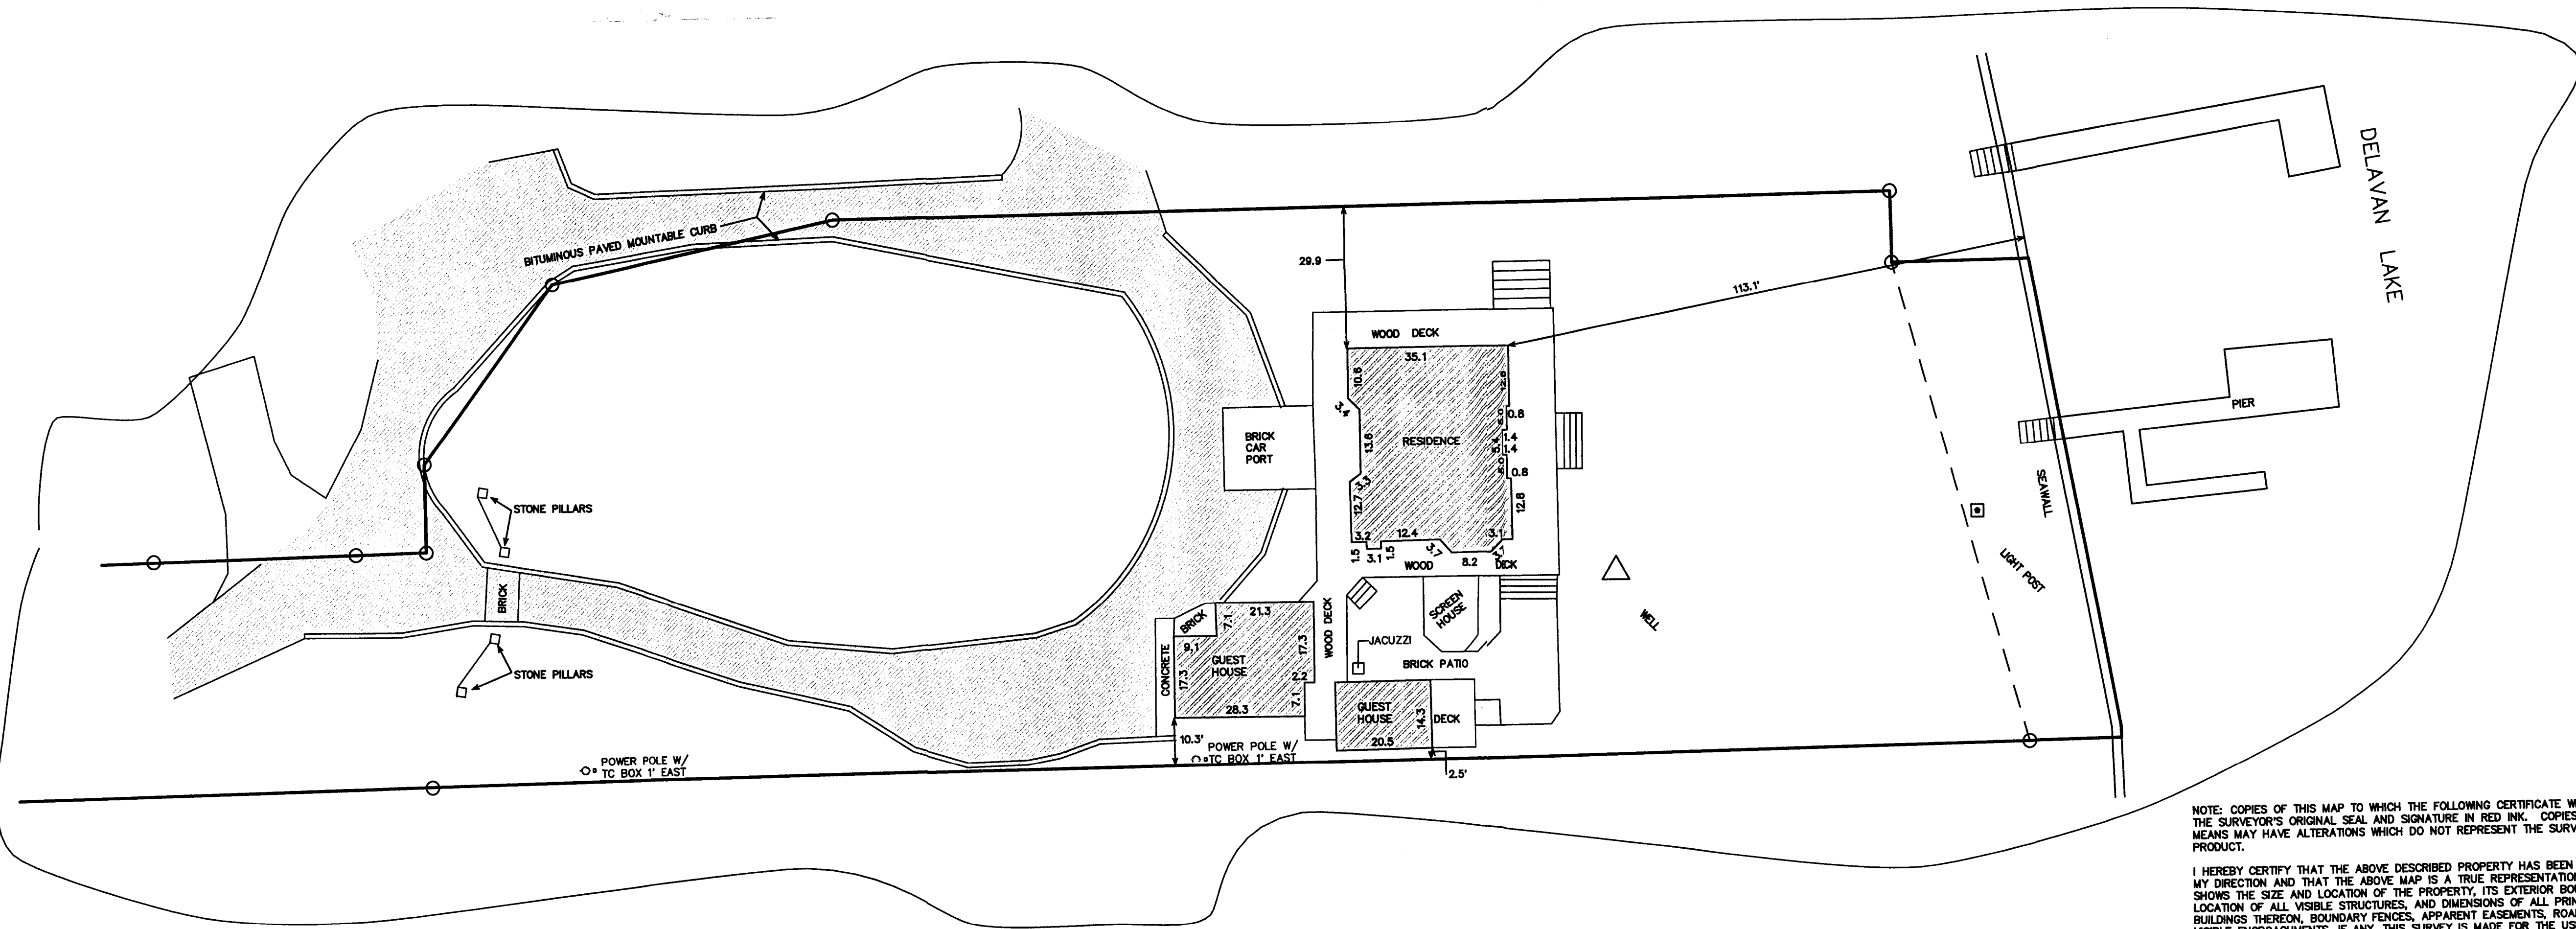


NOTE: COPIES OF THIS MAP TO WHICH THE FOLLOWING CERTIFICATE WILL APPLY SHOW THE SURVEYOR'S ORIGINAL SEAL AND SIGNATURE IN RED INK. COPIES BY ANY OTHER MEANS MAY HAVE ALTERATIONS WHICH DO NOT REPRESENT THE SURVEYOR'S WORK PRODUCT.

I HEREBY CERTIFY THAT THE ABOVE DESCRIBED PROPERTY HAS BEEN SURVEYED UNDER MY DIRECTION AND THAT THE ABOVE MAP IS A TRUE REPRESENTATION THEREOF AND SHOWS THE SIZE AND LOCATION OF THE PROPERTY, ITS EXTERIOR BOUNDARIES, THE LOCATION OF ALL VISIBLE STRUCTURES, AND DIMENSIONS OF ALL PRINCIPLE BUILDINGS THEREON, BOUNDARY FENCES, APPARENT EASEMENTS, ROADWAYS, AND VISIBLE ENCROACHMENTS, IF ANY. THIS SURVEY IS MADE FOR THE USE OF THE PRESENT OWNERS OF THE PROPERTY, AND ALSO THOSE WHO PURCHASE, MORTGAGE, OR GUARANTEE THE TITLE THERETO WITHIN ONE YEAR FROM THE DATE HEREOF.

DATED: SEPTEMBER 29, 2011

PETER S. GORDON

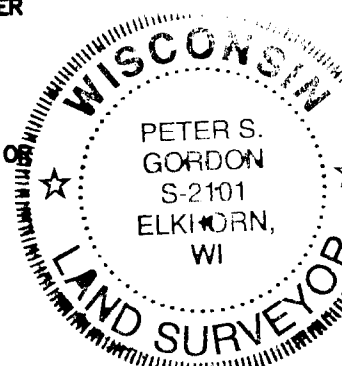

WORK ORDERED BY: WANDA PERRY
C/O RAULAND AGENCY
118 KENOSHA STREET
WALWORTH, WISCONSIN

FARRIS, HANSEN & ASSOCIATES, INC.
Engineering, Architecture, Surveying
7 Ridgway Court P.O. Box 437
ELKHORN, WISCONSIN 53121
Office: (414) 723-2088
Fax: (414) 723-5886

REVISIONS

PROJECT NO.
5087

DATE
08-12-98

SHEET NO.
1 OF 1