
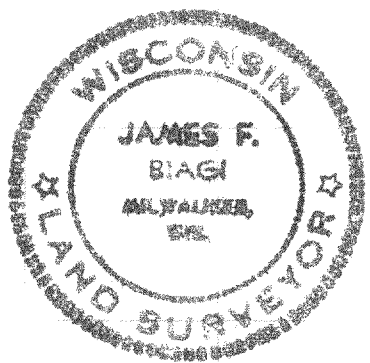


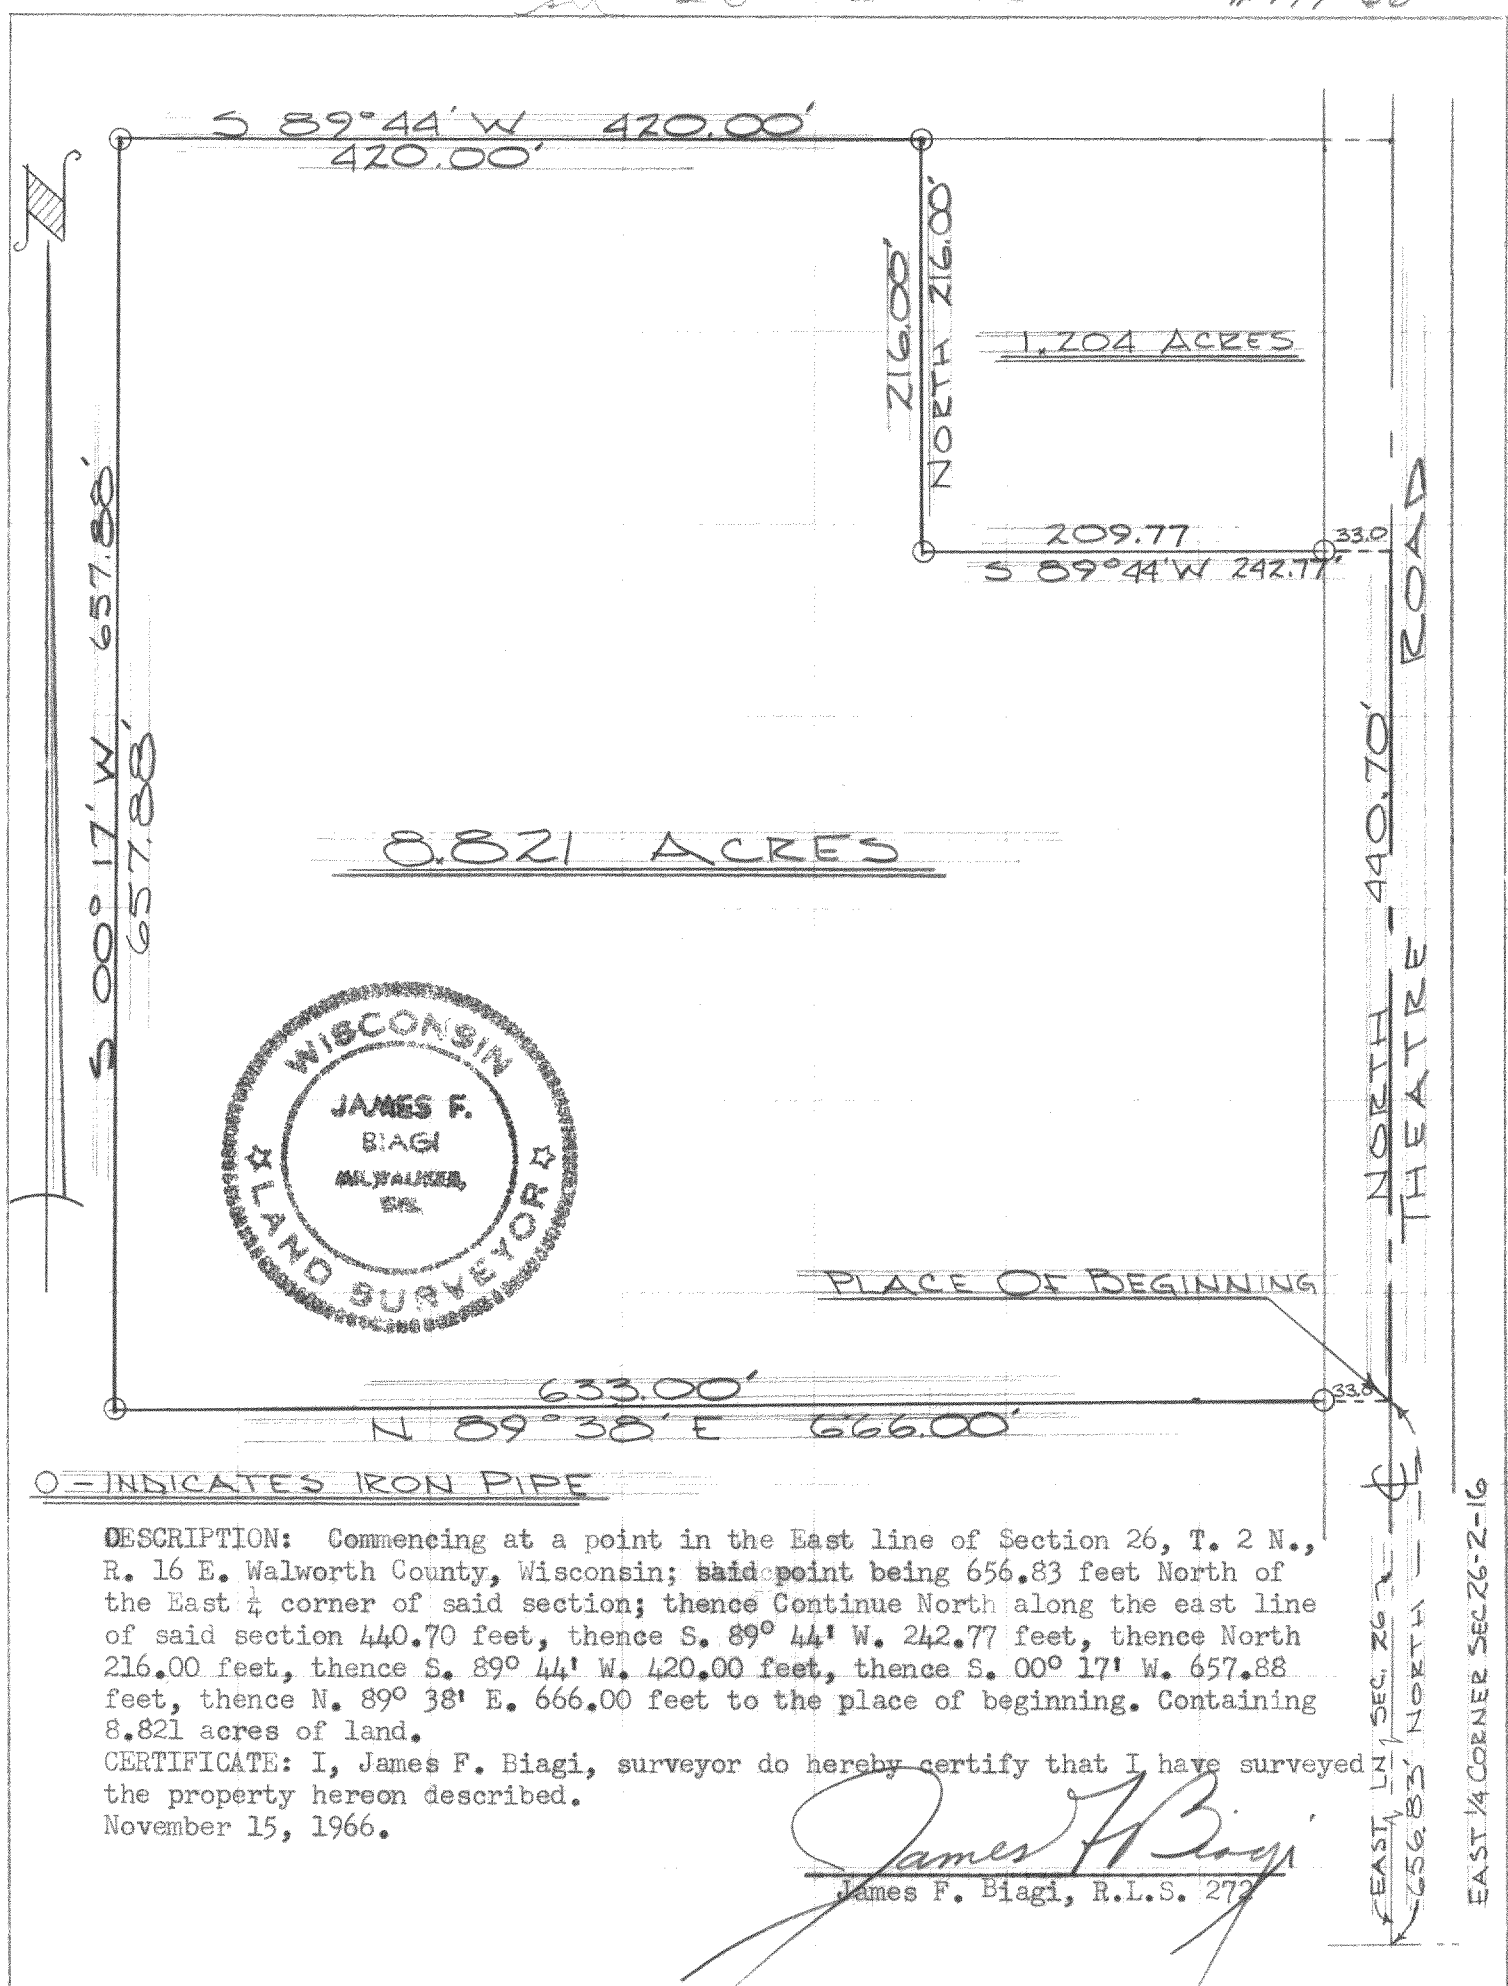

O - INDICATES IRON PIPE

DESCRIPTION: Commencing at a point in the East line of Section 26, T. 2 N., R. 16 E. Walworth County, Wisconsin; said point being 656.83 feet North of the East $\frac{1}{4}$ corner of said section; thence Continue North along the east line of said section 440.70 feet, thence S. $89^{\circ} 44'$ W. 242.77 feet, thence North 216.00 feet, thence S. $89^{\circ} 44'$ W. 420.00 feet, thence S. $00^{\circ} 17'$ W. 657.88 feet, thence N. $89^{\circ} 38'$ E. 666.00 feet to the place of beginning. Containing 8.821 acres of land.

CERTIFICATE: I, James F. Biagi, surveyor do hereby certify that I have surveyed the property hereon described.
November 15, 1966.

James F. Biagi
James F. Biagi, R.L.S. 272

EAST $\frac{1}{4}$ CORNER SEC 26-2-16
N 656.83' NORTH
EAST LN, SEC. 26-2-16
440.70' NORTH
THEATRE ROAD