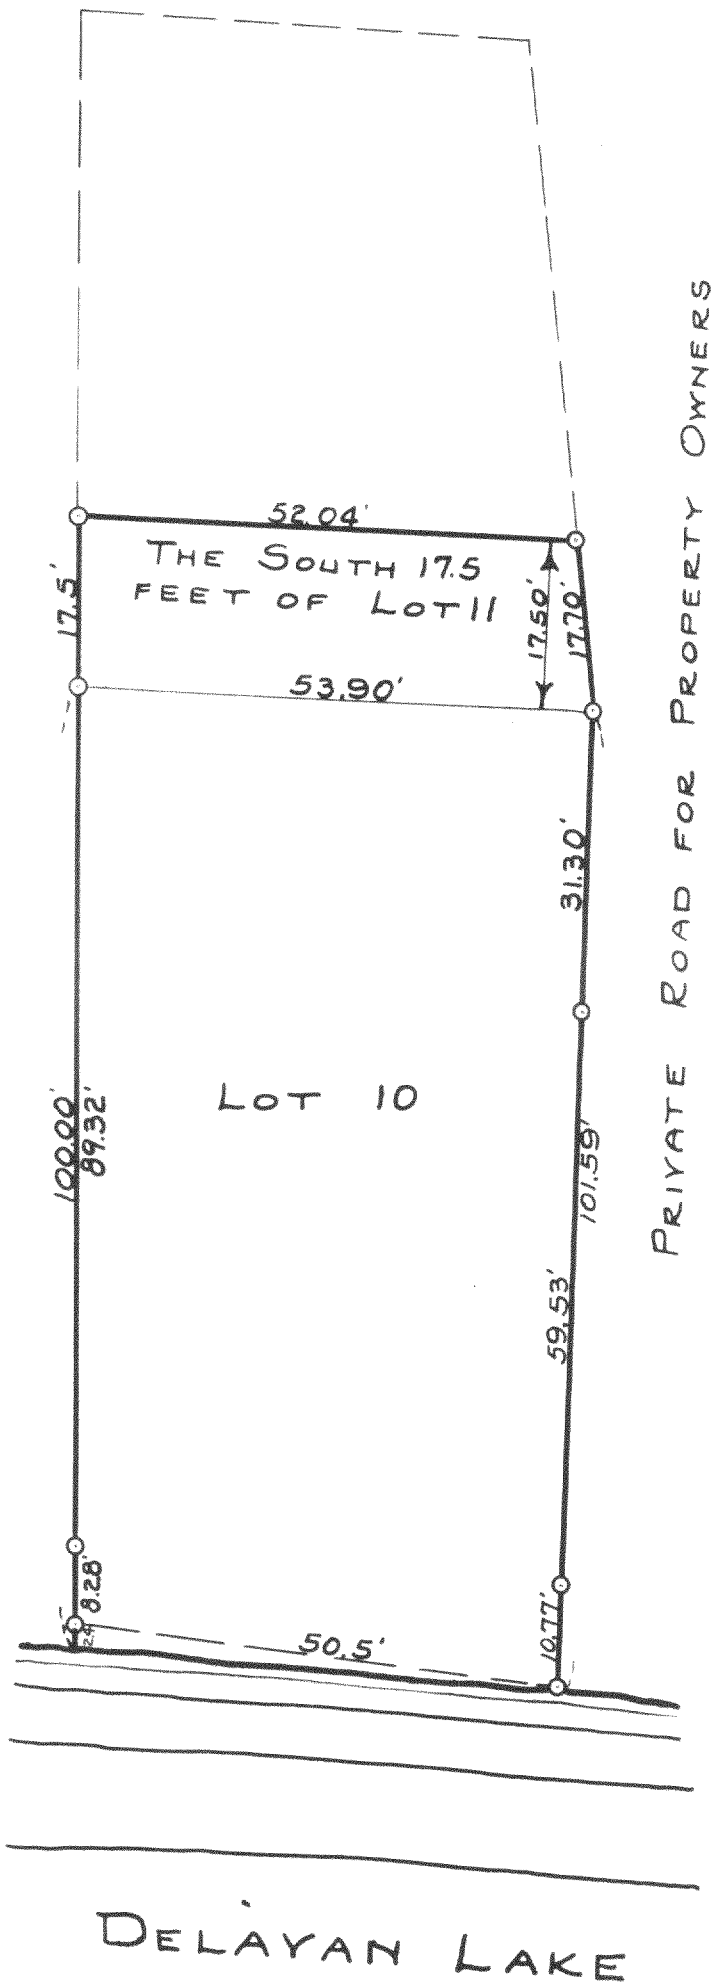


SCALE 1"=20'
O-IRON PIPE

PLAT OF SURVEY OF LOT 10 AND THE
SOUTH 17.5 FEET OF LOT 11 OF THE ADDITION
TO WILLOW POINT PARK, A SUBDIVISION
LOCATED IN SECTION 29, T2N R16E OF
WALWORTH COUNTY WISCONSIN.

AUG. 1944

Lloyd L. Jensen
COUNTY SURVEYOR