

GRID NORTH
WISCONSIN STATE PLANE COORDINATE
SYSTEM - SOUTH ZONE (NAD-27)
N. LINE OF THE SE 1/4 OF SECTION 29-2-16
BEARS S 89°20'10" W

PLAT OF SURVEY

LOT 1 OF CERTIFIED SURVEY MAP NO. 4371, RECORDED AS DOCUMENT NO. 821092
LOCATED IN PART OF GOVERNMENT LOTS 1 AND 2, SECTION 29, TOWN 2 NORTH,
RANGE 16 EAST, WALWORTH COUNTY, WISCONSIN




WORK ORDERED BY -
JORDNT BUILDERS
168 ELKHORN ROAD
WILLIAMS BAY, WISCONSIN 53191

FARRIS, HANSEN & ASSOCIATES, INC.
ENGINEERING - ARCHITECTURE - SURVEYING
7 RIDGWAY COURT P.O. BOX 437
ELKHORN, WISCONSIN 53121
OFFICE: (262) 723-2098 FAX: (262) 723-5886

REVISIONS

PROJECT NO.
8401
DATE:
8/24/2011
SHEET NO.
1 OF 1

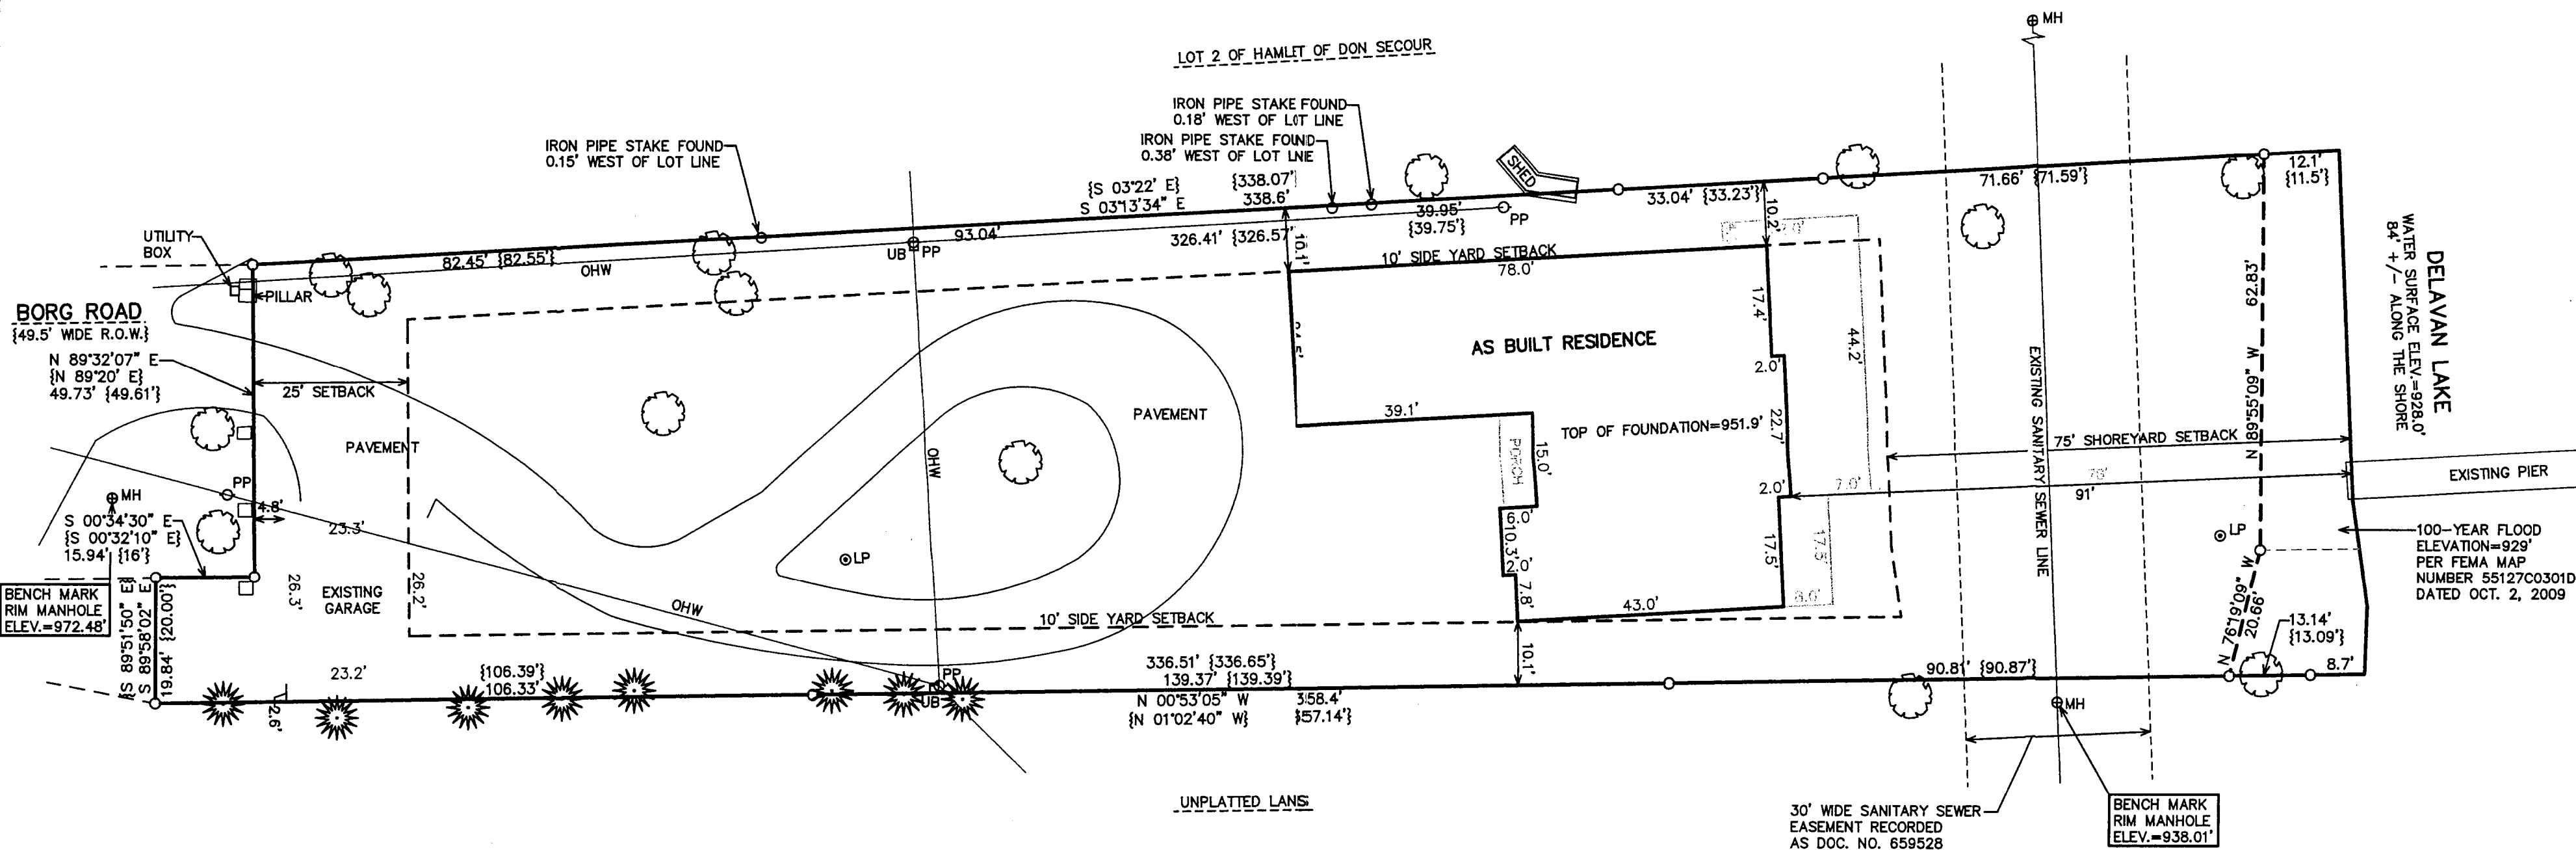

LEGEND
O = 1" DIA. IRON PIPE STAKE FOUND
{XXX} = RECORDED AS
TOTAL LAND AREA = 26,320 SQ. FT. (0.60 ACRES)

NOTE: COPIES OF THIS MAP TO WHICH THE FOLLOWING CERTIFICATE
WILL APPLY SHOW THE SURVEYOR'S ORIGINAL SEAL AND SIGNATURE
IN RED INK. COPIES BY ANY OTHER MEANS MAY HAVE ALTERATIONS
WHICH DO NOT REPRESENT THE SURVEYOR'S WORK PRODUCT.

I HEREBY CERTIFY THAT THE ABOVE DESCRIBED PROPERTY HAS BEEN
SURVEYED UNDER MY DIRECTION AND THAT THE ABOVE MAP IS A TRUE
REPRESENTATION THEREOF AND SHOWS THE SIZE AND LOCATION OF
THE PROPERTY AND ITS EXTERIOR BOUNDARIES. THIS SURVEY IS
MADE FOR THE USE OF THE PRESENT OWNERS OF THE PROPERTY, AND
ALSO THOSE WHO PURCHASE, MORTGAGE, OR GUARANTEE THE TITLE
THERETO WITHIN ONE YEAR FROM THE DATE HEREOF.

DATED: AUGUST 24, 2011

REVISED 12-01-2011
TO SHOW SIZE & LOCATION OF
AS BUILT RESIDENCE

Peter S. Gordon
PETER S. GORDON R.L.S. 2101

10 5 0 10 20 30 40 50 60 70 80 90 100
MAP SCALE IN FEET ORIGINAL 1" = 20'

12/7/2011 X:\Projects\8401\Draw\ASBUILT

2116-4906

FA4371-1