


AS-BUILT MAPPING
UNIT 1 – CAMP DELAVAN CONDOMINIUM
A REDIVISION OF LOTS 1, 2, 3, 4, 5, 6, & 7 OF WESTWARD STAR WOODS AND LOT 1 & PART OF LOT 2
OF ARNOLDS WOODS SUBDIVISION BEING PART OF GOVERNMENT LOT 1 LOCATED IN THE NW 1/4, NE 1/4,
& SE 1/4 OF THE NE 1/4 OF FRACTIONAL SECTION 31, TOWN 2 NORTH, RANGE 16 EAST, WALWORTH COUNTY, WISCONSIN
WOODLAND CABIN WEST

ASSIGNED WEST LINE
WESTWARD STAR WOODS
N 2°18'27" W
PER RECORD PLAT

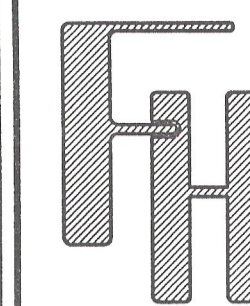


WOODLAND CABIN WEST
CAMP DELAVAN CONDOMINIUM
TOWN OF DELAVAN, WALWORTH COUNTY, WISCONSIN

WORK ORDERED BY –
ALEC & JENNIFER LITOWITZ
610 LONGWOOD AVENUE
GLENCOE, IL 60022

FARRIS, HANSEN & ASSOCIATES, INC.
ENGINEERING – ARCHITECTURE – SURVEYING
7 RIDGWAY COURT P.O. BOX 437
ELKHORN, WISCONSIN 53121
OFFICE: (262) 723-2098 FAX: (262) 723-5886


REVISIONS
4/5/2010-KB
SITE, GRADING,
DRAINAGE & EROSION
CONTROL PLAN
11/16/2010-KB
ADJUST PROPOSED
BUILDING LOCATION
3/3/2011-KB
UPDATE FOR PERMIT
10/14/2011-KB
UPDATE FOR CONSTR.
10/19/2011-KB
REVISE BLDG. LOCATION

PROJECT NO.
5765.CONDO
DATE
2/22/2010
SHEET NO.
1 OF 1

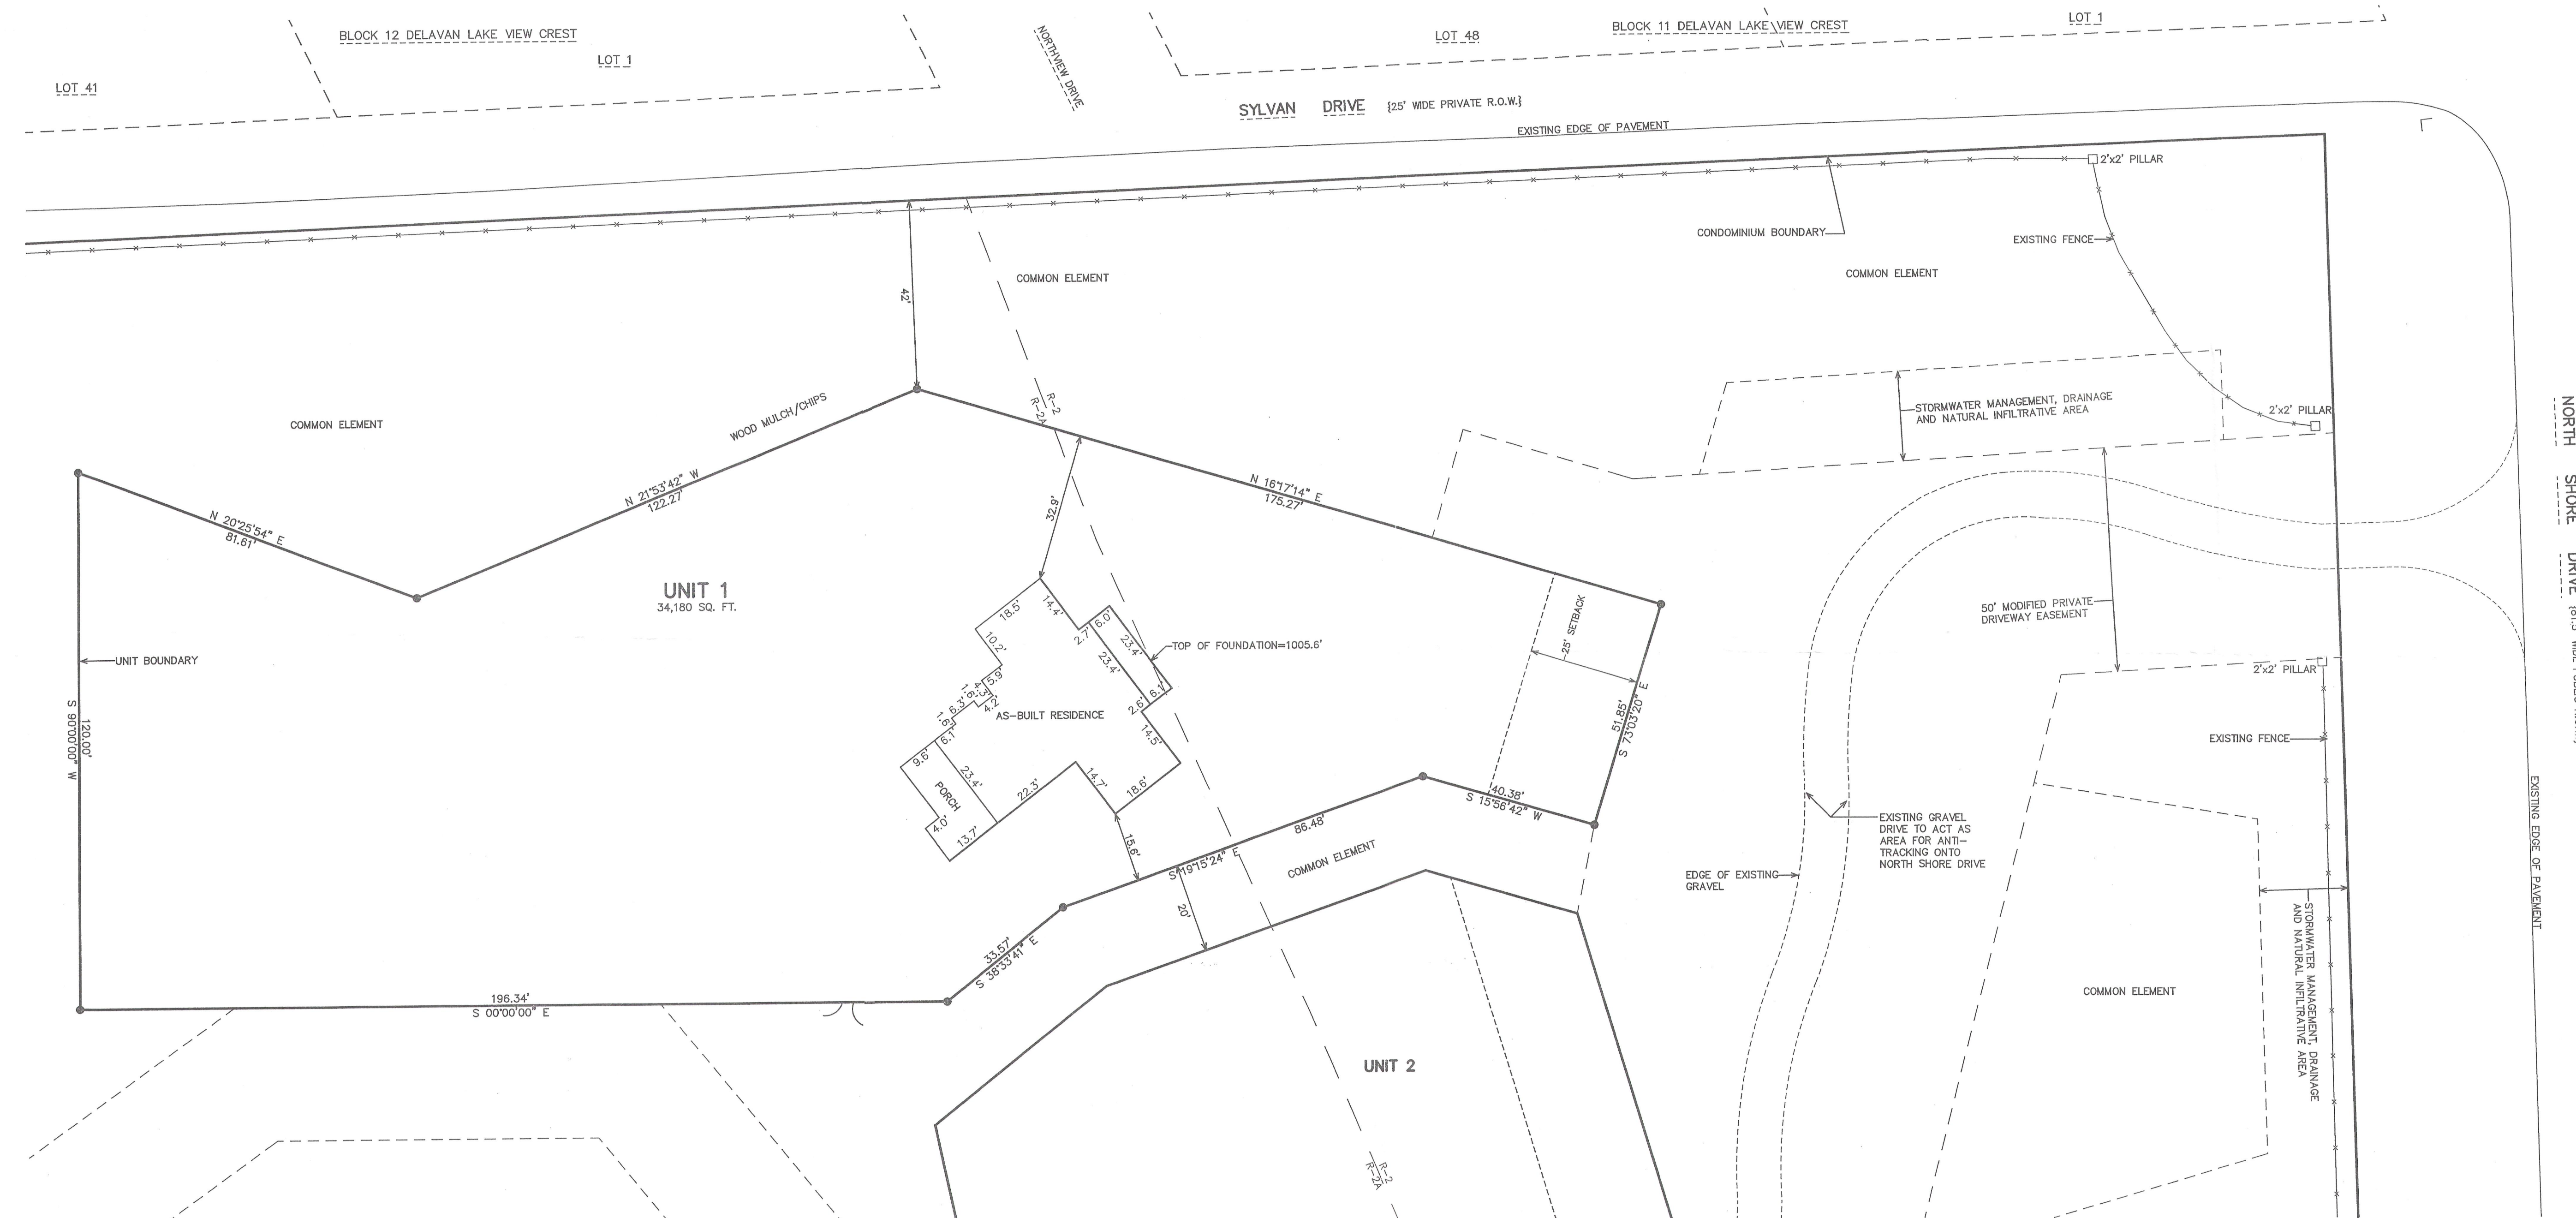

LEGEND
● = FOUND IRON REBAR STAKE
[xxx] = RECORDED AS

MAP SCALE IN FEET ORIGINAL 1" = 20'
10 5 0 10 20 30 40 50 60 70 80 90 100

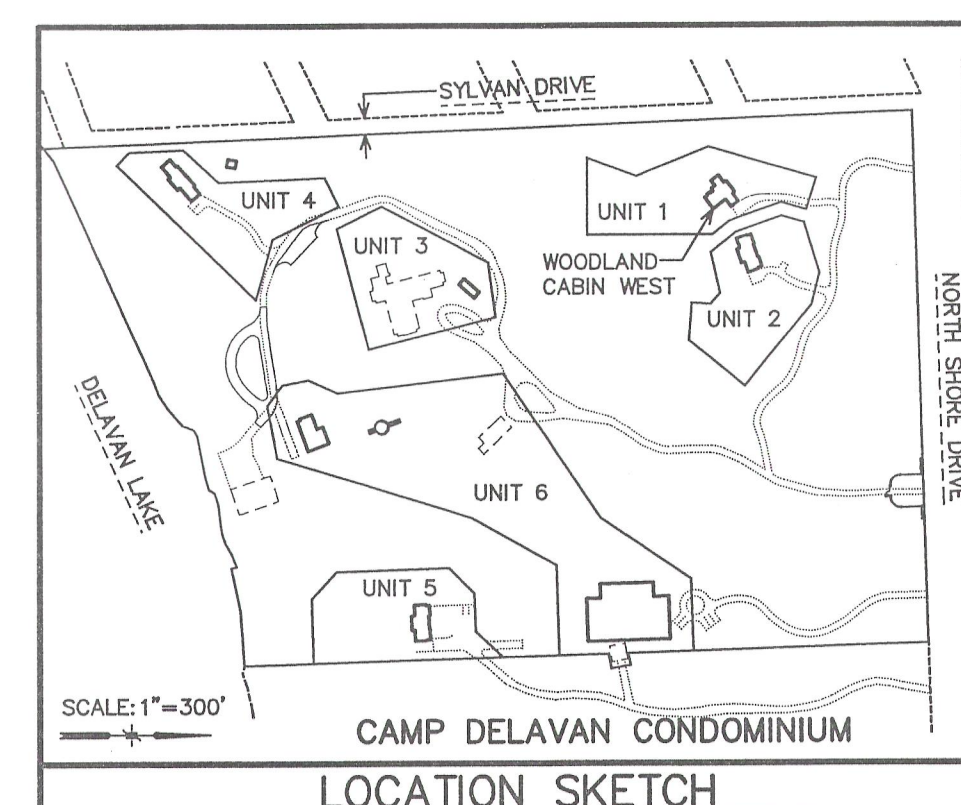

NOTE: COPIES OF THIS MAP TO WHICH THE FOLLOWING CERTIFICATE
WILL APPLY SHOW THE SURVEYOR'S ORIGINAL SEAL AND SIGNATURE
IN RED INK. COPIES BY ANY OTHER MEANS MAY HAVE ALTERATIONS
WHICH DO NOT REPRESENT THE SURVEYOR'S WORK PRODUCT.

I HEREBY CERTIFY THAT THE ABOVE DESCRIBED PROPERTY HAS BEEN
SURVEYED UNDER MY DIRECTION AND THAT THE ABOVE MAP IS A TRUE
REPRESENTATION THEREOF AND SHOWS THE SIZE AND LOCATION OF
THE PROPERTY AND ITS EXTERIOR BOUNDARIES. THIS SURVEY IS
MADE FOR THE USE OF THE PRESENT OWNERS OF THE PROPERTY, AND
ALSO THOSE WHO PURCHASE, MORTGAGE, OR GUARANTEE THE TITLE
THERE TO WITHIN ONE YEAR FROM THE DATE HEREOF.

DATED: FEBRUARY 22, 2010

PETER S. GORDON R.L.S. 2101

1/4/2011-KB
TO SHOW SIZE & LOCATION OF
AS-BUILT FOUNDATION

FCAMP-1

216-5923