


AS-BUILT MAPPING
UNIT 2 - CAMP DELAVAN CONDOMINIUM
A REDIVISION OF LOTS 1, 2, 3, 4, 5, 6, & 7 OF WESTWARD STAR WOODS AND LOT 1 & PART OF LOT 2
OF ARNOLDS WOODS SUBDIVISION BEING PART OF GOVERNMENT LOT 1 LOCATED IN THE NW 1/4, NE 1/4,
& SE 1/4 OF THE NE 1/4 OF FRACTIONAL SECTION 31, TOWN 2 NORTH, RANGE 16 EAST, WALWORTH COUNTY, WISCONSIN
WOODLAND CABIN EAST

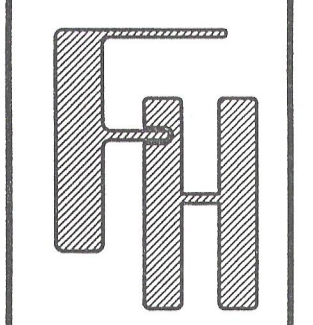



WOODLAND CABIN EAST
CAMP DELAVAN CONDOMINIUM
TOWN OF DELAVAN, WALWORTH COUNTY, WISCONSIN

WORK ORDERED BY -
ALEC & JENNIFER LITOWITZ
610 LONGWOOD AVENUE
GLENCOE, IL 60022

FARRIS, HANSEN & ASSOCIATES, INC.
ENGINEERING - ARCHITECTURE - SURVEYING
7 RIDGWAY COURT P.O. BOX 437
ELKHORN, WISCONSIN 53121
OFFICE: (262) 723-2098 FAX: (262) 723-5886

REVISIONS
4/5/2010-KB SITE, GRADING, DRAINAGE & EROSION CONTROL PLAN
11/16/2010-KB ADJUST PROPOSED BUILDING LOCATION
3/3/2011-KB UPDATE FOR PERMIT
10/14/2011-KB UPDATE FOR CONSTR.
10/19/2011-KB REVISE BLDG. LOCATION

PROJECT NO. 5765.CONDO
DATE 2/22/2010
SHEET NO. 1 OF 1

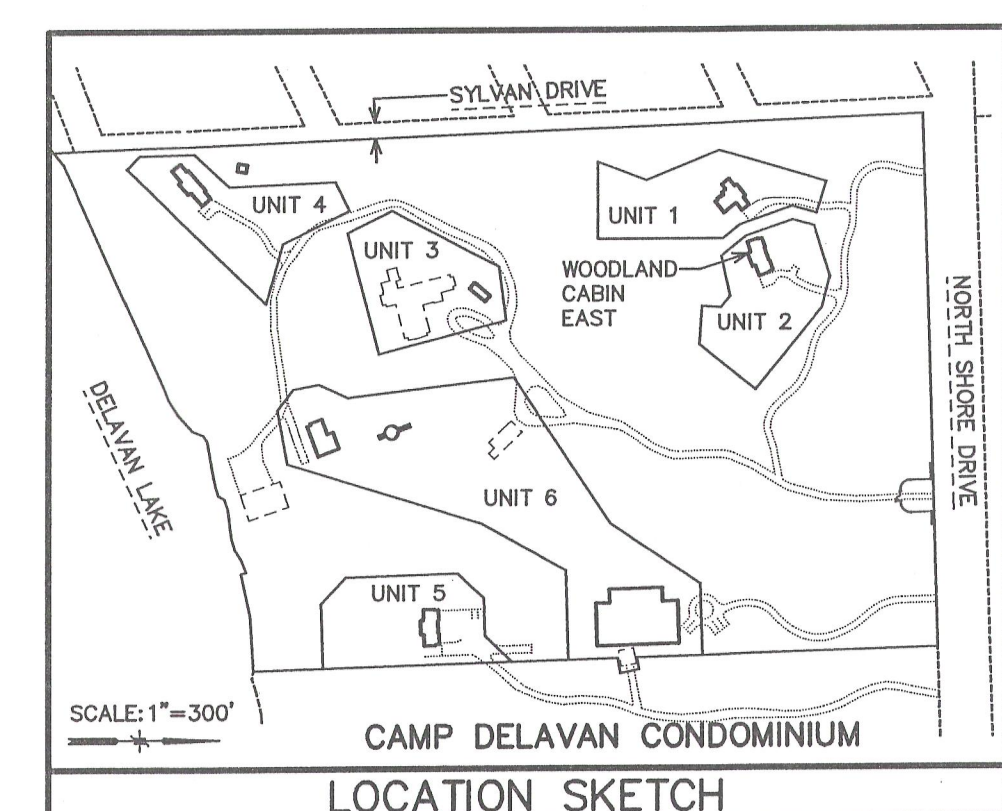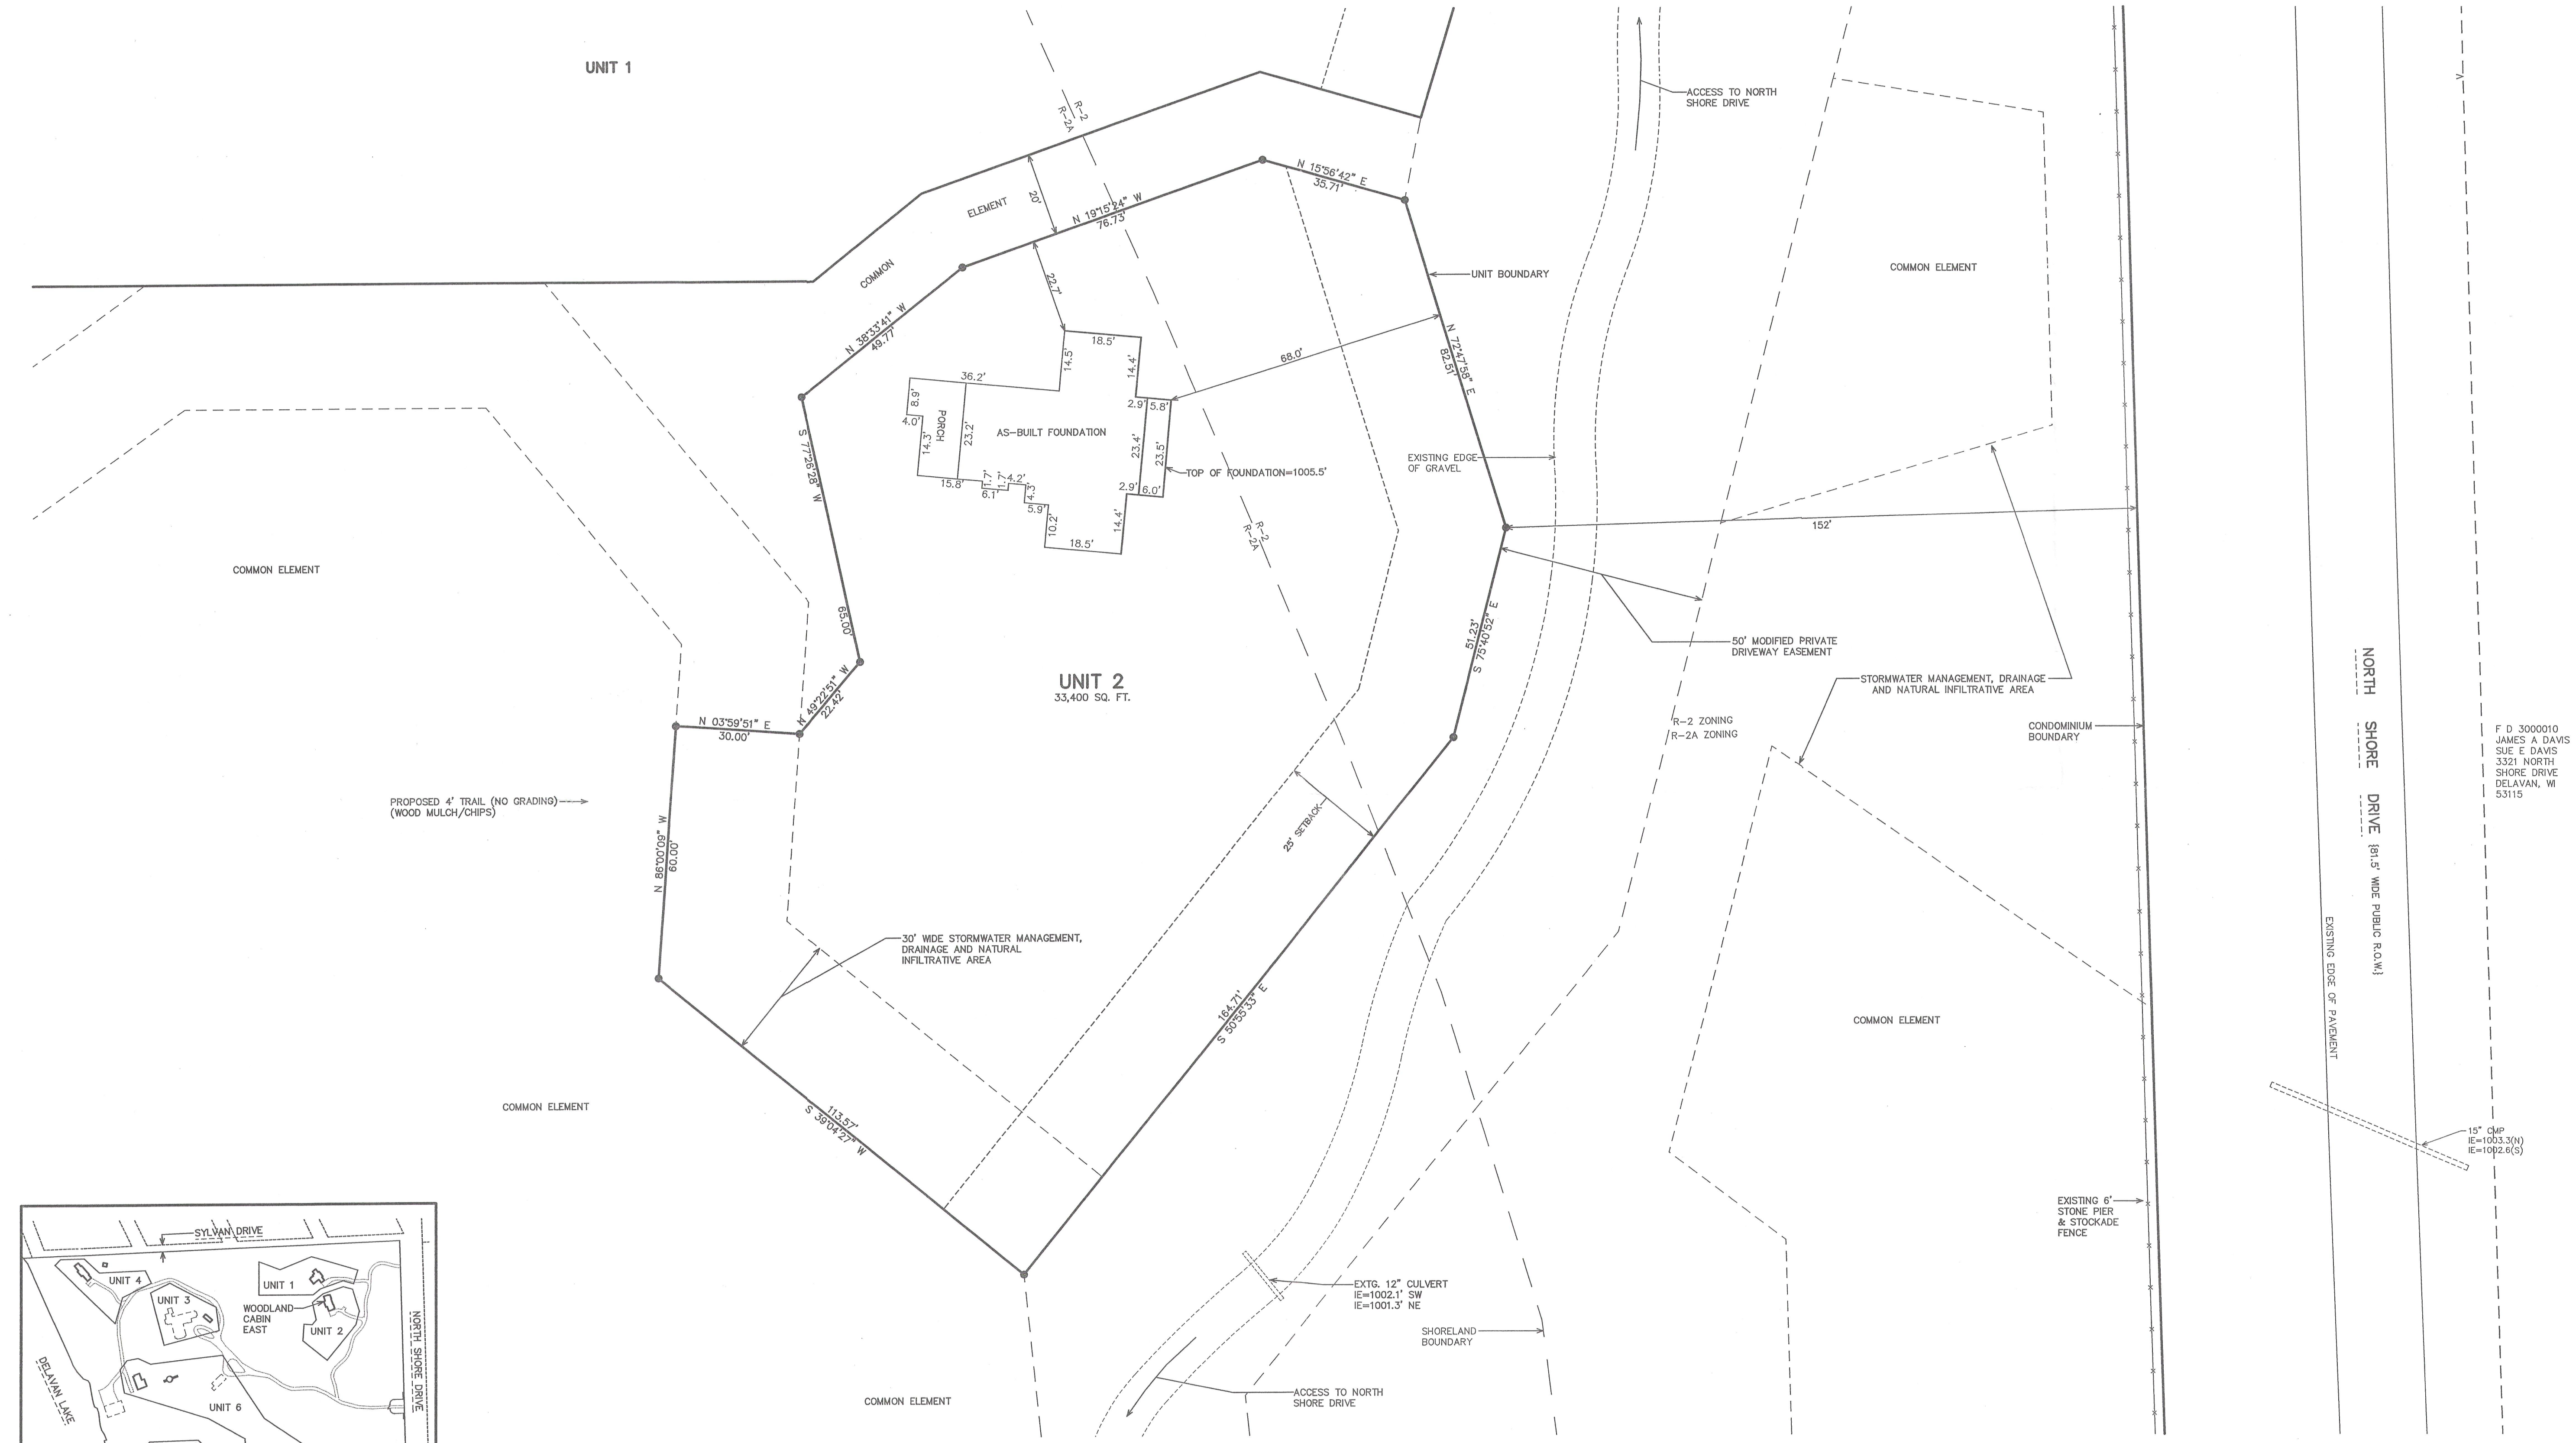

NOTE: AREAS OF 1' CONTOURS FROM FIELD TOPOGRAPHY
OF PORTIONS OF THE SITE. AREAS OF 2' CONTOURS
TAKEN FROM WALWORTH COUNTY AERIAL MAPPING
AND ARE FOR REFERENCE ONLY.

MAP SCALE IN FEET ORIGINAL 1" = 20'

NOTE: COPIES OF THIS MAP TO WHICH THE FOLLOWING CERTIFICATE
WILL APPLY SHOW THE SURVEYOR'S ORIGINAL SEAL AND SIGNATURE
IN RED INK. COPIES BY ANY OTHER MEANS MAY HAVE ALTERATIONS
WHICH DO NOT REPRESENT THE SURVEYOR'S WORK PRODUCT.

I HEREBY CERTIFY THAT THE ABOVE DESCRIBED PROPERTY HAS BEEN
SURVEYED UNDER MY DIRECTION AND THAT THE ABOVE MAP IS A TRUE
REPRESENTATION THEREOF AND SHOWS THE SIZE AND LOCATION OF
THE PROPERTY AND ITS EXTERIOR BOUNDARIES. THIS SURVEY IS
MADE FOR THE USE OF THE PRESENT OWNERS OF THE PROPERTY, AND
ALSO THOSE WHO PURCHASE, MORTGAGE, OR GUARANTEE THE TITLE
THERE TO WITHIN ONE YEAR FROM THE DATE HEREOF.

DATE: FEBRUARY 22, 2010
PETER S. GORDON R.L.S. 2101

1/4/2012-KB
TO SHOW SIZE & LOCATION OF
AS-BUILT FOUNDATION



216 4984

1/4/2012 X:\Projects\5765.CONDO\DCAD\ENGINEERING\UNIT_2\ASBLT_201004

216 4984

FCAMP-2