


GEORGE T. DUNHAM
SURVEYING & SUBDIVIDING
DELAVAN, WISCONSIN

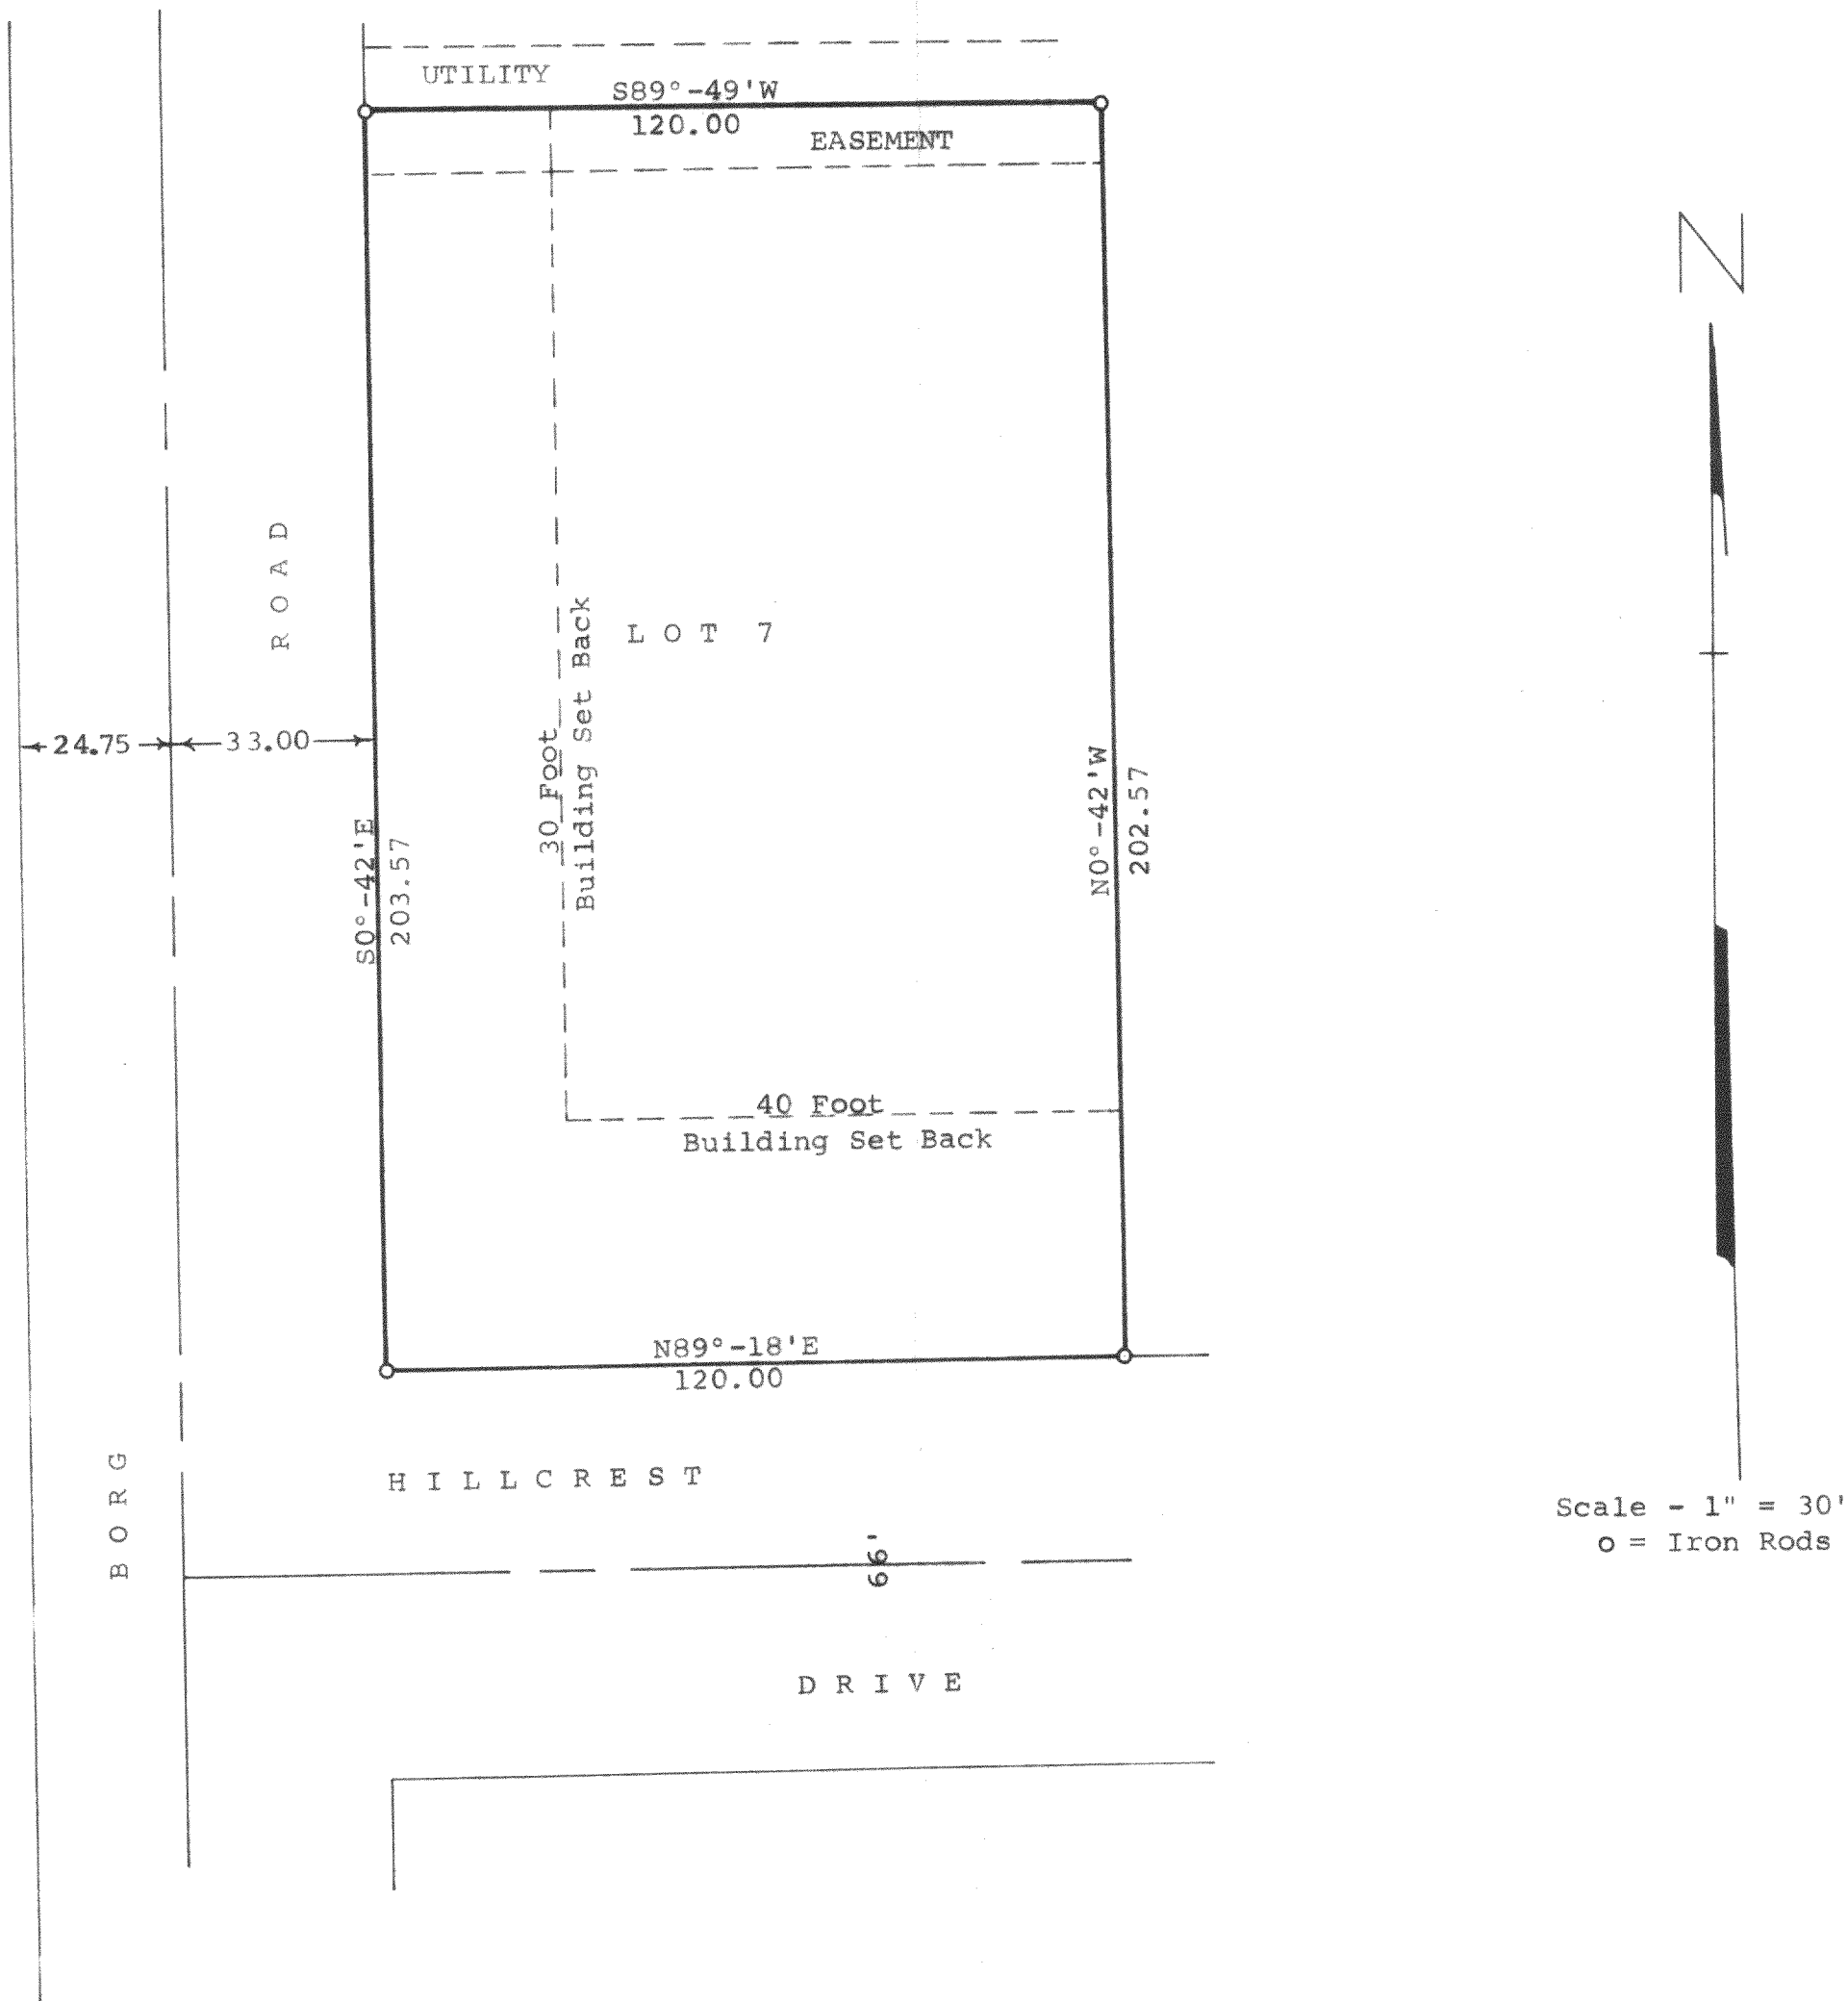

STATE OF WISCONSIN)
COUNTY OF WALWORTH) SS

I, George T. Dunham, Surveyor, certify that I have surveyed the property described as follows,

Lot 7 of Oak Meadow Subdivision, a subdivision located in the Northeast ¼ of Section 29, T 2 N, R 16 E, Walworth County, Wisconsin,

and that the above map is a true representation thereof and shows the size and location of the property, its exterior boundaries, and that there are no visible encroachments.

November 5, 1974

George T. Dunham
George T. Dunham, Surveyor

