


HAROLD H. KOLB

REGISTERED PROFESSIONAL LAND SURVEYOR
LAKE GENEVA, WISCONSIN

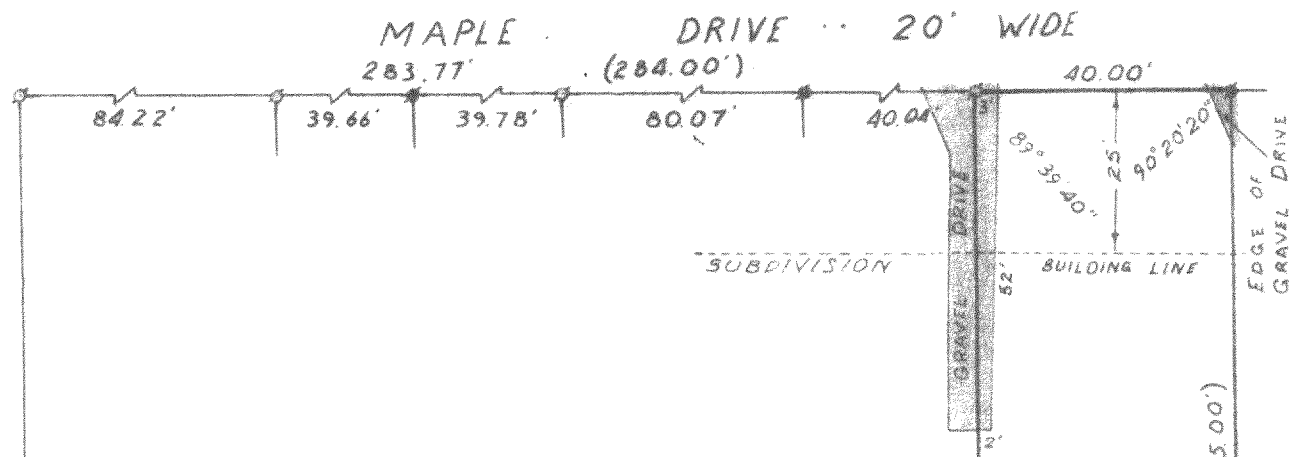

PLAT OF SURVEY OF

Lot 35, Krumhaar's Addition to
Ravenswood, Section 31, T 2 N, 36
R 16 E, Walworth County, Wisconsin

OWNER: E. Currie

Area and Distance $\pm .01$
Angles $\pm 25''$

Error of Closure less than 1/3000


N



SCALE: 1" = 30'

LEGEND

- φ — IRON PIPE FOUND
- — IRON PIPE PLACED
- — CONCRETE MONUMENT
- x — SPIKE
- — FOUND IRON ROD
- () — AS PLATTED

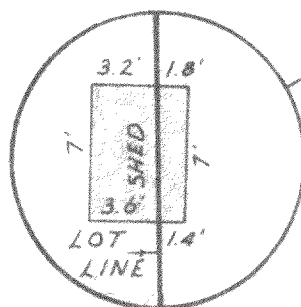


SCALE: 1" = 10'

I, HAROLD H. KOLB, DO HEREBY CERTIFY THAT I HAVE
SURVEYED THE PROPERTY HEREON DESCRIBED ACCORDING
TO THE OFFICIAL RECORDS, AND THAT THE PLAT HEREON
IS A CORRECT REPRESENTATION OF THE LOT LINES.

Harold H. Kolb

HAROLD H. KOLB
WISCONSIN REGISTERED LAND SURVEYOR, S-187
DATE Sept. 16, 1974

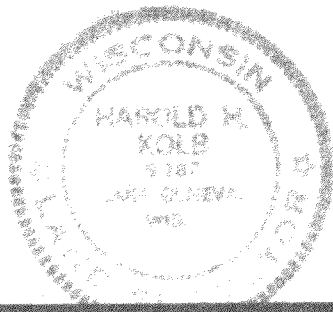

FRA-32

216-495