


PLAT OF SURVEY


PART OF GOVERNMENT LOT 3 IN THE FRACT. SW 1/4
SECTION 27, TOWN 2 NORTH, RANGE 16 EAST
WALWORTH COUNTY, WISCONSIN

Lot 8 in the Plat of Lake View, and other lands located in the Southeast 1/4 of Section 27, T2N, R16E, in the Town of Delavan, County of Walworth, State of Wisconsin, described as follows: Beginning at a stake at the Southeast corner of Lot 7 in the Plat of Lake View, which plat is on record in the office of the Register of Deeds for said Walworth County, in Volume 4 of Plats on page 37, thence Northwesterly along the most Southerly line of said Lot 7, 313 feet more or less to low water line of Delavan Lake, thence Southerly along low water line of said lake to a point, thence Southeasterly 23 feet more or less to a stake being on a line of the base line of the above mentioned plat and 50 feet from a stake on said line on the most Southerly side of said Lot 7, and producing or extending said line Southeasterly 285.7 feet to a stake being in line with the Southeasterly line of said plat and 65 feet from the Southeast corner of said Lot 7, and 35.5 feet more to a stake in the center of one certain road 10.8 feet Northerly from an angle stake in said road, thence Northeasterly along the center of said road 68.2 feet to a stake 2.5 feet Southerly from an angle stake in said road, thence Northwesterly 25.4 feet to the place of beginning.

Tax Key No. FLAP 00005A

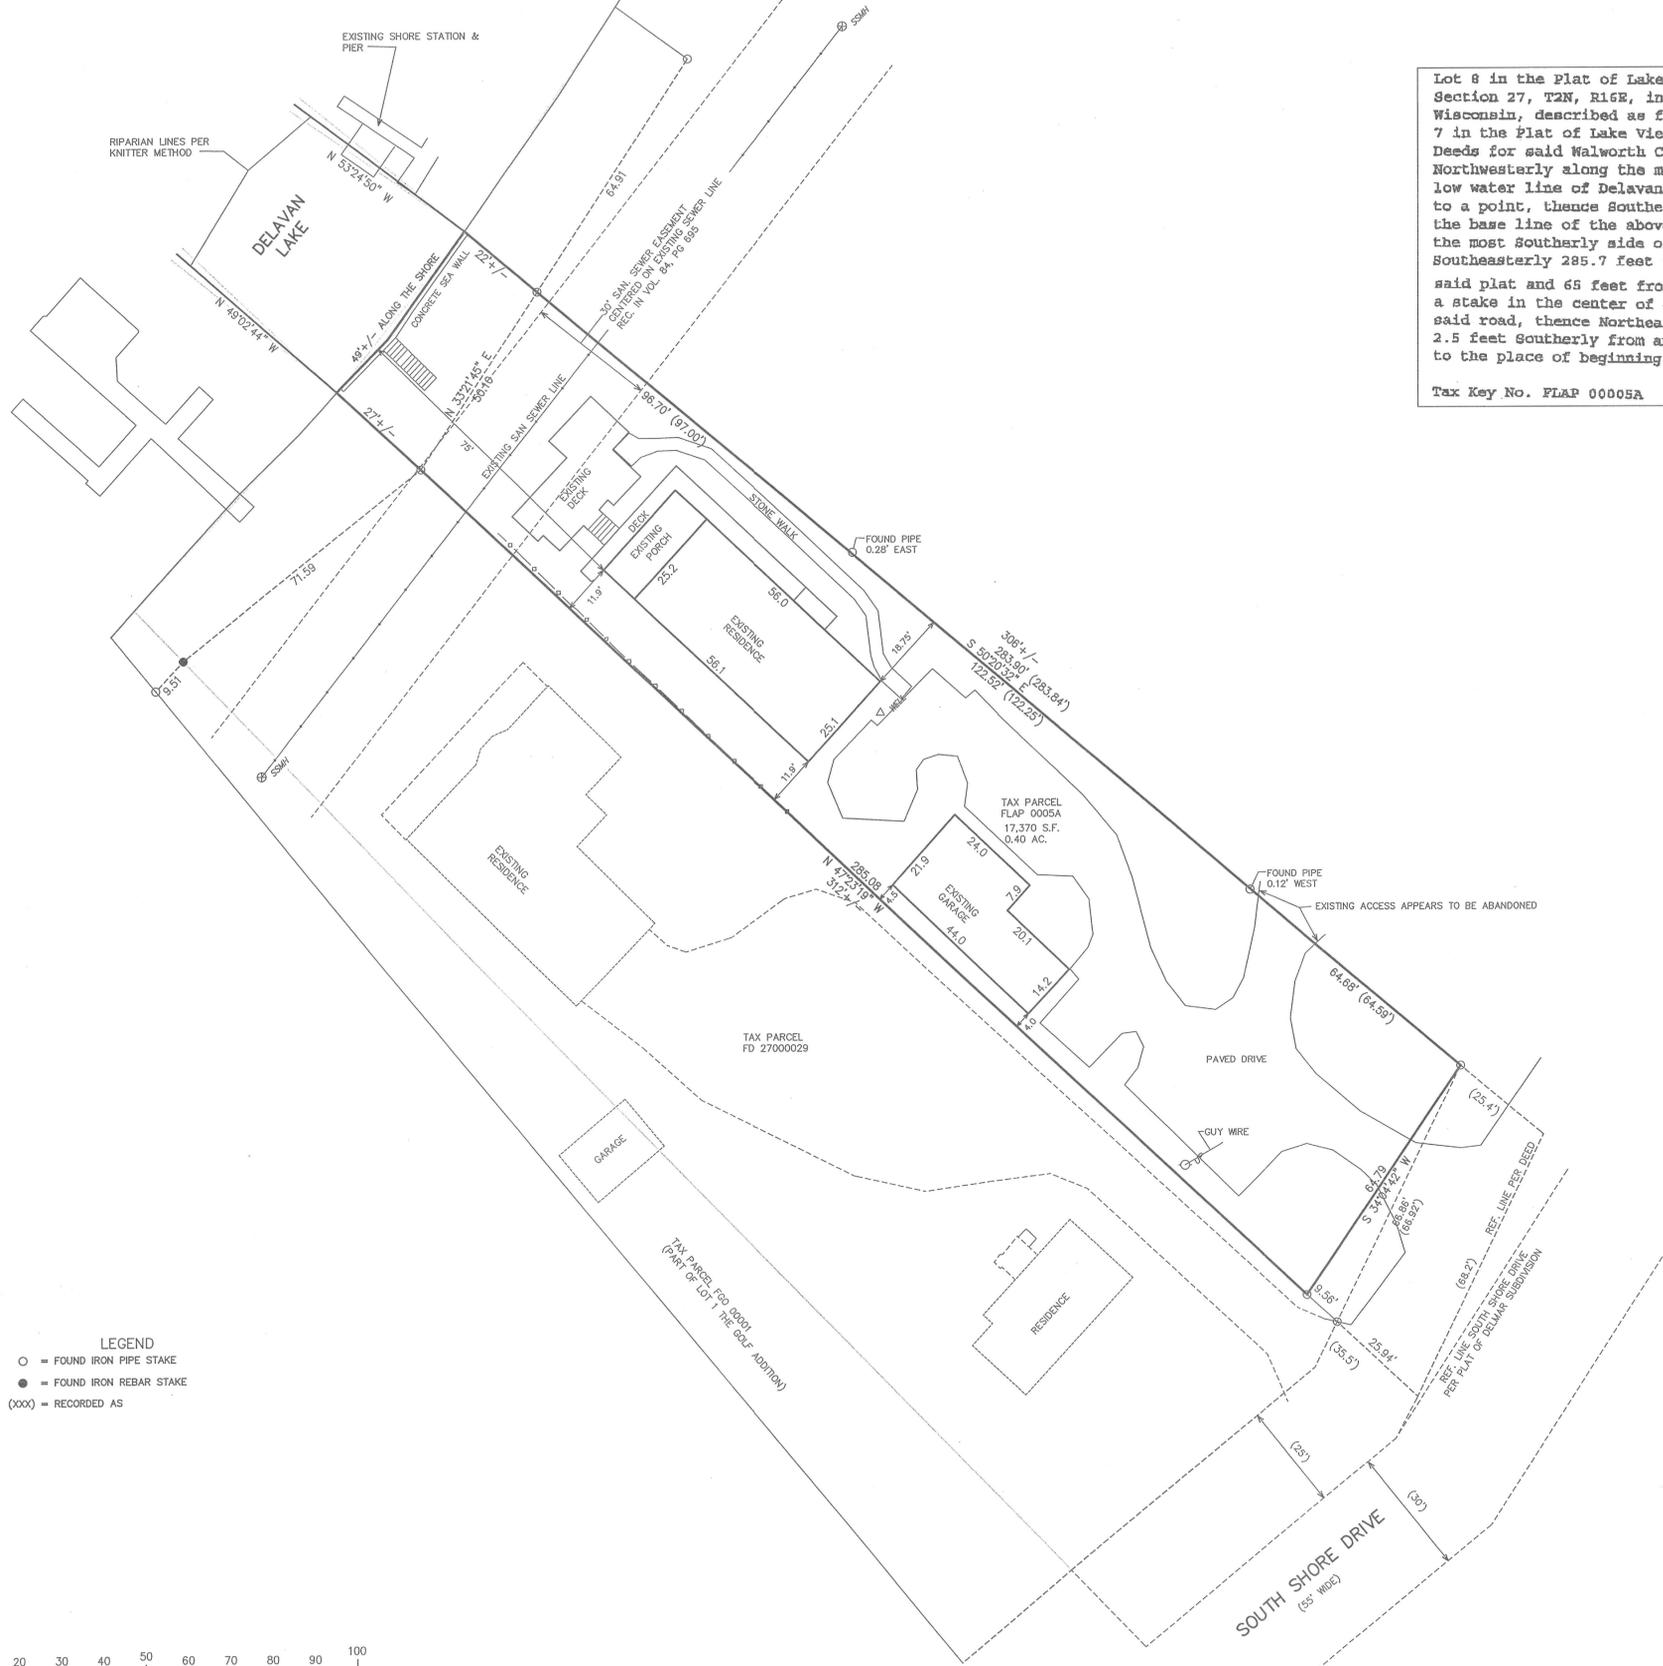

- LEGEND**
- = FOUND IRON PIPE STAKE
 - = FOUND IRON REBAR STAKE
 - (XXX) = RECORDED AS

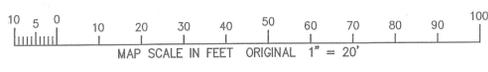

NOTE: COPIES OF THIS MAP TO WHICH THE FOLLOWING CERTIFICATE WILL APPLY SHOW THE SURVEYOR'S ORIGINAL SEAL AND SIGNATURE IN RED INK. COPIES BY ANY OTHER MEANS MAY HAVE ALTERATIONS WHICH DO NOT REPRESENT THE SURVEYOR'S WORK PRODUCT.

I HEREBY CERTIFY THAT THE ABOVE DESCRIBED PROPERTY HAS BEEN SURVEYED UNDER MY DIRECTION AND THAT THE ABOVE MAP IS A TRUE REPRESENTATION THEREOF AND SHOWS THE SIZE AND LOCATION OF THE PROPERTY AND ITS EXTERIOR BOUNDARIES. THIS SURVEY IS MADE FOR THE USE OF THE PRESENT OWNERS OF THE PROPERTY, AND ALSO THOSE WHO PURCHASE, MORTGAGE, OR GUARANTEE THE TITLE THERETO WITHIN ONE YEAR FROM THE DATE HEREOF.

DATED: JULY 19, 2012

Peter S. Gordon
PETER S. GORDON R.L.S. 2101



WORK ORDERED BY:
RAYMOND HOTT
15 SYLVAN LANE
DEKALB, IL. 60115

FARRIS, HANSEN & ASSOCIATES, INC.
ENGINEERING - ARCHITECTURE - SURVEYING
7 RIDGWAY COURT P.O. BOX 437
ELKHORN, WISCONSIN 53121
OFFICE: (262) 723-2098 FAX: (262) 723-5866

REVISIONS

PROJECT NO.	8613
DATE	07-19-2012
SHEET NO.	1 OF 1

JUL 19 2012

FLAP-5A

216-4953