


PLAT OF SURVEY
-OF-

LOTS 1 AND 2 OF CERTIFIED SURVEY MAP NO. 1336, RECORDED IN THE OFFICE OF THE REGISTER OF DEEDS FOR WALWORTH COUNTY, WISCONSIN, ON JANUARY 3, 1984, IN VOLUME 6, PAGE 160, AS DOCUMENT NO. 98199, BEING A PART OF LOTS 11 AND 13 AND ALL OF LOT 12, BARNES AND VON SUESSMILCH SUBDIVISION IN SECTION 33, TOWN 2 NORTH, RANGE 16 EAST. SAID LAND BEING IN THE TOWN OF DELAVAN, COUNTY OF WALWORTH, STATE OF WISCONSIN.


SURVEY FOR: CHRISTOPHER PHILLIPS

SURVEY ADDRESS: 3485 SOUTH SHORE DRIVE, DELAVAN, WI 53115

TAX KEY NUMBERS: FA133600001 AND FA133600002

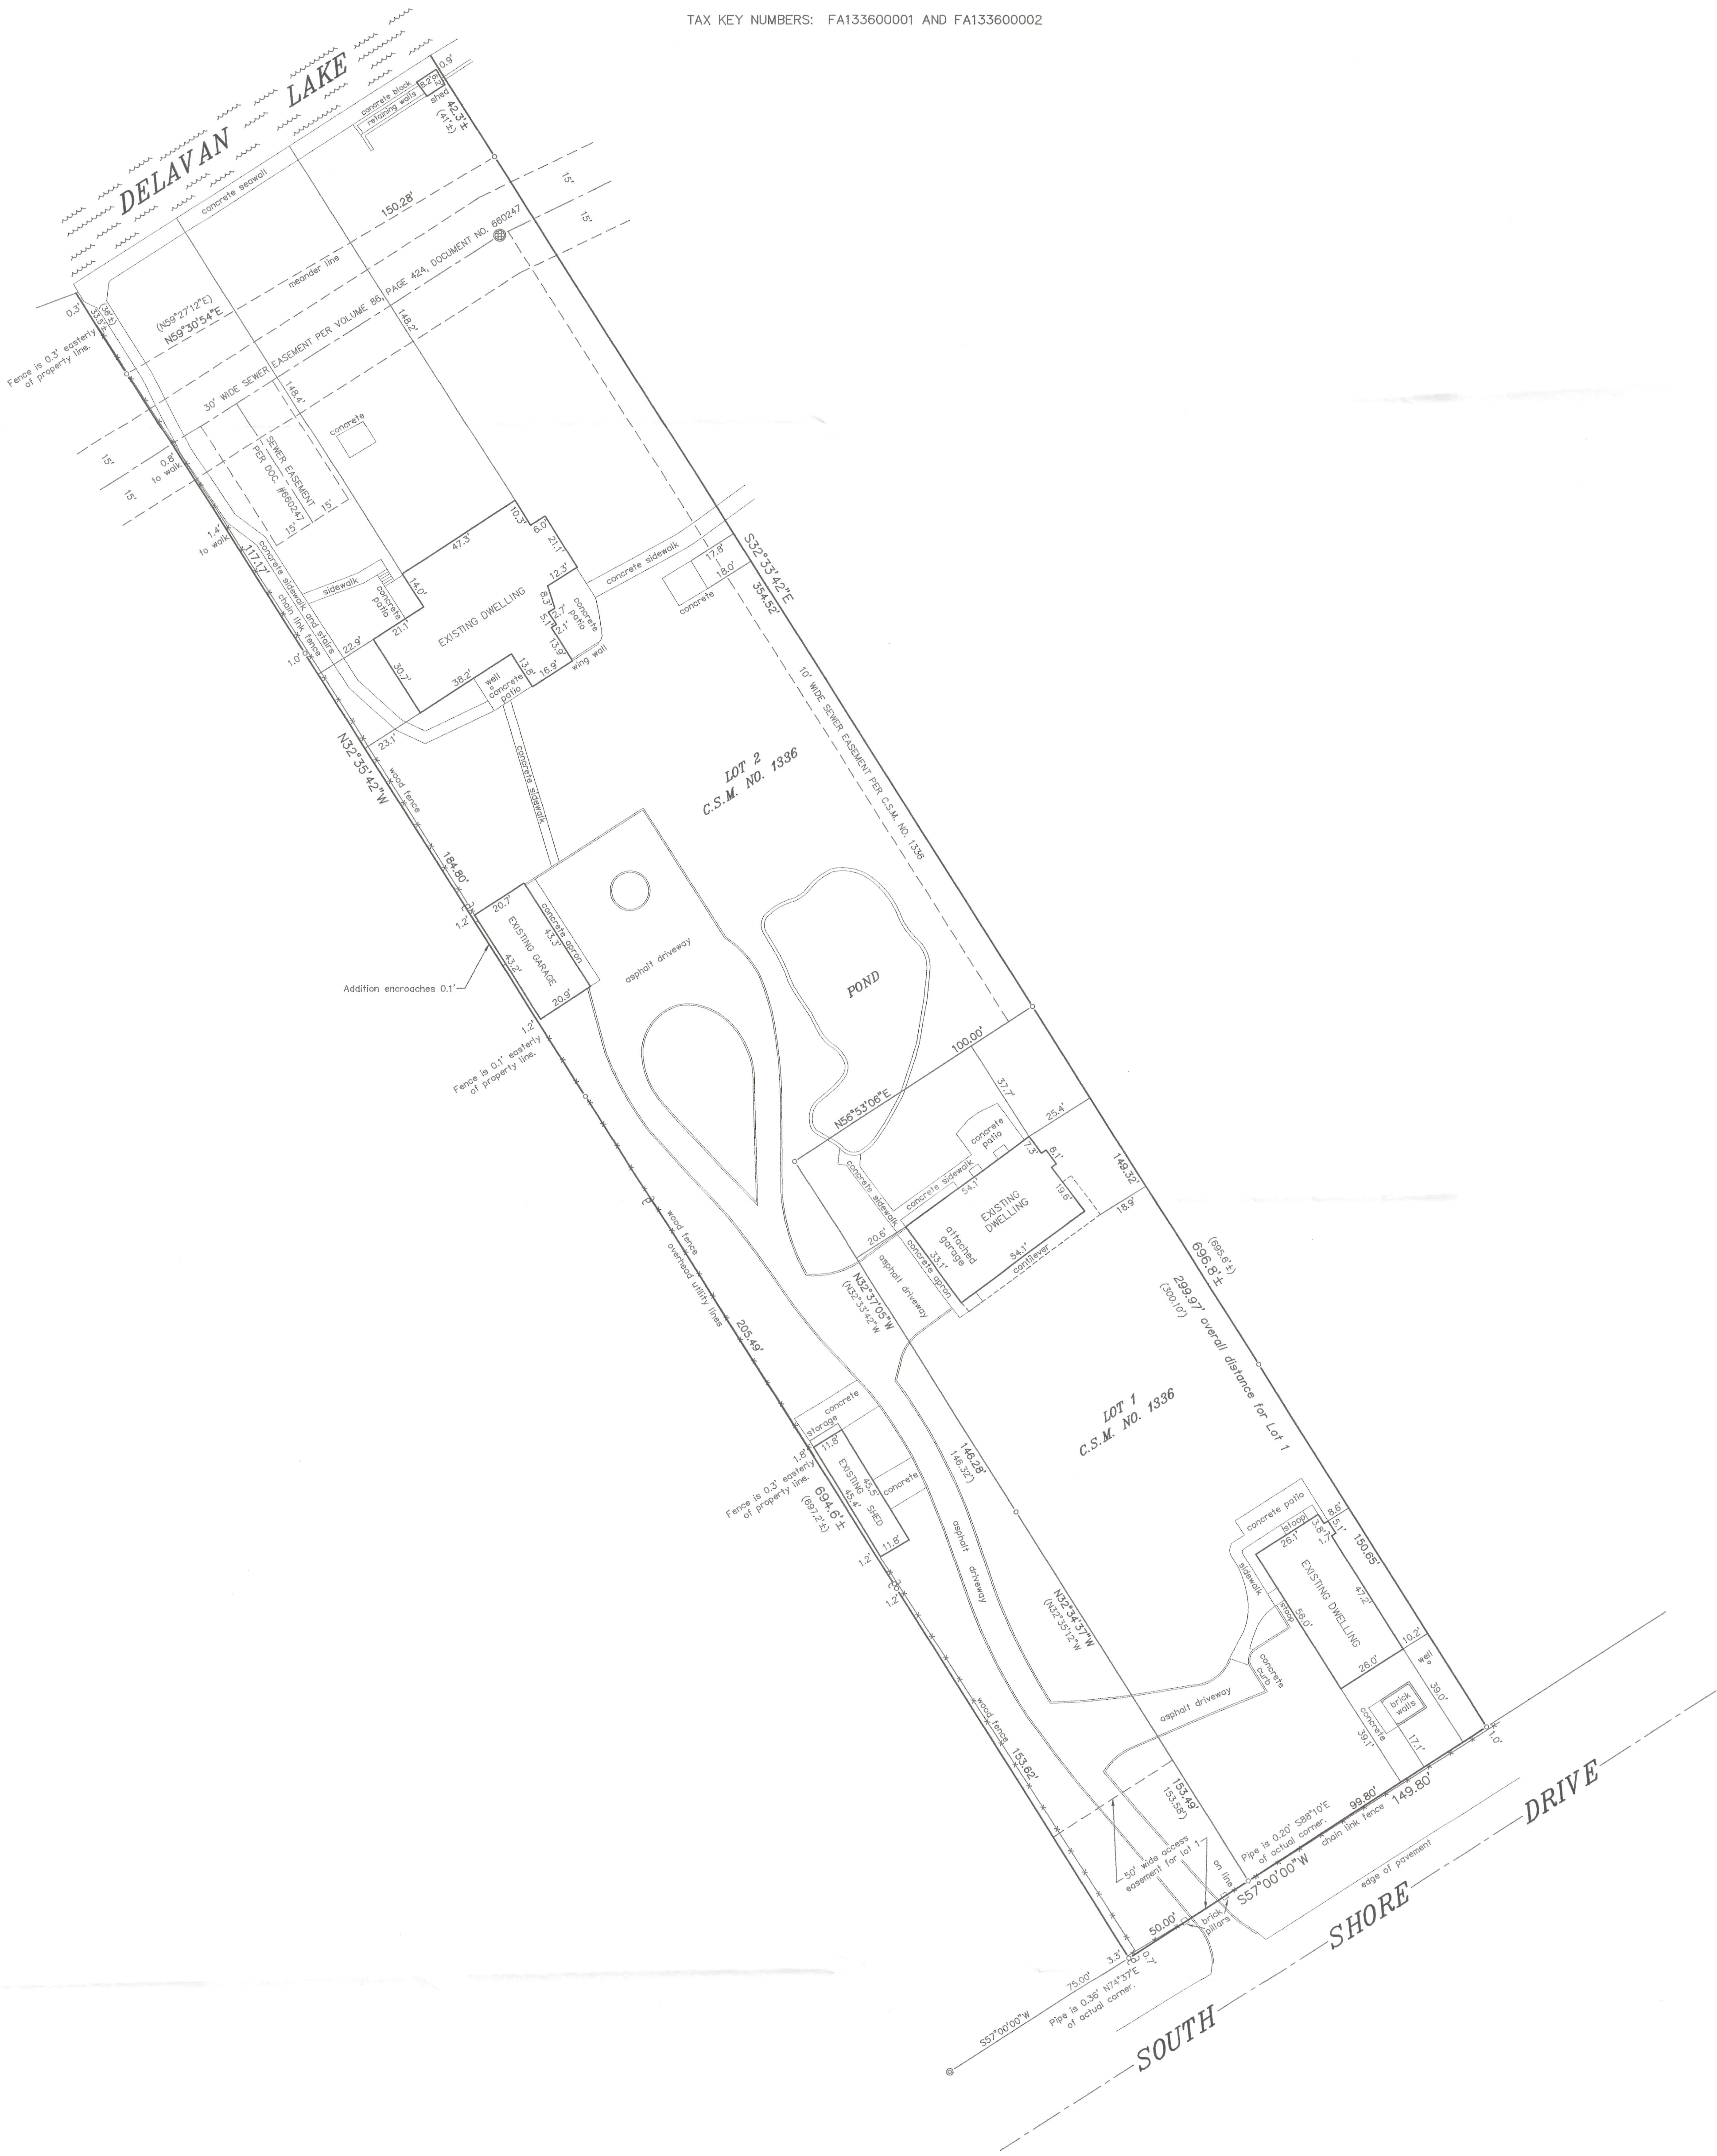

BEARINGS HEREON RELATE TO THE EASTERLY LINE
OF CERTIFIED SURVEY MAP NO. 1336, ASSUMED
BEARING OF SOUTH 32°33'42" EAST AS PLATTED.

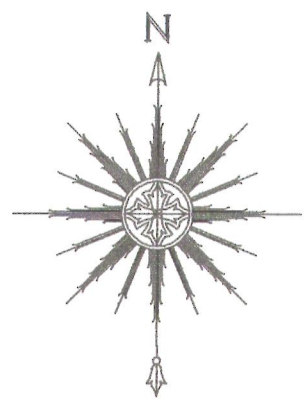

0 15' 30' 60'
SCALE: 1" = 30'

"I HEREBY CERTIFY THAT I HAVE SURVEYED THE ABOVE
DESCRIBED PROPERTY AND THAT THE ABOVE MAP IS A
CORRECT REPRESENTATION THEREOF AND SHOWS THE
SIZE AND LOCATION OF THE PROPERTY, ITS EXTERIOR
BOUNDARIES, THE LOCATION OF ALL VISIBLE STRUCTURES
AND DIMENSIONS OF ALL PRINCIPAL BUILDINGS THEREON,
BOUNDARY FENCES, APPARENT EASEMENTS, ROADWAYS
AND ENCROACHMENTS, IF ANY."



"THIS SURVEY IS MADE FOR THE USE OF THE PRESENT
OWNERS OF THE PROPERTY, AND THOSE WHO PURCHASE,
MORTGAGE, OR GUARANTEE THE TITLE THERETO WITHIN
ONE YEAR FROM DATE HEREOF."

SATTER SURVEYING, LLC

LAND SURVEYS, MAPPING AND PLANNING
272 ORIGIN STREET
BURLINGTON, WI 53105
262-661-4239

LEGEND

- FOUND CONCRETE MONUMENT
- FOUND IRON PIPE
- ≡ UTILITY POLE
- ⊕ MANHOLE
- () RECORDED AS

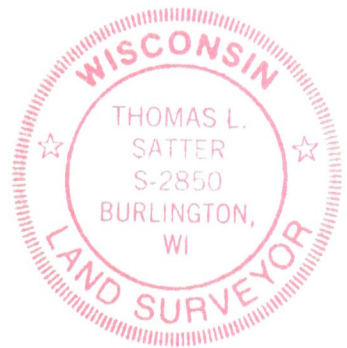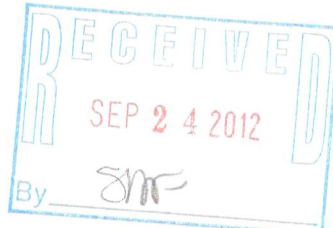

THIS IS NOT AN ORIGINAL PRINT
UNLESS THIS SEAL IS RED.

Thomas L. Satter
THOMAS L. SATTER S-2850

AUGUST 29, 2012 081208
DATE JOB NUMBER